

23.6.15
30.7.15

S.S. "SCHIELAND"
No 498 MIDSHIP SECTION.


SCANTLINGS TO	MAINDECK.	RAISED QUARTERDECK.
BREADTH	39.83	39.83
DEPTH	20.75	25.00
TRANSVERSE NUMBER	60.58	64.33
LENGTH 272.00		
LONGITUDINAL NUMBER	16477.76	17623.76
DEPTH MOULDED	20' 9"	25' 0"
HEIGHT OF DOUBLE BOTTOM	3' 3"	3' 3"
DEPTH OF HOLD	17' 6"	21' 9"
LENGTH TO DEPTH	13.11	10.88
$L \times (B+D) =$	16477.76	
RAISED QUARTERDECK	84.21 x 4.25	357.89
POOP & FORECASTLE	(69.25 x 7.15 + 24.64 x 7.00) 0.75	505.39
DECK REJECTIONS	(58.75 x 7.25 + 11.75 x 10.00) 0.50	271.72
EQUIPMENT NUMBER		17612.76 = LETTER Y.

SCALE 1 TO 20.

LLOYD'S +100A1 OF STEEL.

LENGTH BETWEEN PERPENDICULARS	272' 0"	82.905 Metres.
BREADTH ON FRAME	39' 10"	12.141 "
DEPTH MOULDED TO MAINDECK	20' 9"	6.325 "
HEIGHT OF RAISED QUARTERDECK	4' 3"	1.295 "
HEIGHT OF POOP	7' 3"	2.210 "
HEIGHT OF FORECASTLE	7' 0"	2.134 "
HEIGHT OF DOUBLE BOTTOM [3" ABOVE RULE]	3' 3"	0.991 "


WERF GUSTO
FIRMA A. F. SMULDERS
SCHIEDAM (ROTTERDAM)

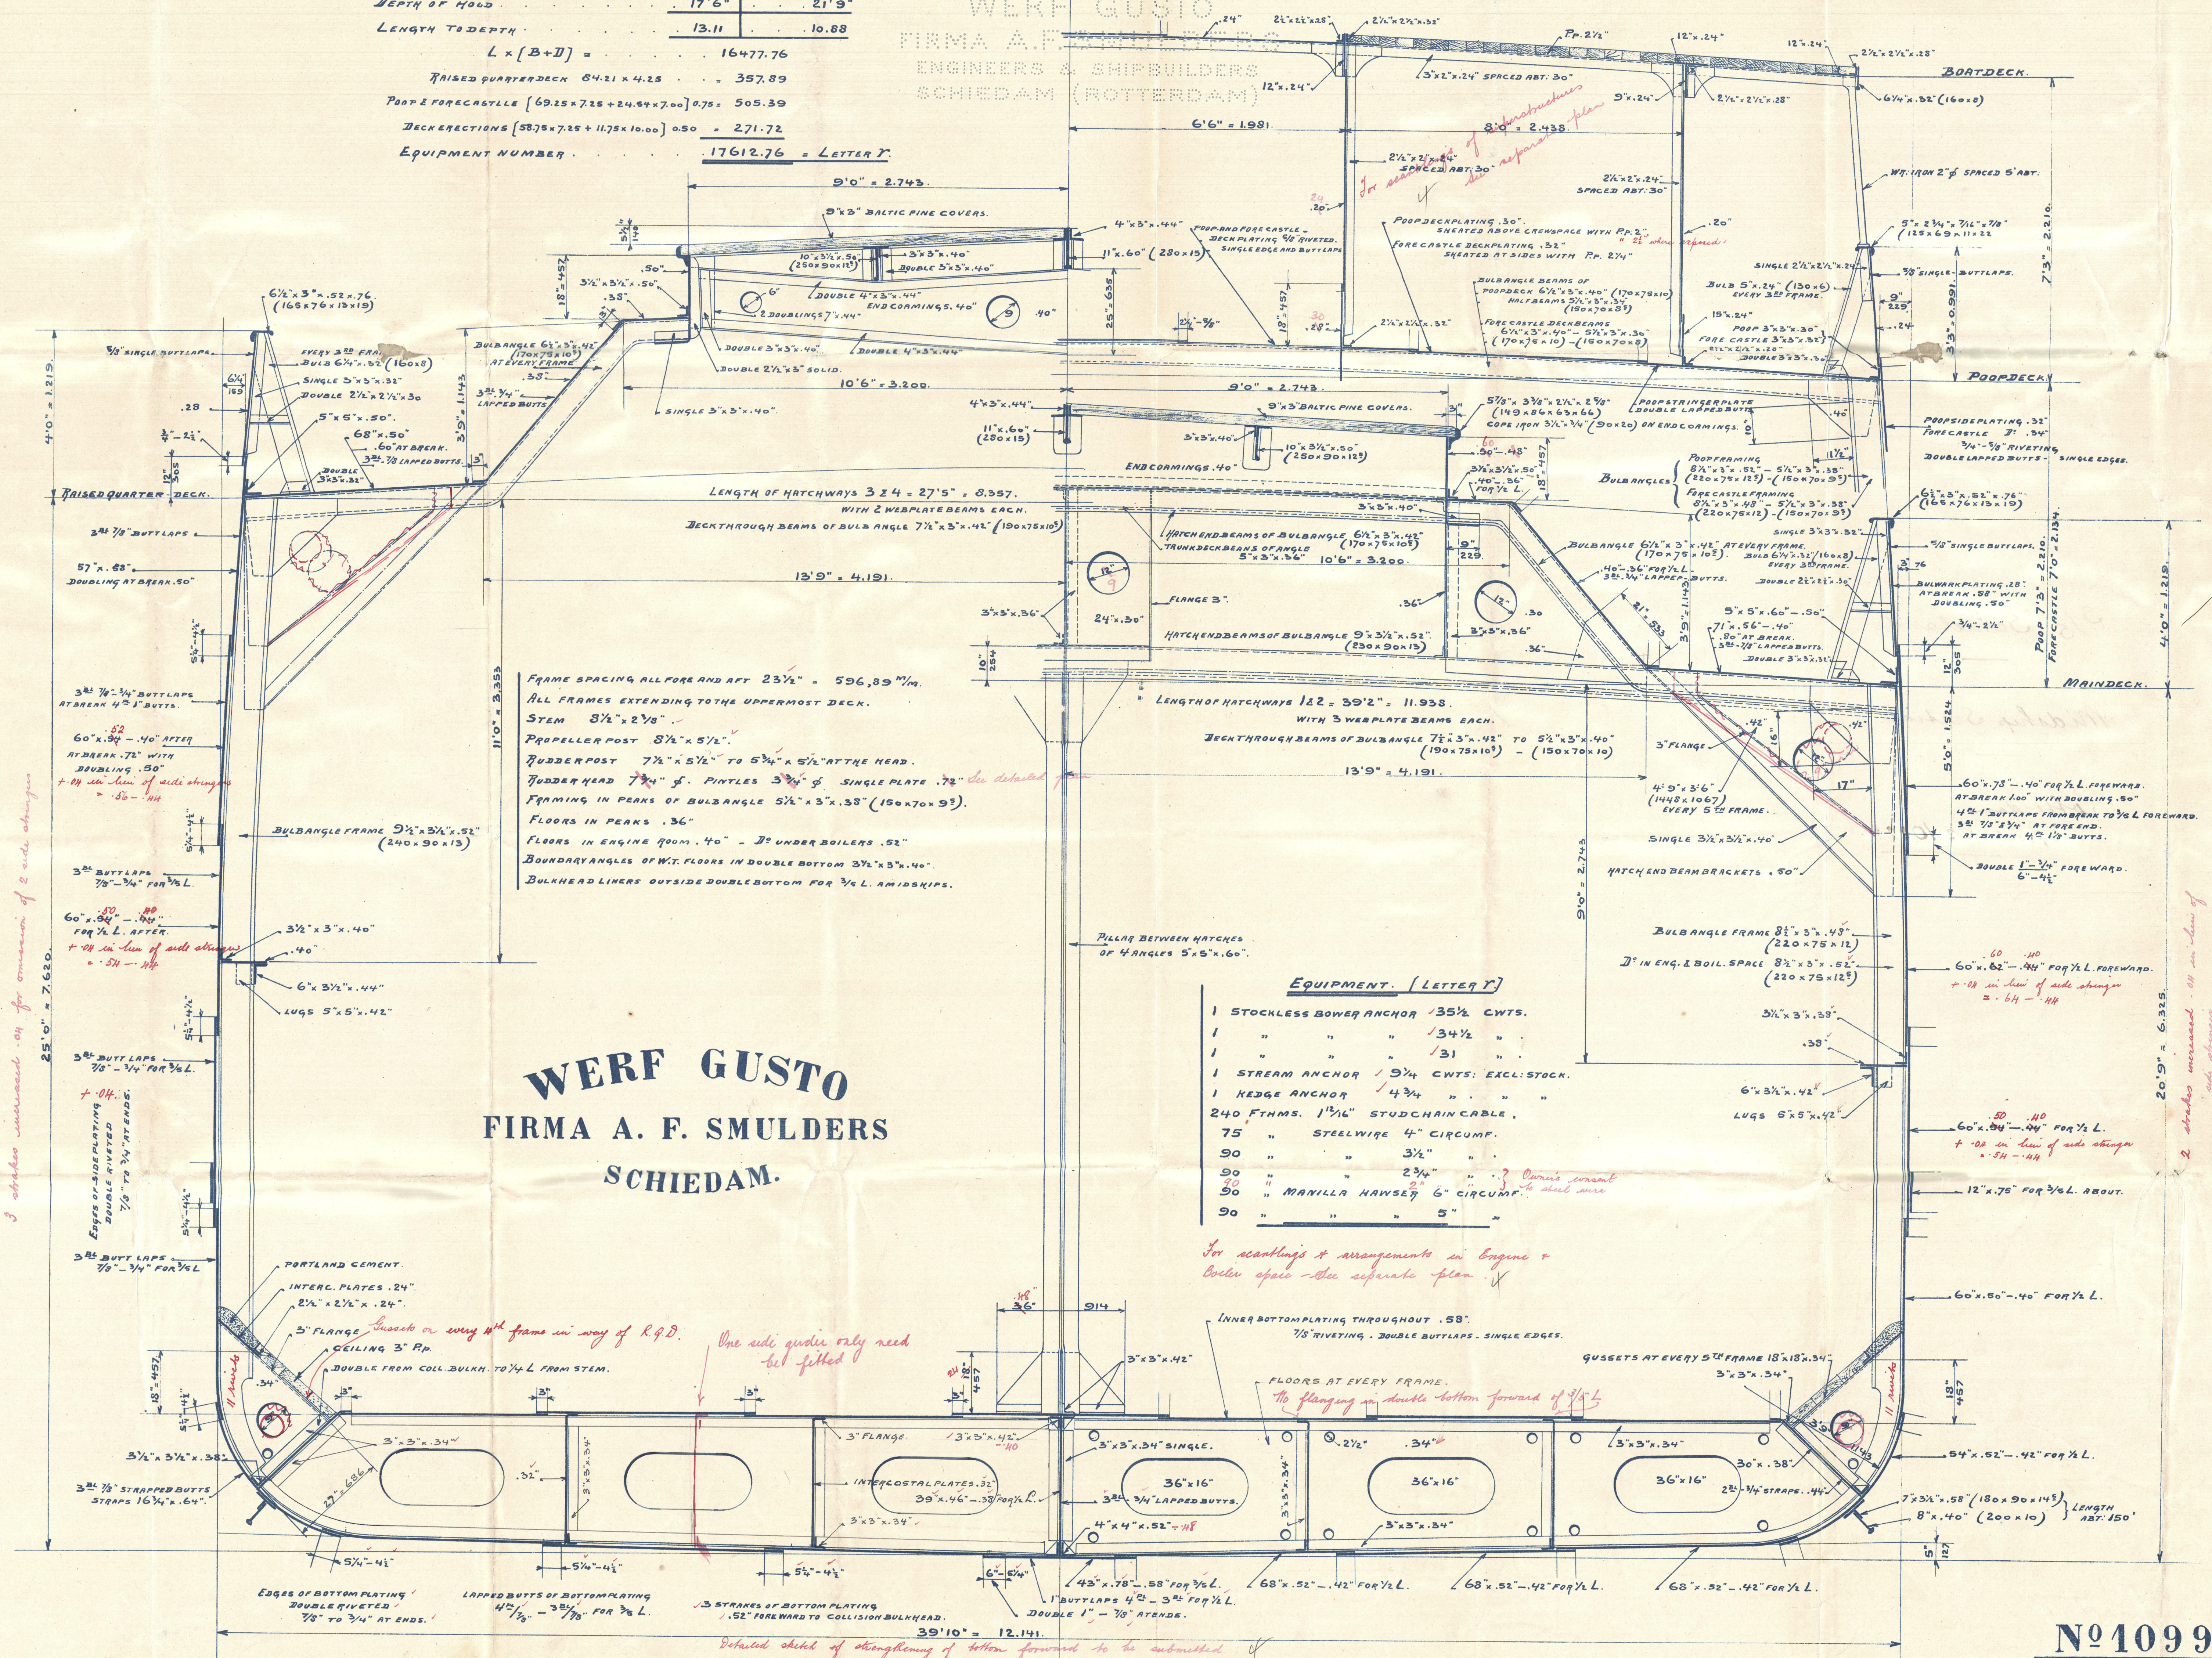

WERF GUSTO
FIRMA A. F. SMULDERS
SCHIEDAM.

EQUIPMENT. [LETTER Y]	
1 STOCKLESS BOWER ANCHOR	135 1/2 CWTs.
1 " " "	134 1/2 " "
1 " " "	131 " "
1 STREAM ANCHOR	1/4 CWTs. EXCL. STOCK.
1 KEDGE ANCHOR	1/4 " " "
240 FTMS. 1 1/4" STUDCHAIN CABLE.	
75 " STEELWIRE 4" CIRCUMF.	
90 " " 3 1/2 " " "	
90 " " 2 3/4 " " "	
90 " MANILLA HAWSEY 6" CIRCUMF.	
90 " " 5 " " "	

No 10993.

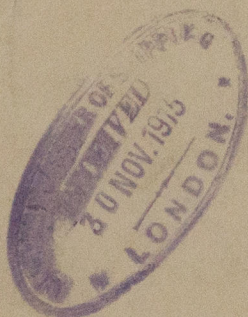

S/S "Schieeland"

Midship Section

Rotterdam
Report No. 10222

