

23.6.15
30.7.15


S.S. "SCHIELAND" - N^o 498
LONGITUDINAL- & DECK PLANS.

SCALE 1 TO 100.


LLOYD'S +100A1 OF STEEL.

LONGITUDINAL SECTION

WERF GUSTO
FIRMA A.F. SMULDERS
ENGINEERS & SHIPBUILDERS
SCHIEDAM (ROTTERDAM)

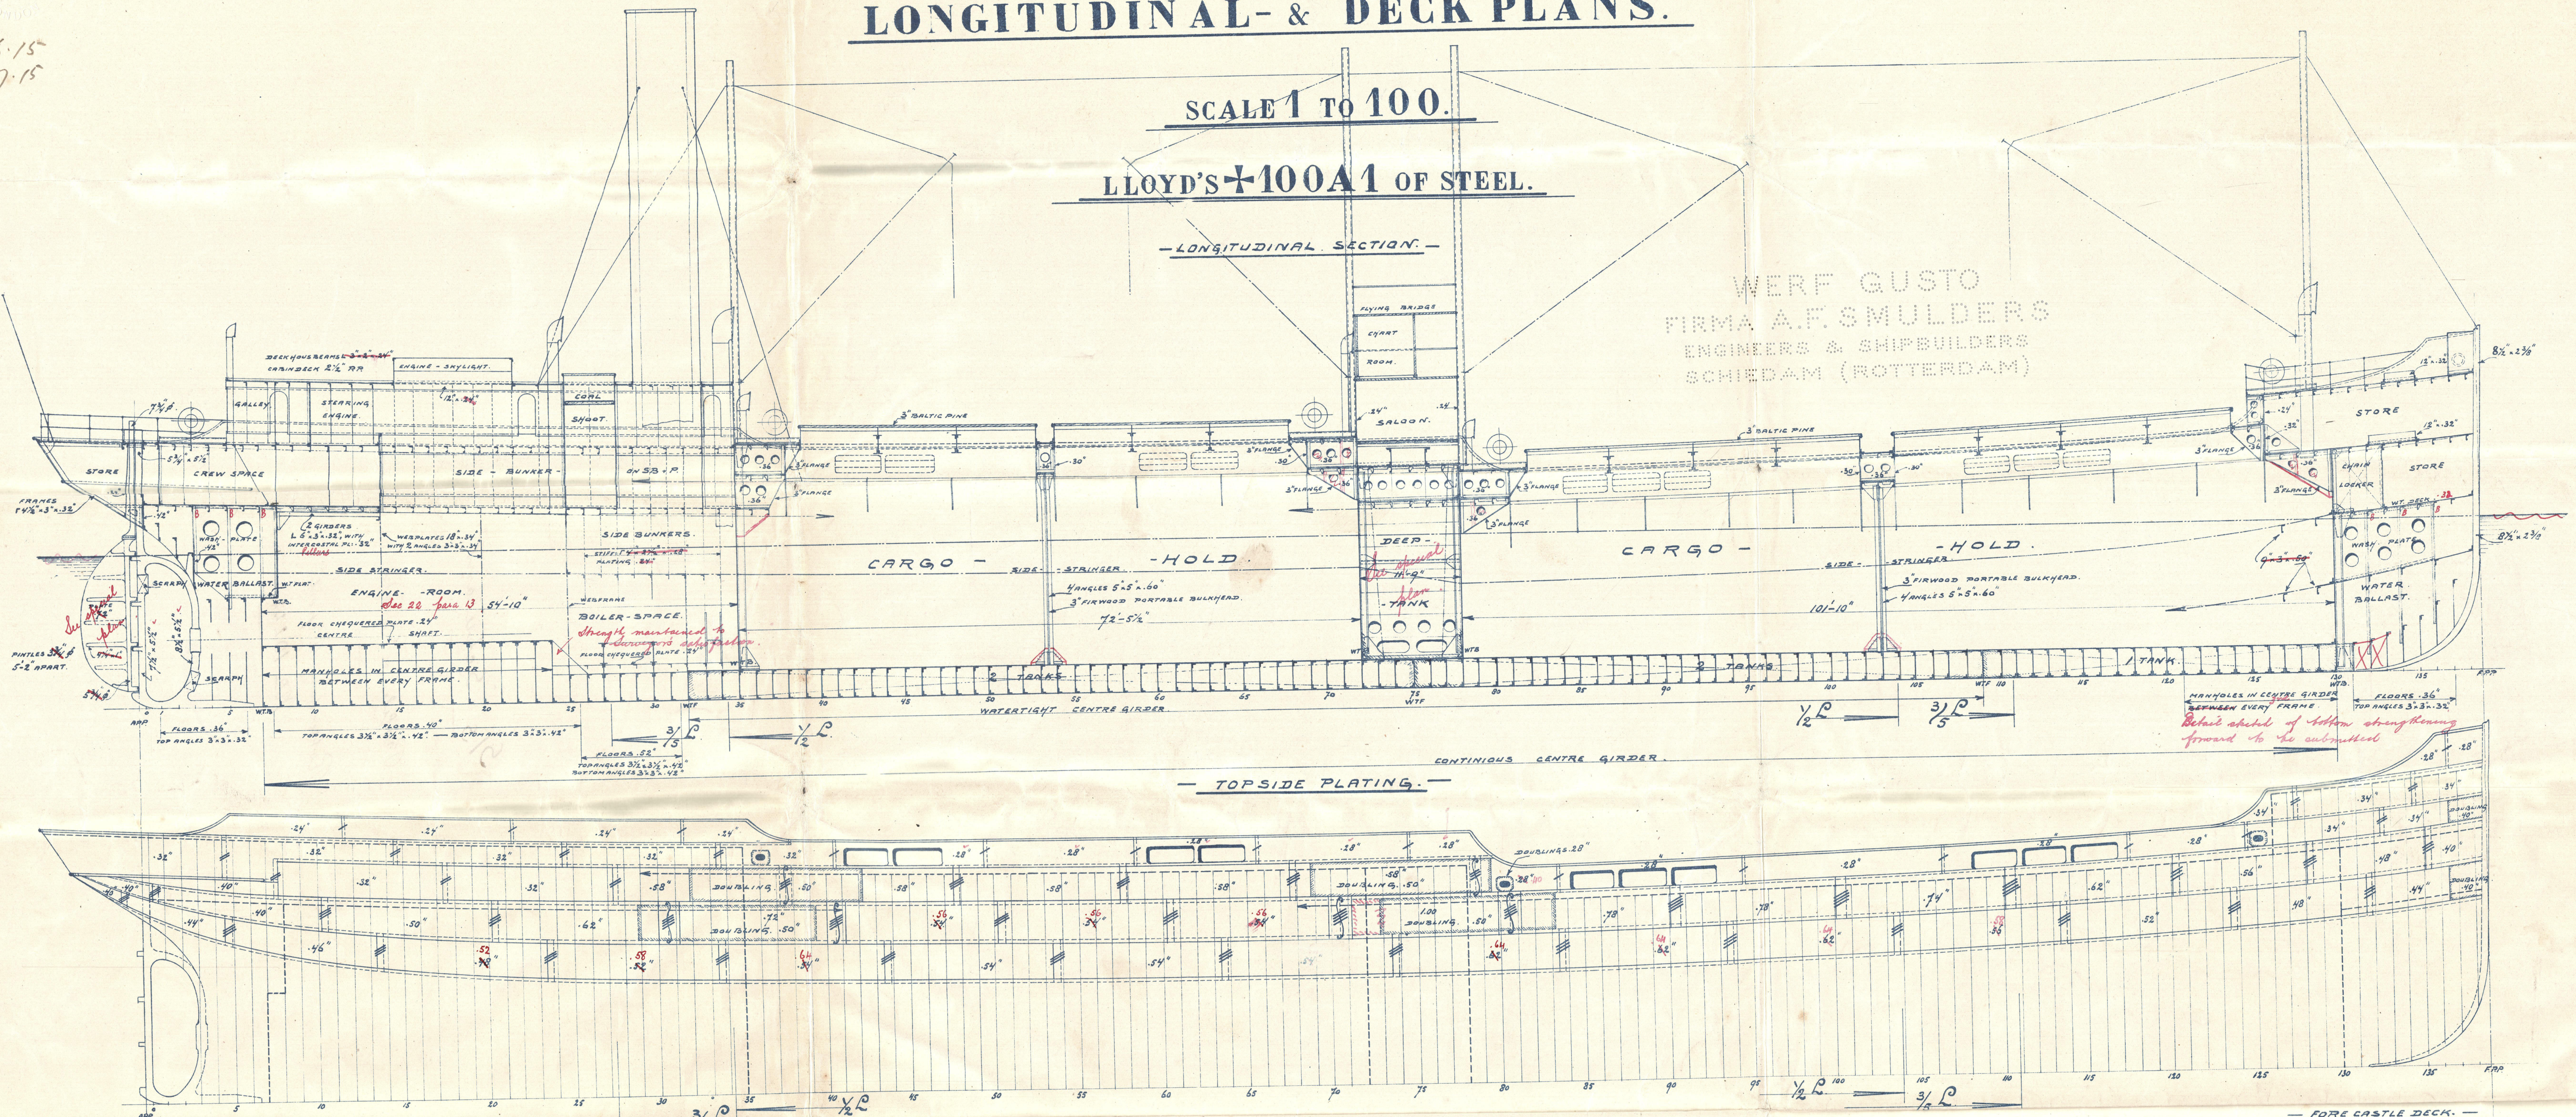


TOPSIDE PLATING

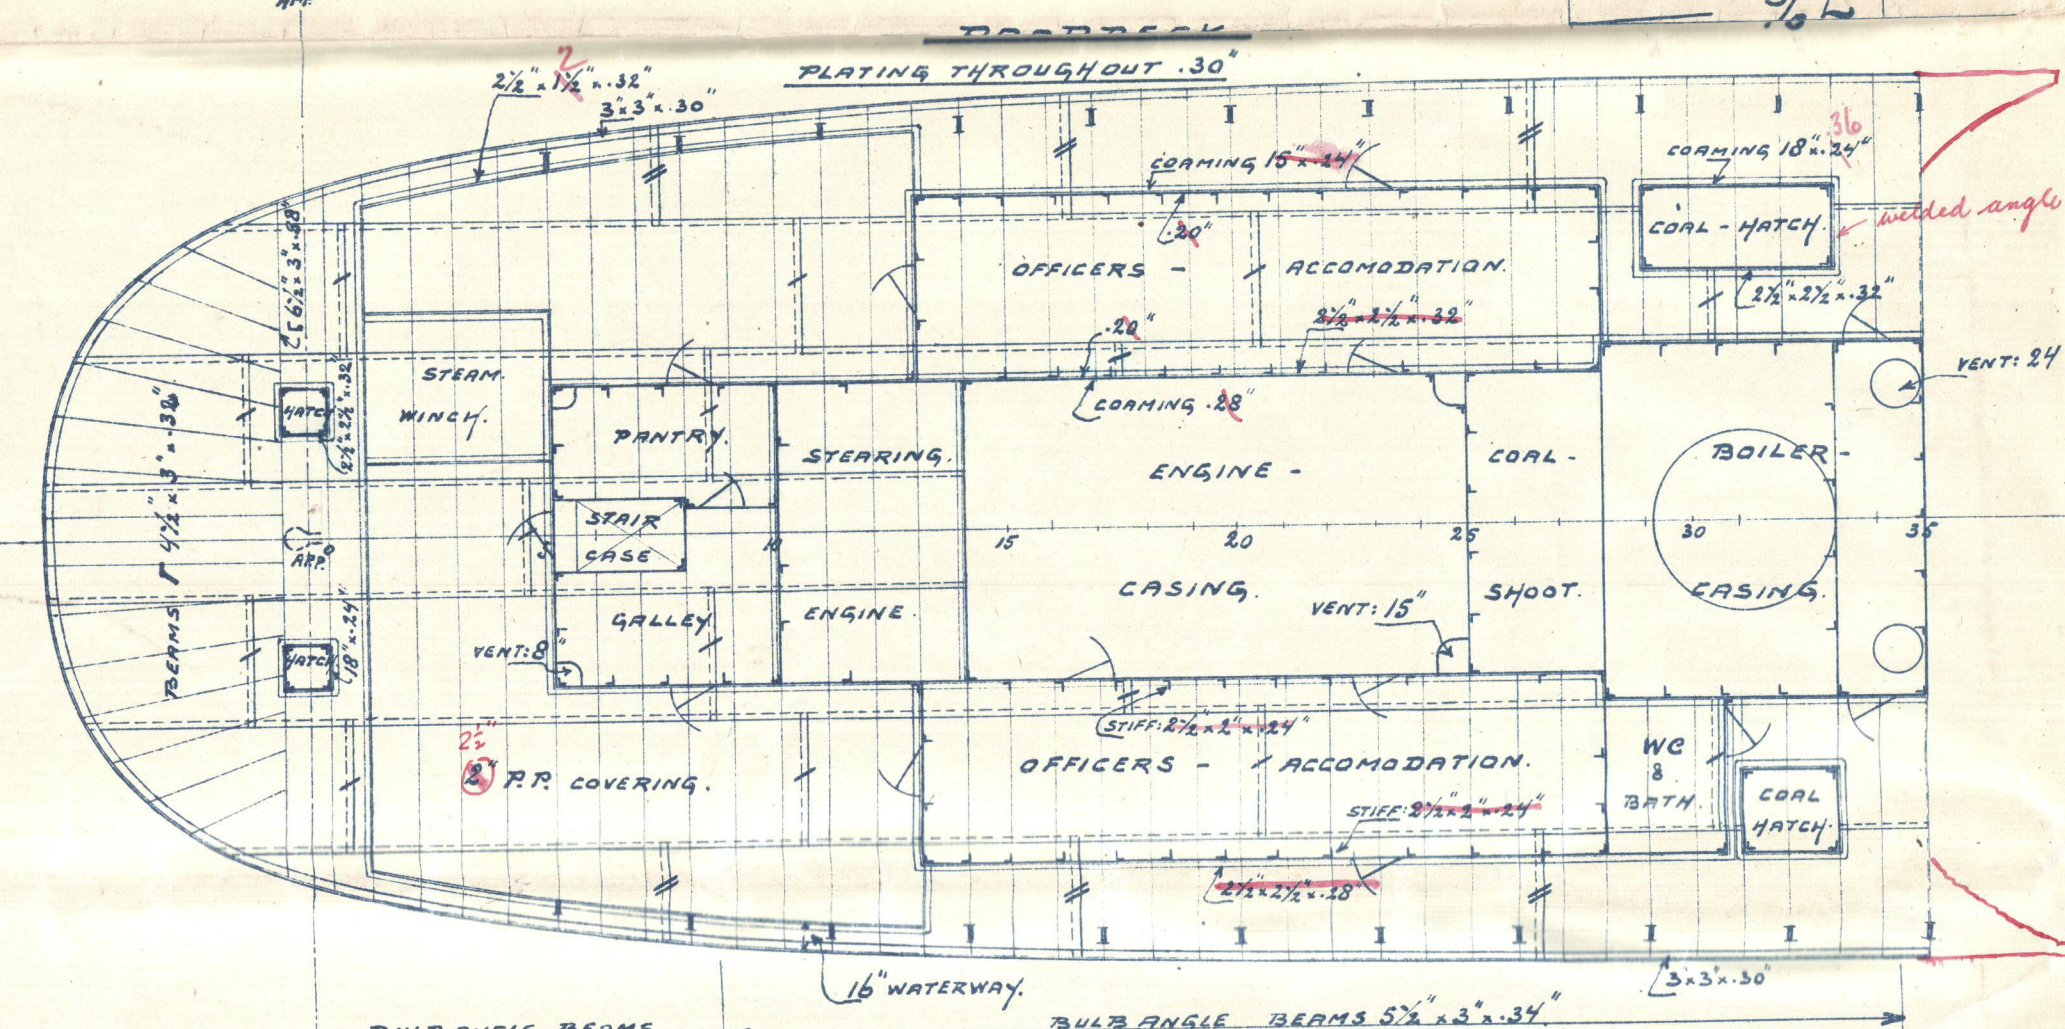


WERF GUSTO
FIRMA A. F. SMULDERS
SCHIEDAM.



PRINCIPAL DIMENSIONS.		
LENGTH BETWEEN PP.	272'-0"	82,905 Metres
BREADTH OVER FRAMES	39'-10"	12,141 "
DEPTH MOULDED TO MAINDECK	20'-9"	6,325 "
HEIGHT OF RAISED QUATERDECK	4'-3"	1,295 "
HEIGHT OF POOPDECK	7'-3"	2,210 "
HEIGHT OF FORE CASTLE DECK	7'-0"	2,134 "
HEIGHT OF DOUBLE BOTTOM (3" ABOVE RULE)	3'-3"	999 "

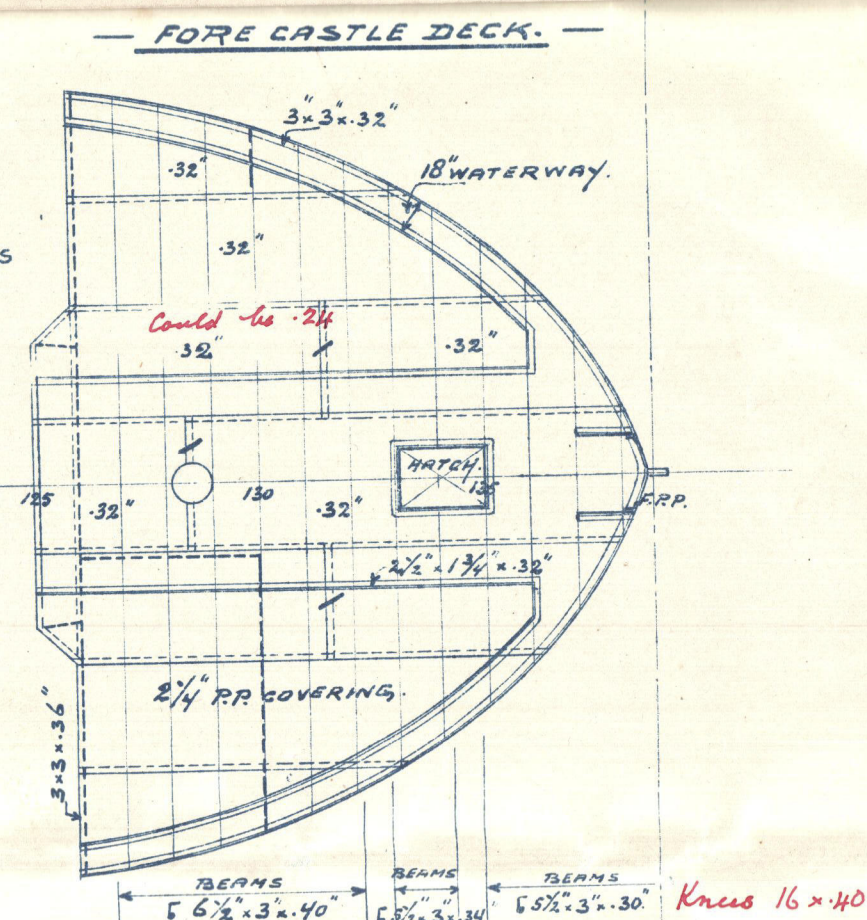

RAISED QUATER DECK

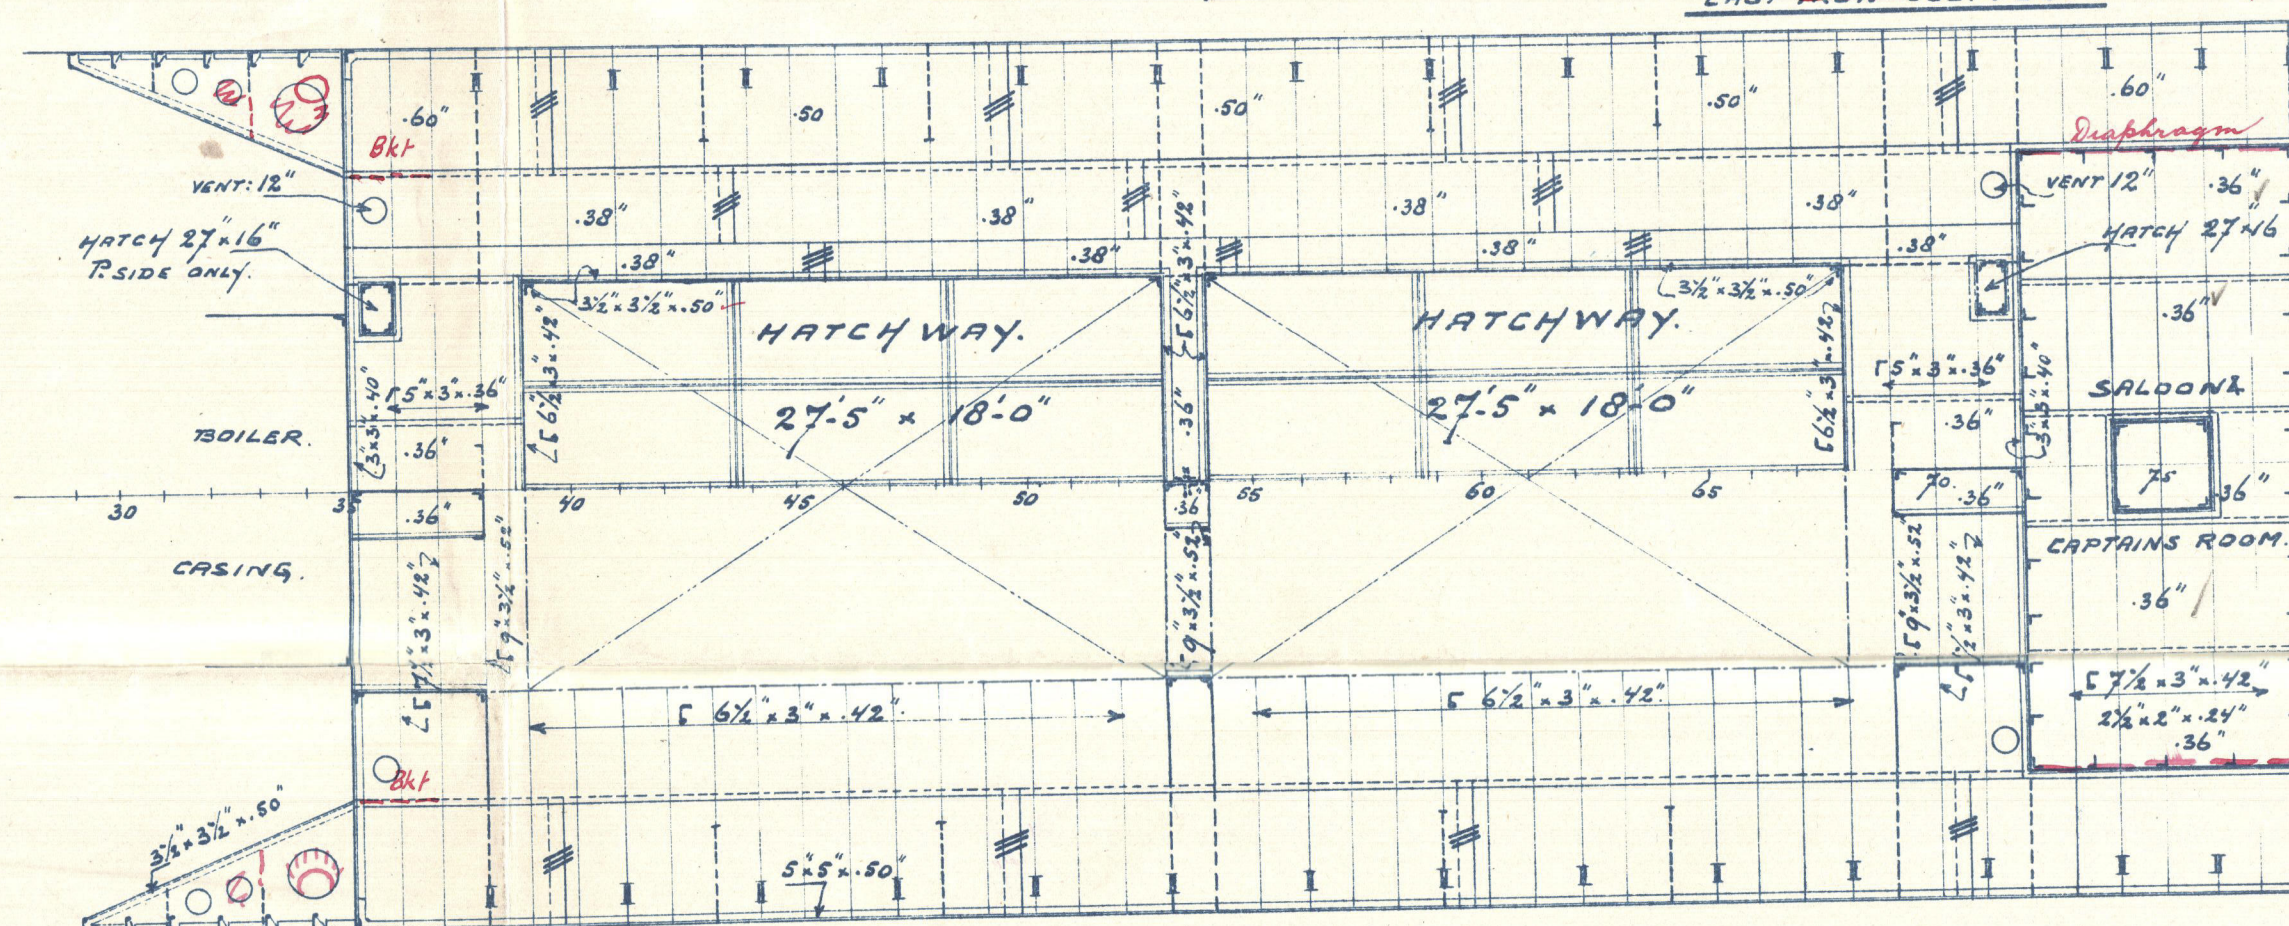

MAINDECK

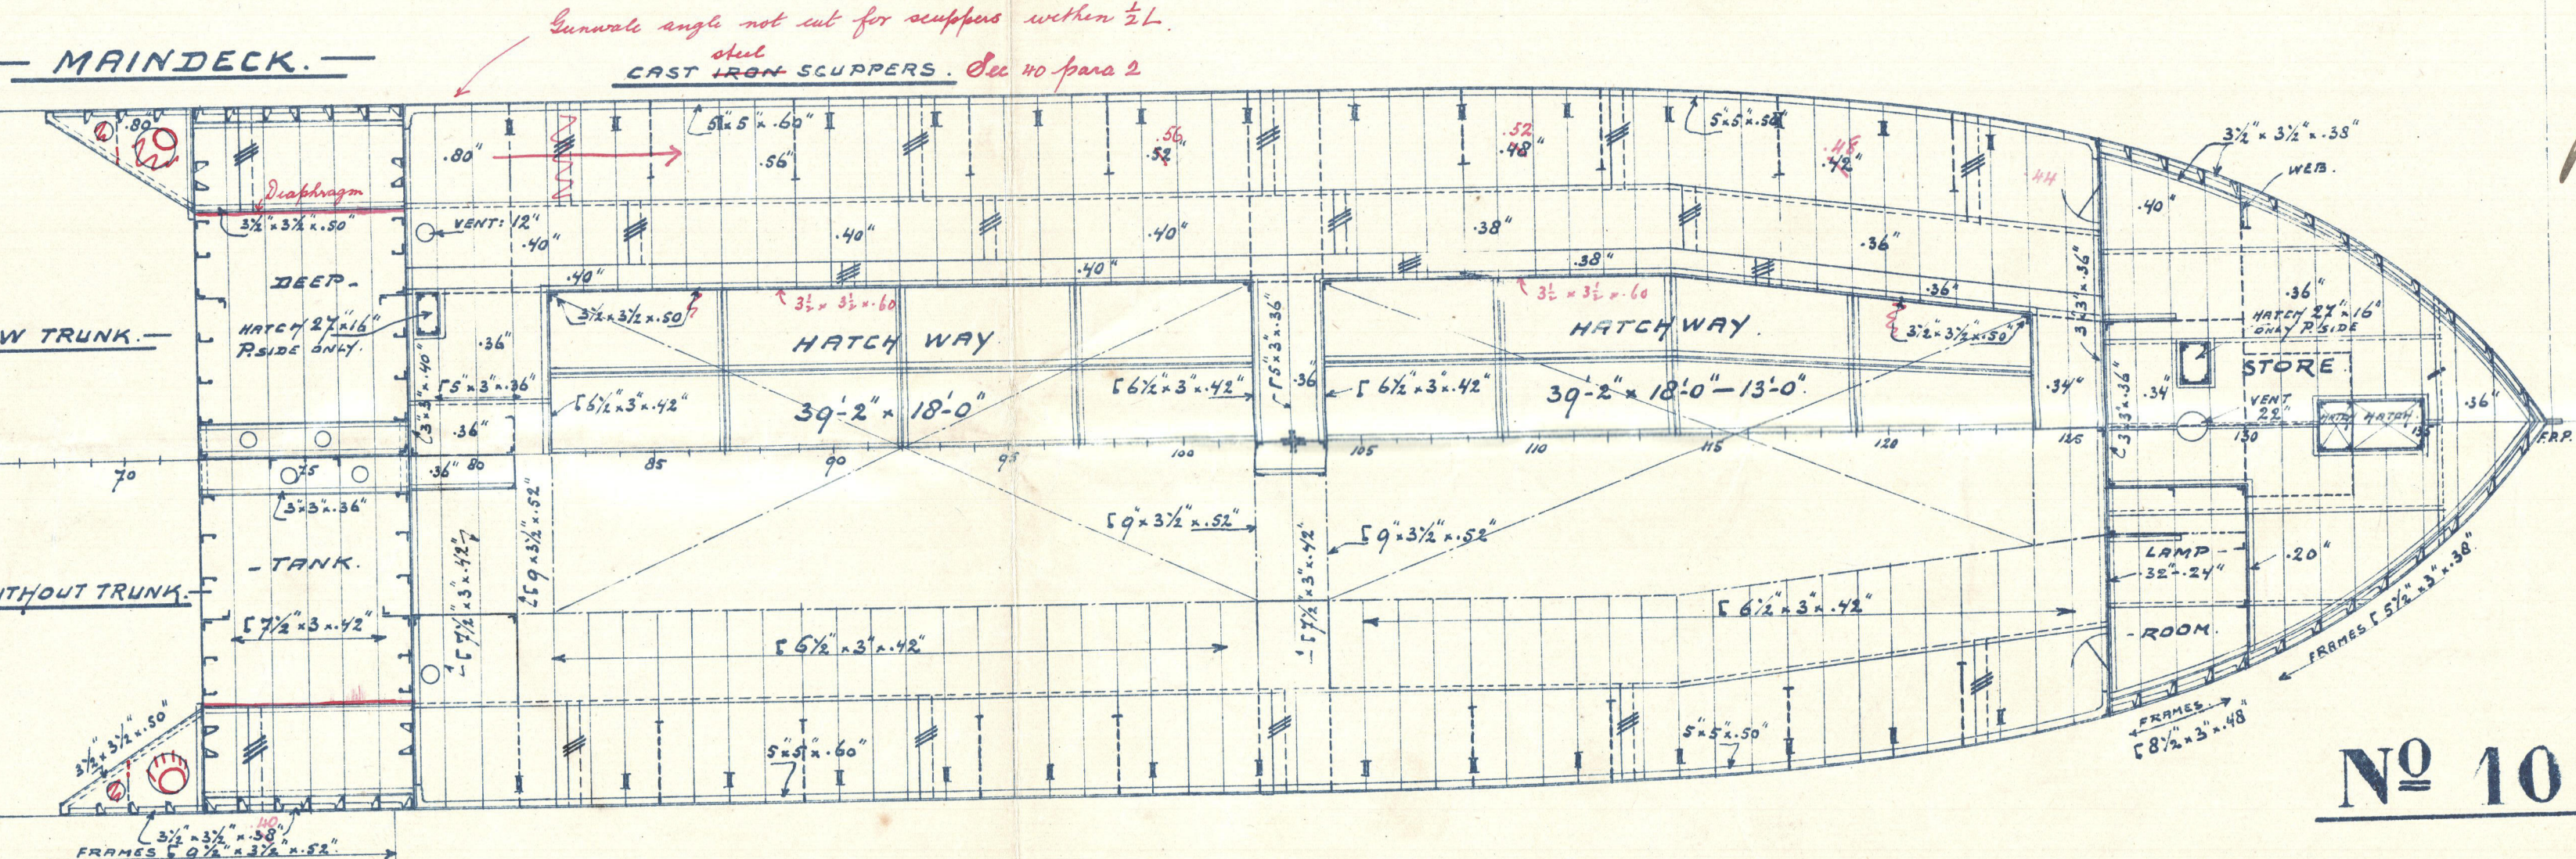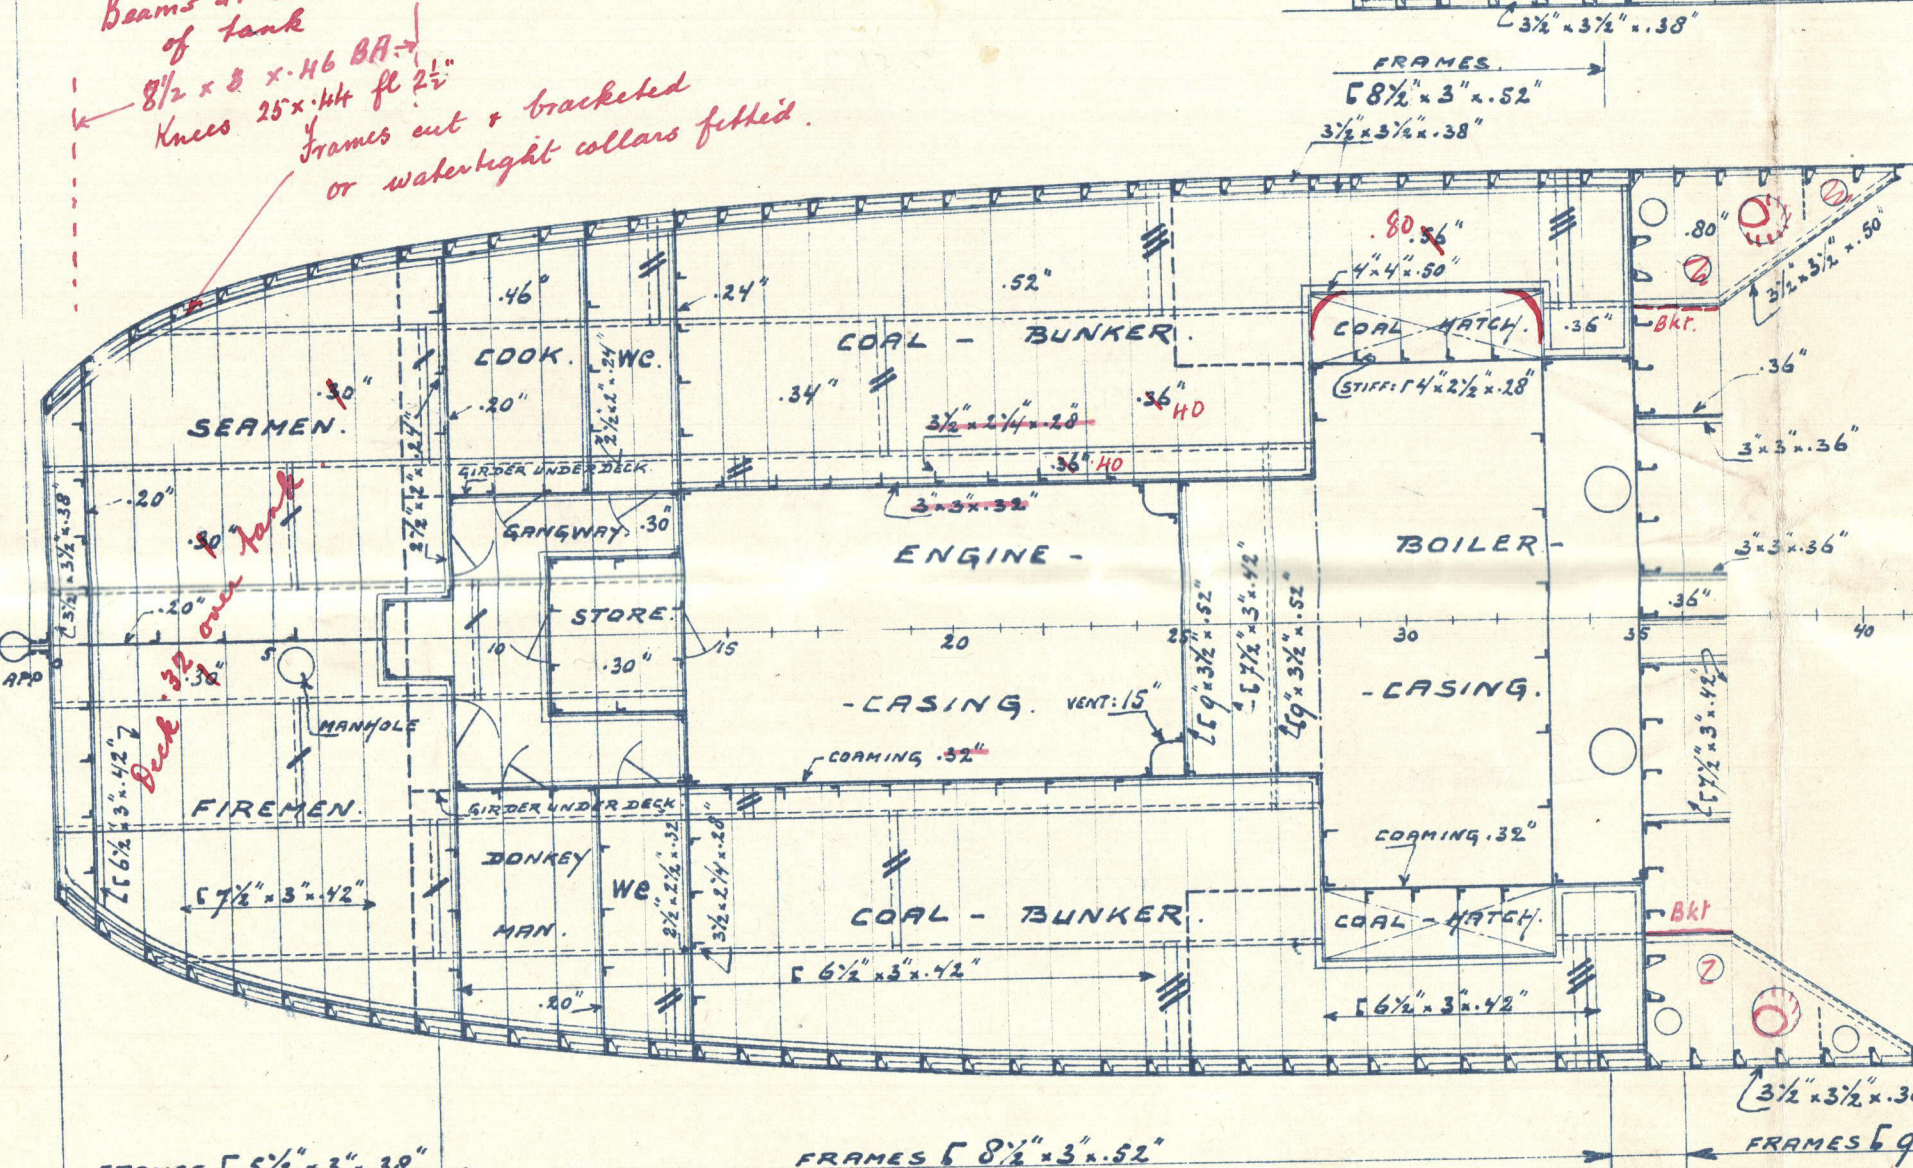

N^o 10994A




S/S "Schieland"

Profile & Decks

Rotterdam Report
No 10222



W119-0199

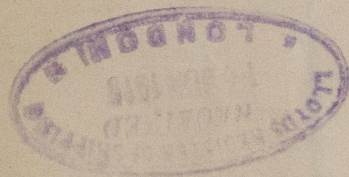

W119-0199



© 2020

Lloyd's Register
Foundation