


### HORIZONTAL FLUE TUBES

6. HOLES 1" DIA FOR  
3/8" HOLDING DOWN BOLTS  
ON 4'-1 1/2" DIA PITCH CIRCLE  
EQUALLY PITCHED.

TOTAL HEATING SURFACE... 100 sq ft  
GRATE AREA... 7.5 sq ft

JOINT IN TOP & BOTTOM STRAKES OF SHELL

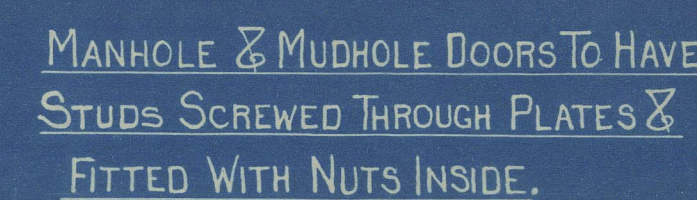

SHIP № 594

3'-9" x 10'-0" x 100# x 100 LBS. W.P.

Scale: 1/2 INCH TO 1 FOOT

SIEMENS-MARTIN MILD STEEL PLATES.  
TENSILE TESTS.

N.R

PLATES NOT EXPOSED TO FLAME OR FLANGED.....	28 To 32 TONS.
PLATES EXPOSED TO FLAME OR FLANGED.....	26 To 30 TONS.

# SURVEY-LLOYDS

COCHRAN & CO ANNAN LD

## ENGINEERS & BOILERMAKERS

ANNAN, SCOTLAND

DRAWING N° 13462

13402



Cochran & Co., Annan Ltd

Boiler N° 9227

W.P. 100 lbs./sq. in.

Boiler Stamped  
N° 9227

N° 16335

LLOYD'S TEST

200 LBS.

W.P. 100 LBS.

H.C.F. 7-9-23

J. S. Glenkil

GLASGOW REPORT No. 2999

Approved 21-6-23

W1194-0021

© 2021

Lloyd's Register