

S.S. EMPIRE DACE. (No. 1754)  
S.S. EMPIRE ROACH. (No. 1755)  
S.S. EMPIRE CHUB. (No. 1756)


# PROFILE & DECK PLAN.

DIMENSIONS: 179'-6" P.P. x 40'-0" B.M.D. x 15'-0" D.M.D.


TO CLASS LLOYDS\* 100 A.I. WITH A FREEBOARD CORRESPONDING

TO A DRAFT OF 9'-0" B.K. WITH THE NOTATION "FOR GOVERNMENT SERVICE."

SCALE  $\frac{1}{8}" = 1'-0"$ .

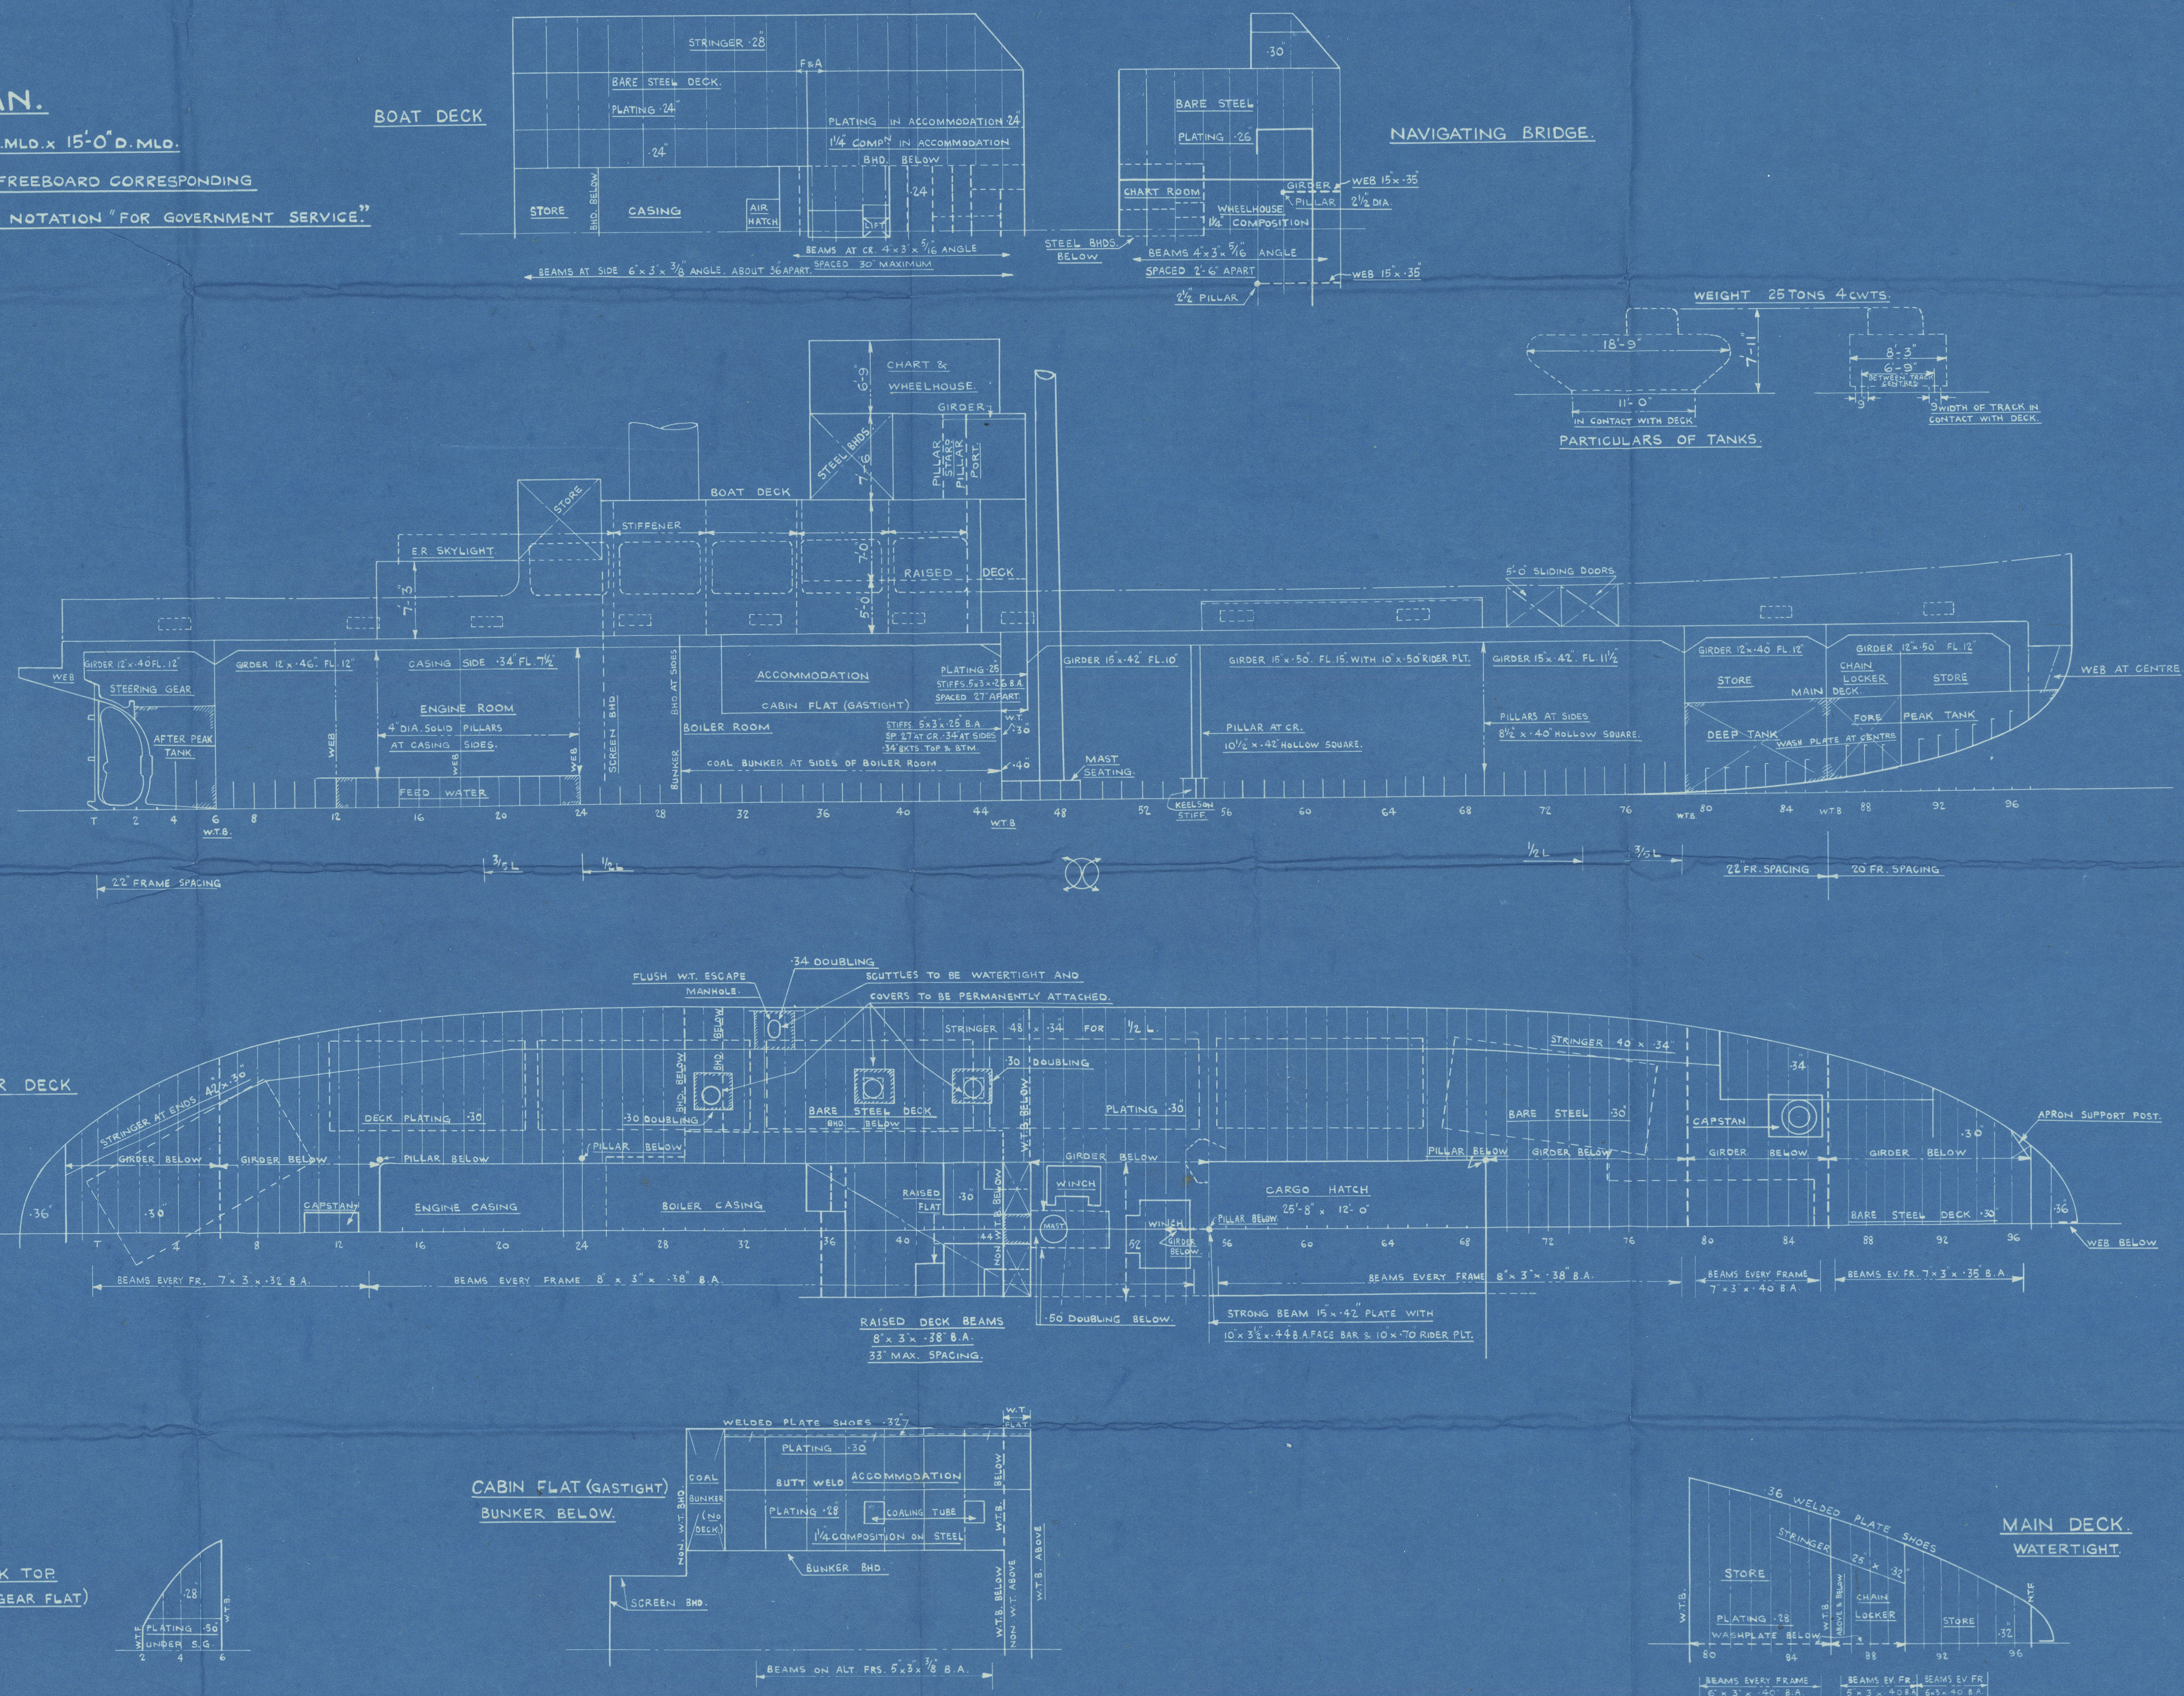

No. 7877

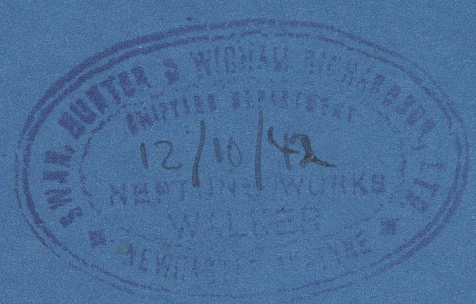



Profile and Deck Plan  
( As fitted )

Nos. 1754, 6, 8.

EMPIRE DACE

NEWCASTLE ON TYNE.

Report No. 100783

SWAN HUNTER & WIGHAM  
RICHARDSON LTD.



© 2020

Lloyd's Register  
Foundation

W1195-0200