

16/5/18  
30-6-19

— PROPOSED SCANTLINGS OF DECK PLATING AND BEAMS. —

— N° 441 S.S. —

— 'B' TYPE. —

— SCALE  $\frac{1}{8}'' = 1' FT$  —

BRIDGE DECK

STRINGER BUTTS OVERLAPPED STRAIGHT RIVETED.  
PLATING --- DOUBLE ---  
LANDINGS SINGLE RIVETED.  
BEAMS AND CARLINGS 8"x8"x10 BA.

POOP DECK

LANDINGS SINGLE RIVETED.

BEAMS 7"x8"x10 BA.

POOP DECK 20" THICK IF NOT ALTHOUGH

SCANTLING OF HATCH NEAR  
UPPER DECK  
PLATES 11"x36"  
TOP & BOTTOM ANGLES 3"x6"x10 DOUBLE  
2ND DECK  
PLATES 14"x36"  
TOP & BOTTOM ANGLES 3"x6"x10 DOUBLE

POOP DECK

LANDINGS SINGLE RIVETED.

BEAMS 8"x8"x10 BA. UNLESS OTHERWISE MARKED.

UPPER DECK BEAMS.

BEAMS 8"x8"x10 BA.

CARLINGS 14" WAY OF 9"x10"x10 BA.

HATCH END BEAMS TO BE NORMAL SCANTLING.

UPPER DECK  
LANDINGS SINGLE RIVETED

2ND DECK  
LANDINGS SINGLE RIVETED

2ND DECK BEAMS

BEAMS 8"x8"x10 BA.

CARLINGS 8"x8"x10 BA.

HATCH END BEAMS TO BE NORMAL SCANTLING.





Standard Vessels B Type.



Deck Plans . 20 ft Hatchways

Workman Black & Co 441-2-3-4-5

To "Munich" (4)

Bel 8138

Hatch directions altered in 445

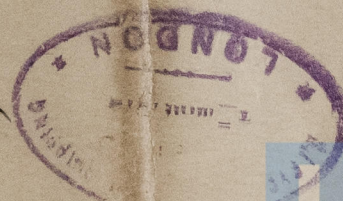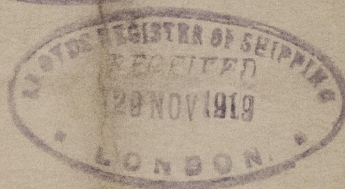

RETAIN

W1199-0105



© 2021

Lloyd's Register  
Foundation