

BILGE-AND BALLASTPIPING

S.S. "MALACHITE"


SCALE 1:50

Nº	DESCRIPTION	DIAM.	MATERIAL
✓ 1	BALLASTPIPE TO FORE PEAK	2"	GALV. IRON
✓ 2	" " TANK Nº 1	3"	CAST "
✓ 3	" " " Nº 2 STARB. CENTRE	3"	" "
✓ 4	" " " Nº 2 " WING	2 1/2"	GALV. "
✓ 5	" " " Nº 2 PORT CENTRE	3"	CAST "
✓ 6	" " " Nº 2 " WING	2 1/2"	GALV. "
✓ 7	GENERAL BALLASTPIPE	3"	CAST "
✓ 8	INLET BALLAST FROM SEA	5"	" "
✓ 9	SUCTION BALLASTPUMP FROM SEA AND TANKS	5"	" "
✓ 10	" " " GENERAL BILGE PIPE	3"	" "
✓ 11	" " " ENGINE ROOM DIRECT	2"	GALV. "
✓ 12	BALLASTPIPE TO AFTER PEAK	2"	" "
✓ 13	BILGE FORE HOLD STARB. AFTER	2"	" "

Nº	DESCRIPTION	DIAM.	MATERIAL
✓ 14	BILGE FORE HOLD PORT AFTER	2"	GALV. IRON
✓ 15	" STORE HOLD STARB.	2"	" "
✓ 16	" " PORT	2"	" "
✓ 17	GENERAL BILGE PIPE	3"	CAST "
✓ 18	SUCTION ENGINE BILGE PUMPS	3"	GALV. "
✓ 19	" " PUMPS FROM ENGINE ROOM DIRECT	2"	" "
✓ 20	INLET CIRCULATINGPUMP FROM SEA	6"	CAST "
✓ 21	BILGE CIRCULATINGPUMP FROM ENGINE ROOM ^(BILGE INJECTION)	3 1/2"	" "
✓ 22	HANDPUMP ON DECK STARB.	2"	GALV. "
✓ 23	" " " PORT	2"	" "
✓ 24	BILGE FORE HOLD STARB. CENTRE	2"	" "
✓ 25	" " PORT	2"	" "
✓ 26	HANDPUMP ENGINE ROOM	2"	" "

PENN & BAUDOUIN
• LAGER- EN KOPINGSTUUR •
• KUNSTMAKERS- WERKPLAATS •
• Constructiewerkplaats •
DORDRECHT

L.P. = HUPPIPE DIAM. 2"
P.P. = SOUNDINGPIPE " 2"
A = BILGE VALVE BOX
B = BALLAST " "
H = HANDPUMP

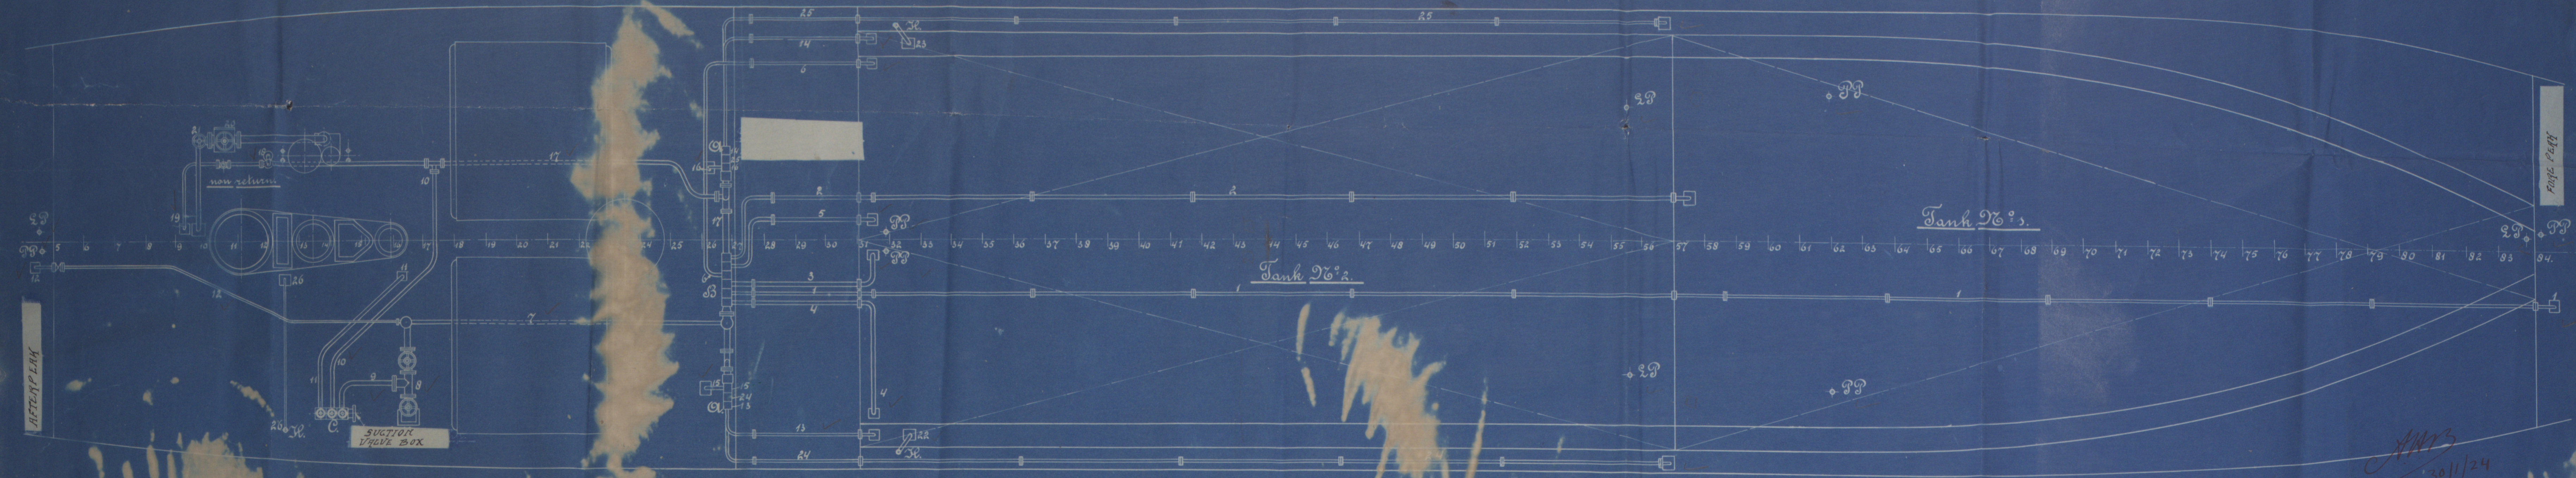

W12-0366

W12-0366
30/11/24


Bilge Ballast Tipping
of "Malachite"

Greenock Report No 18174

"Brynmill".

ex

"Malachite".

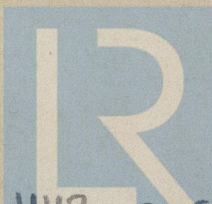

© 2021

Lloyd's Register
Foundation

W12-0066