


# No. 723


## Profile & Deck Plan.

Dimensions:- Length 136'-0" • Breadth 35'-0" • Depth 23'-10"  
 Scale 1/8" = one foot.

Block Coefficient .55.  
 NOTE: Pillars may be adjusted to suit cattle stalls.  
 To Surveyor's Satisfaction

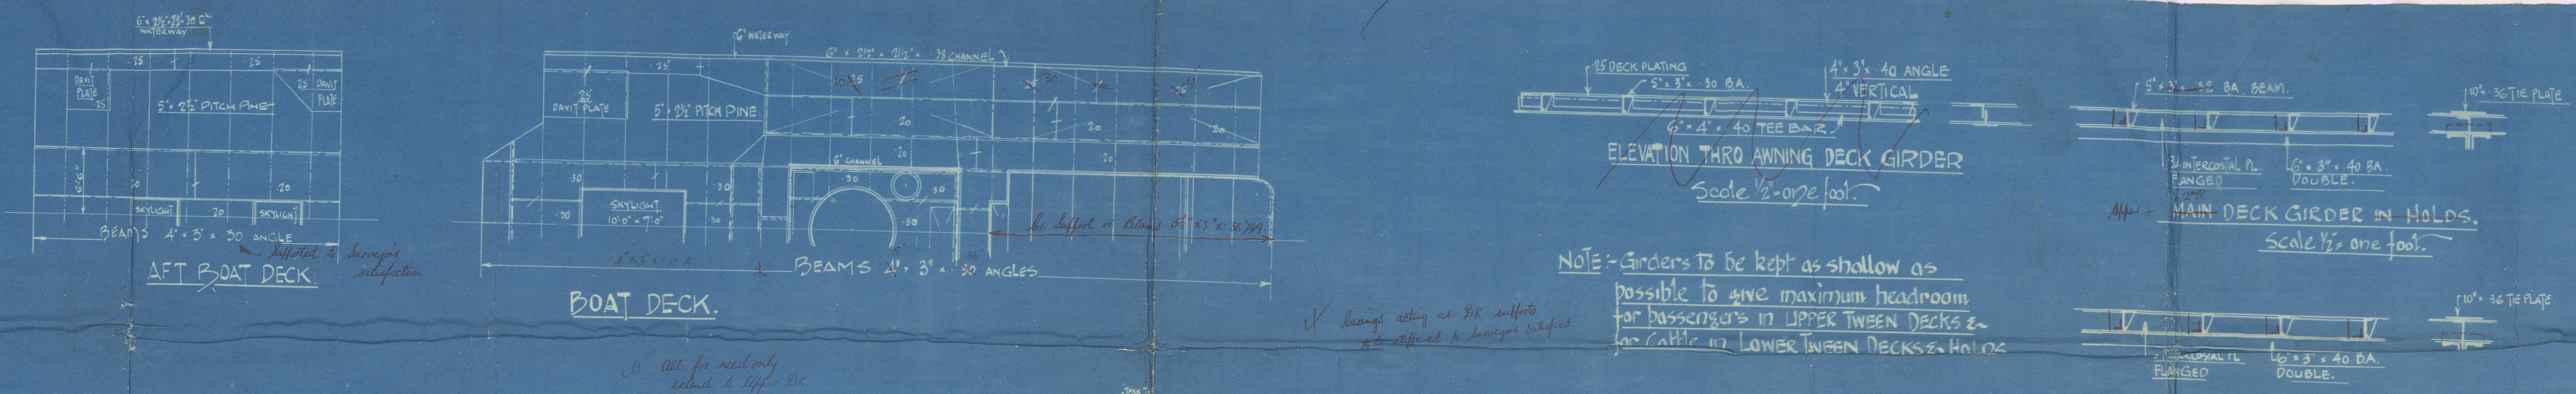


NOTE: Girders to be kept as shallow as possible to give maximum headroom for passengers in upper tween decks & lower tween decks & holds.

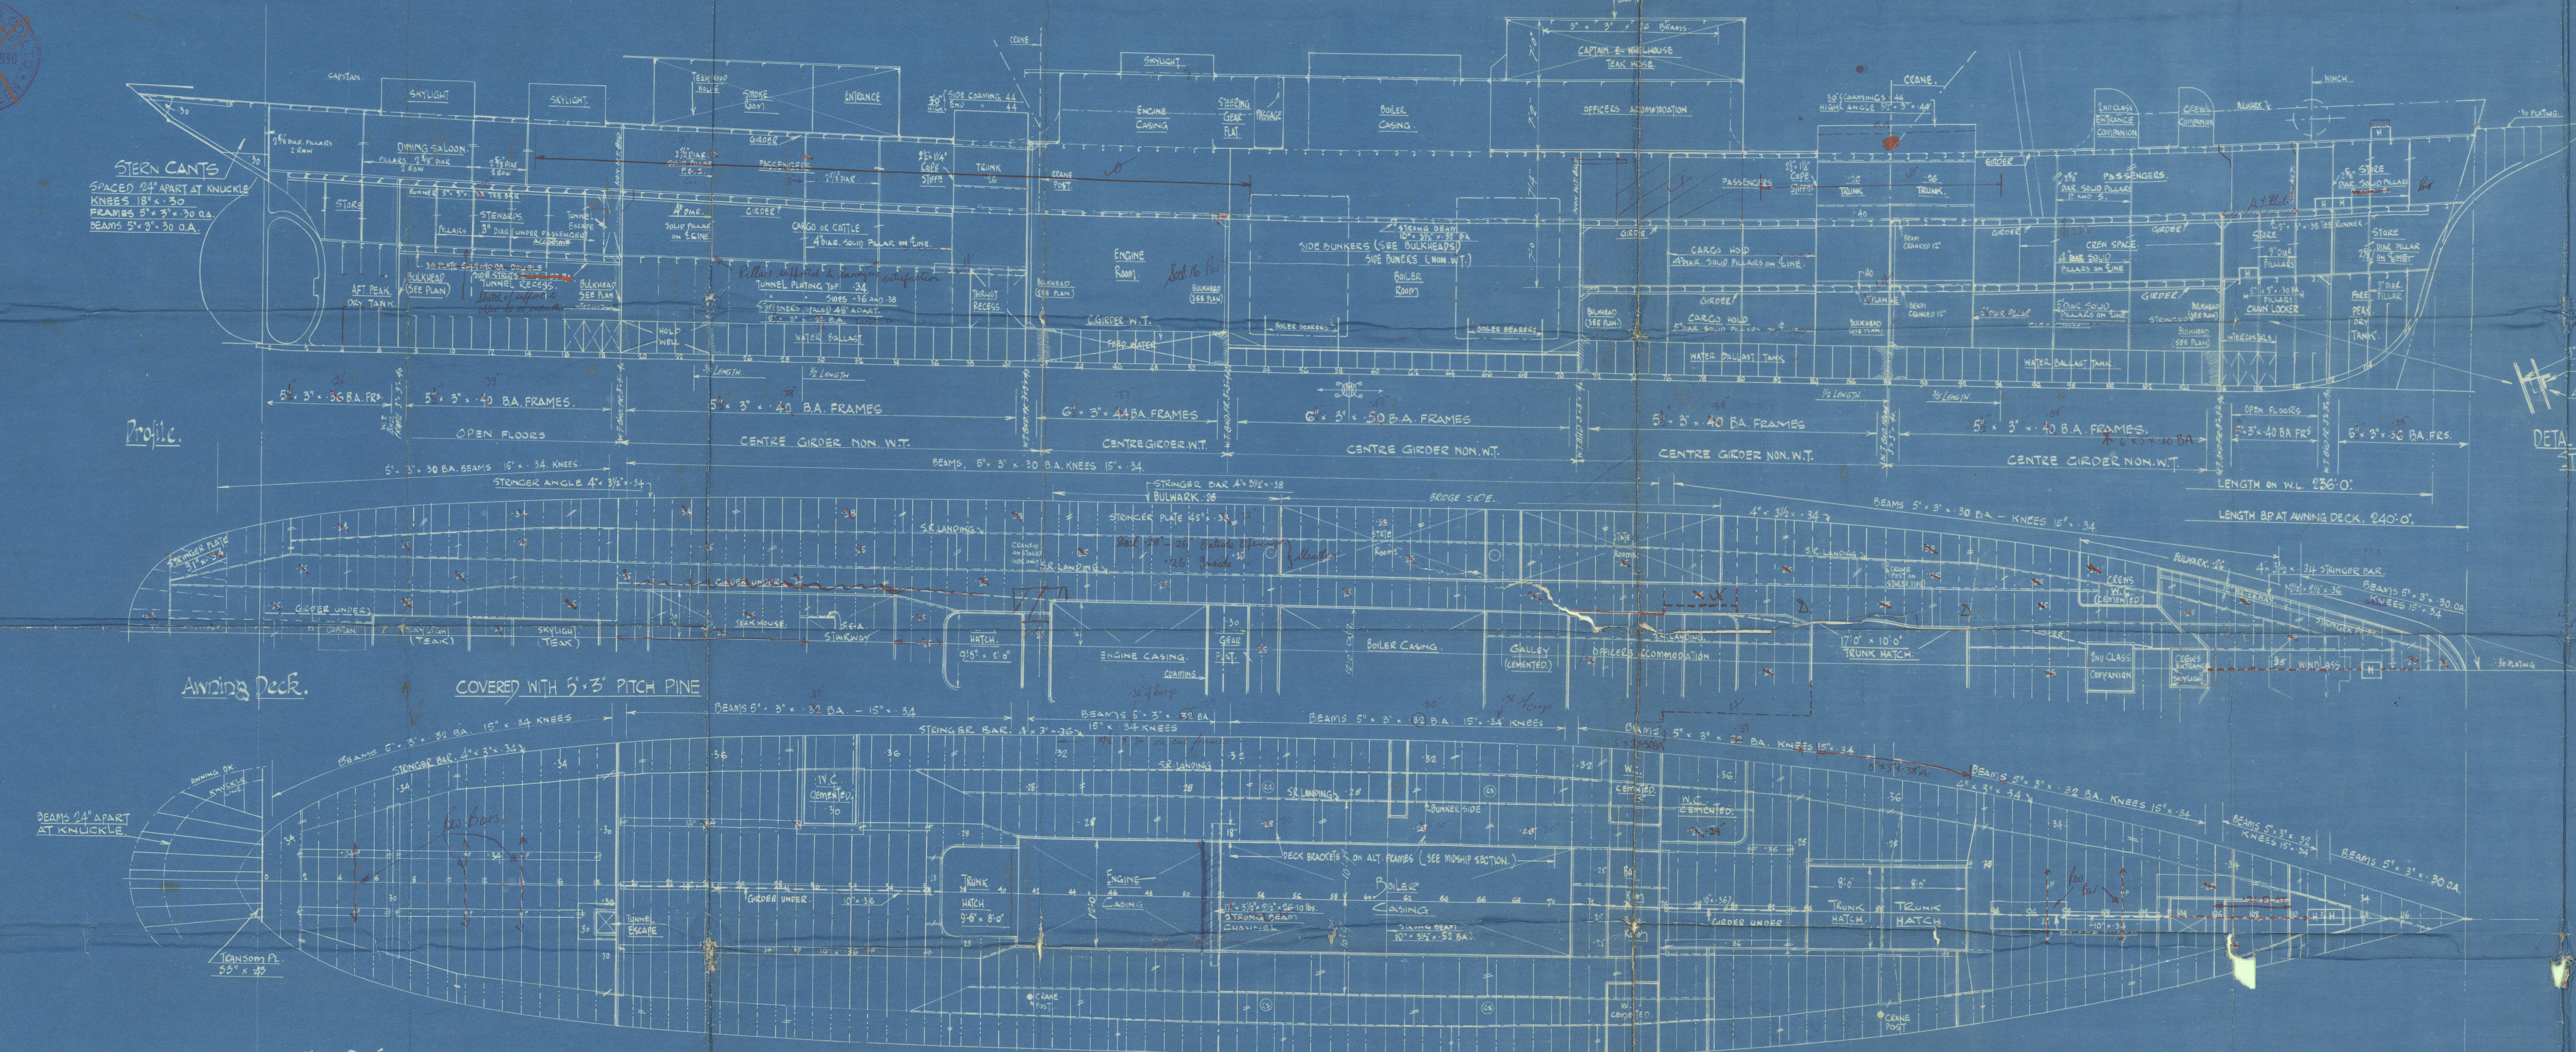

DETAIL OF PAINTING STRINGER.

### Riveting Schedule.

Trips	RIVETS DIA.	BUTTS	Notes
" Main Deck stringer Aming DK	3/4" - 9/8"	3/8" dia. DK	4 1/2" dia. SR bars for 1st 10
" " Main Lower DK	3/8"	3/8" dia. DK	4 1/2" dia. SR bars for 1st 10
" " Plating	3/8"	3/8" dia. DK	4 1/2" dia. SR bars for 1st 10
" " Tank Top	3/8"	3/8" dia. DK	4 1/2" dia. SR bars for 1st 10
" " Plating	3/8"	3/8" dia. DK	4 1/2" dia. SR bars for 1st 10
" " Boat DK. Plating Stringer	3/8"	3/8" dia. DK	4 1/2" dia. SR bars for 1st 10
" " Tunnel Plating	3/8"	3/8" dia. DK	4 1/2" dia. SR bars for 1st 10

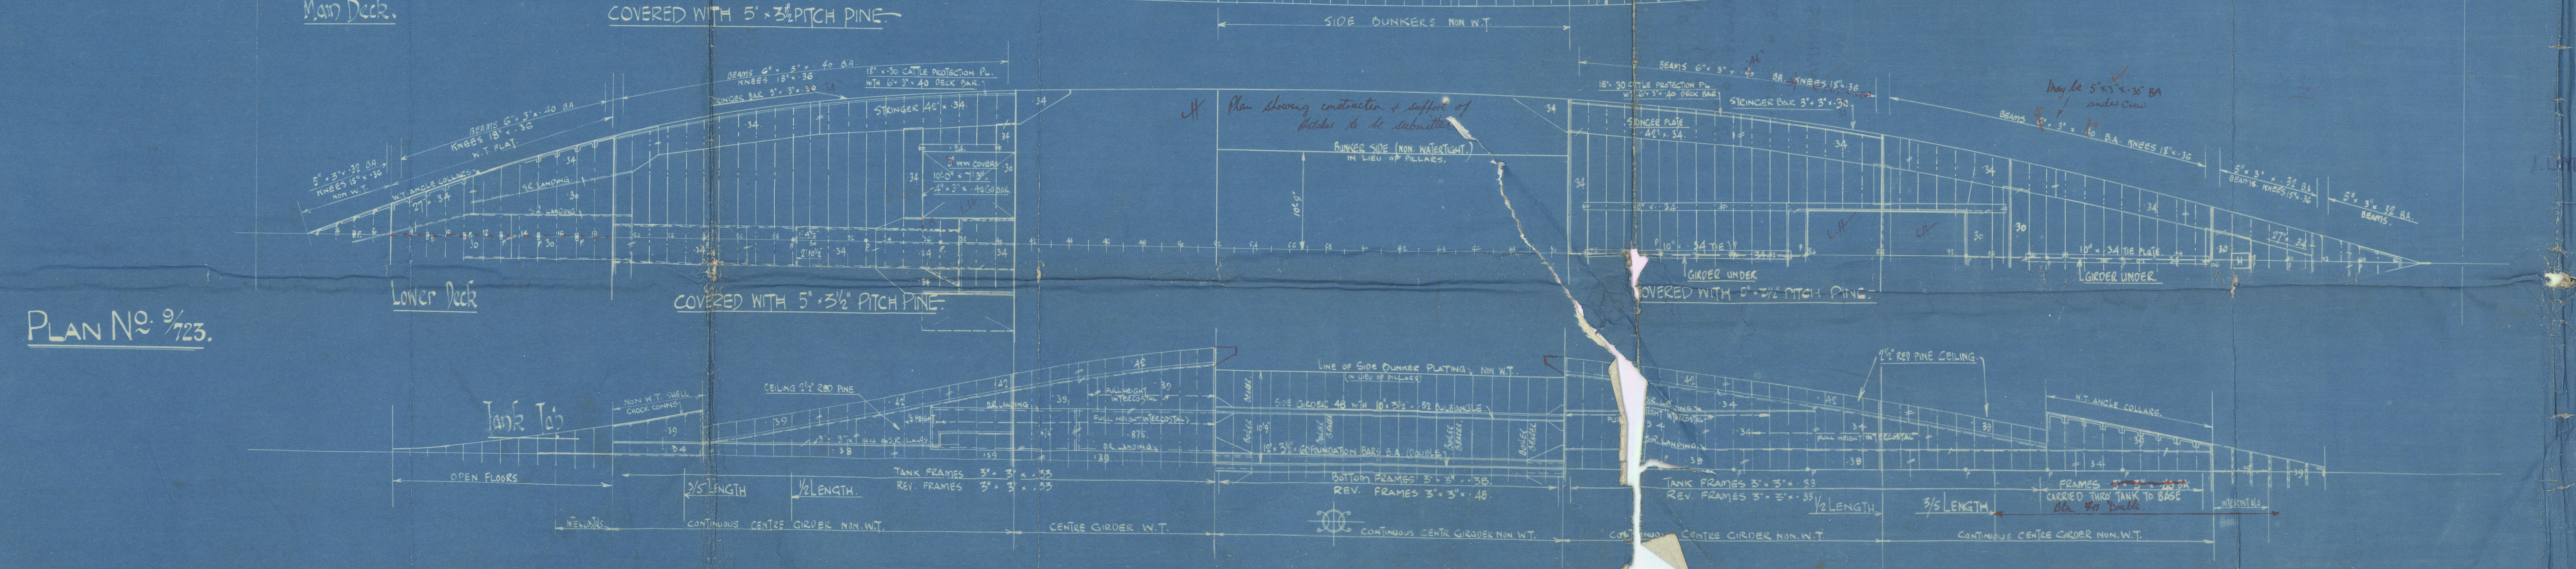

APPROVED  
 LLOYD'S REGISTER OF SHIPPING  
 12.9.30

Approved  
 Lloyd's Register of Shipping  
 (S.S.) 12.9.30

PLAN No. 723.

N<sup>o</sup>. 723.

Hall Russell & Co. Ld.

Profs & Decks.

S.S. "ST SUNNIYA"

abu. Report. 16613.

W120-0069



© 2019

Lloyd's Register  
Foundation