

NOTE: ALL B.A. SECTIONS ARE NEW BRITISH STANDARD, REVISED JULY, 1924.

- No 283 - MIDSHIP SECTION.

DIMENSIONS: 460' 0" B.P. & 61' 0" M.L.P. = 33' 3" M.L.P. TO UPPER DECK

SCALE 1/2" = 1' FEET

LYDD'S NUMERALS


1st LONGITUDINAL No	L x D	450' 0" x 33' 25"	= 15295.00
2nd	L x (B+D)	460' 0" x (61' 0" + 33' 25")	= 43555.00



TO CLASS 100A.16 AT LYDD'S CARRYING PETROLEUM IN BULK
"LONGITUDINAL FRAMING AT BOTTOM AND AT DECK"

3 BULKHEADS 7 1/2' CTR EACH (STOCKLESS)

1. STEEL	22	EA. STOCK
2. 300 PATENTS	2 1/2	STUD CHAIN CABLE (TAYLOR)
3. 120	1 1/2	STEEL WIRE - OR 5 FLEXIBLE STEEL WIRE 6-12
4. 180	3/4	SPECIAL FLEXIBLE STEEL WIRE 6-12
5. 2	100	PATENTS 2 3/4" STEEL WIRE 6-12
6. 2	100	WAPPS 100

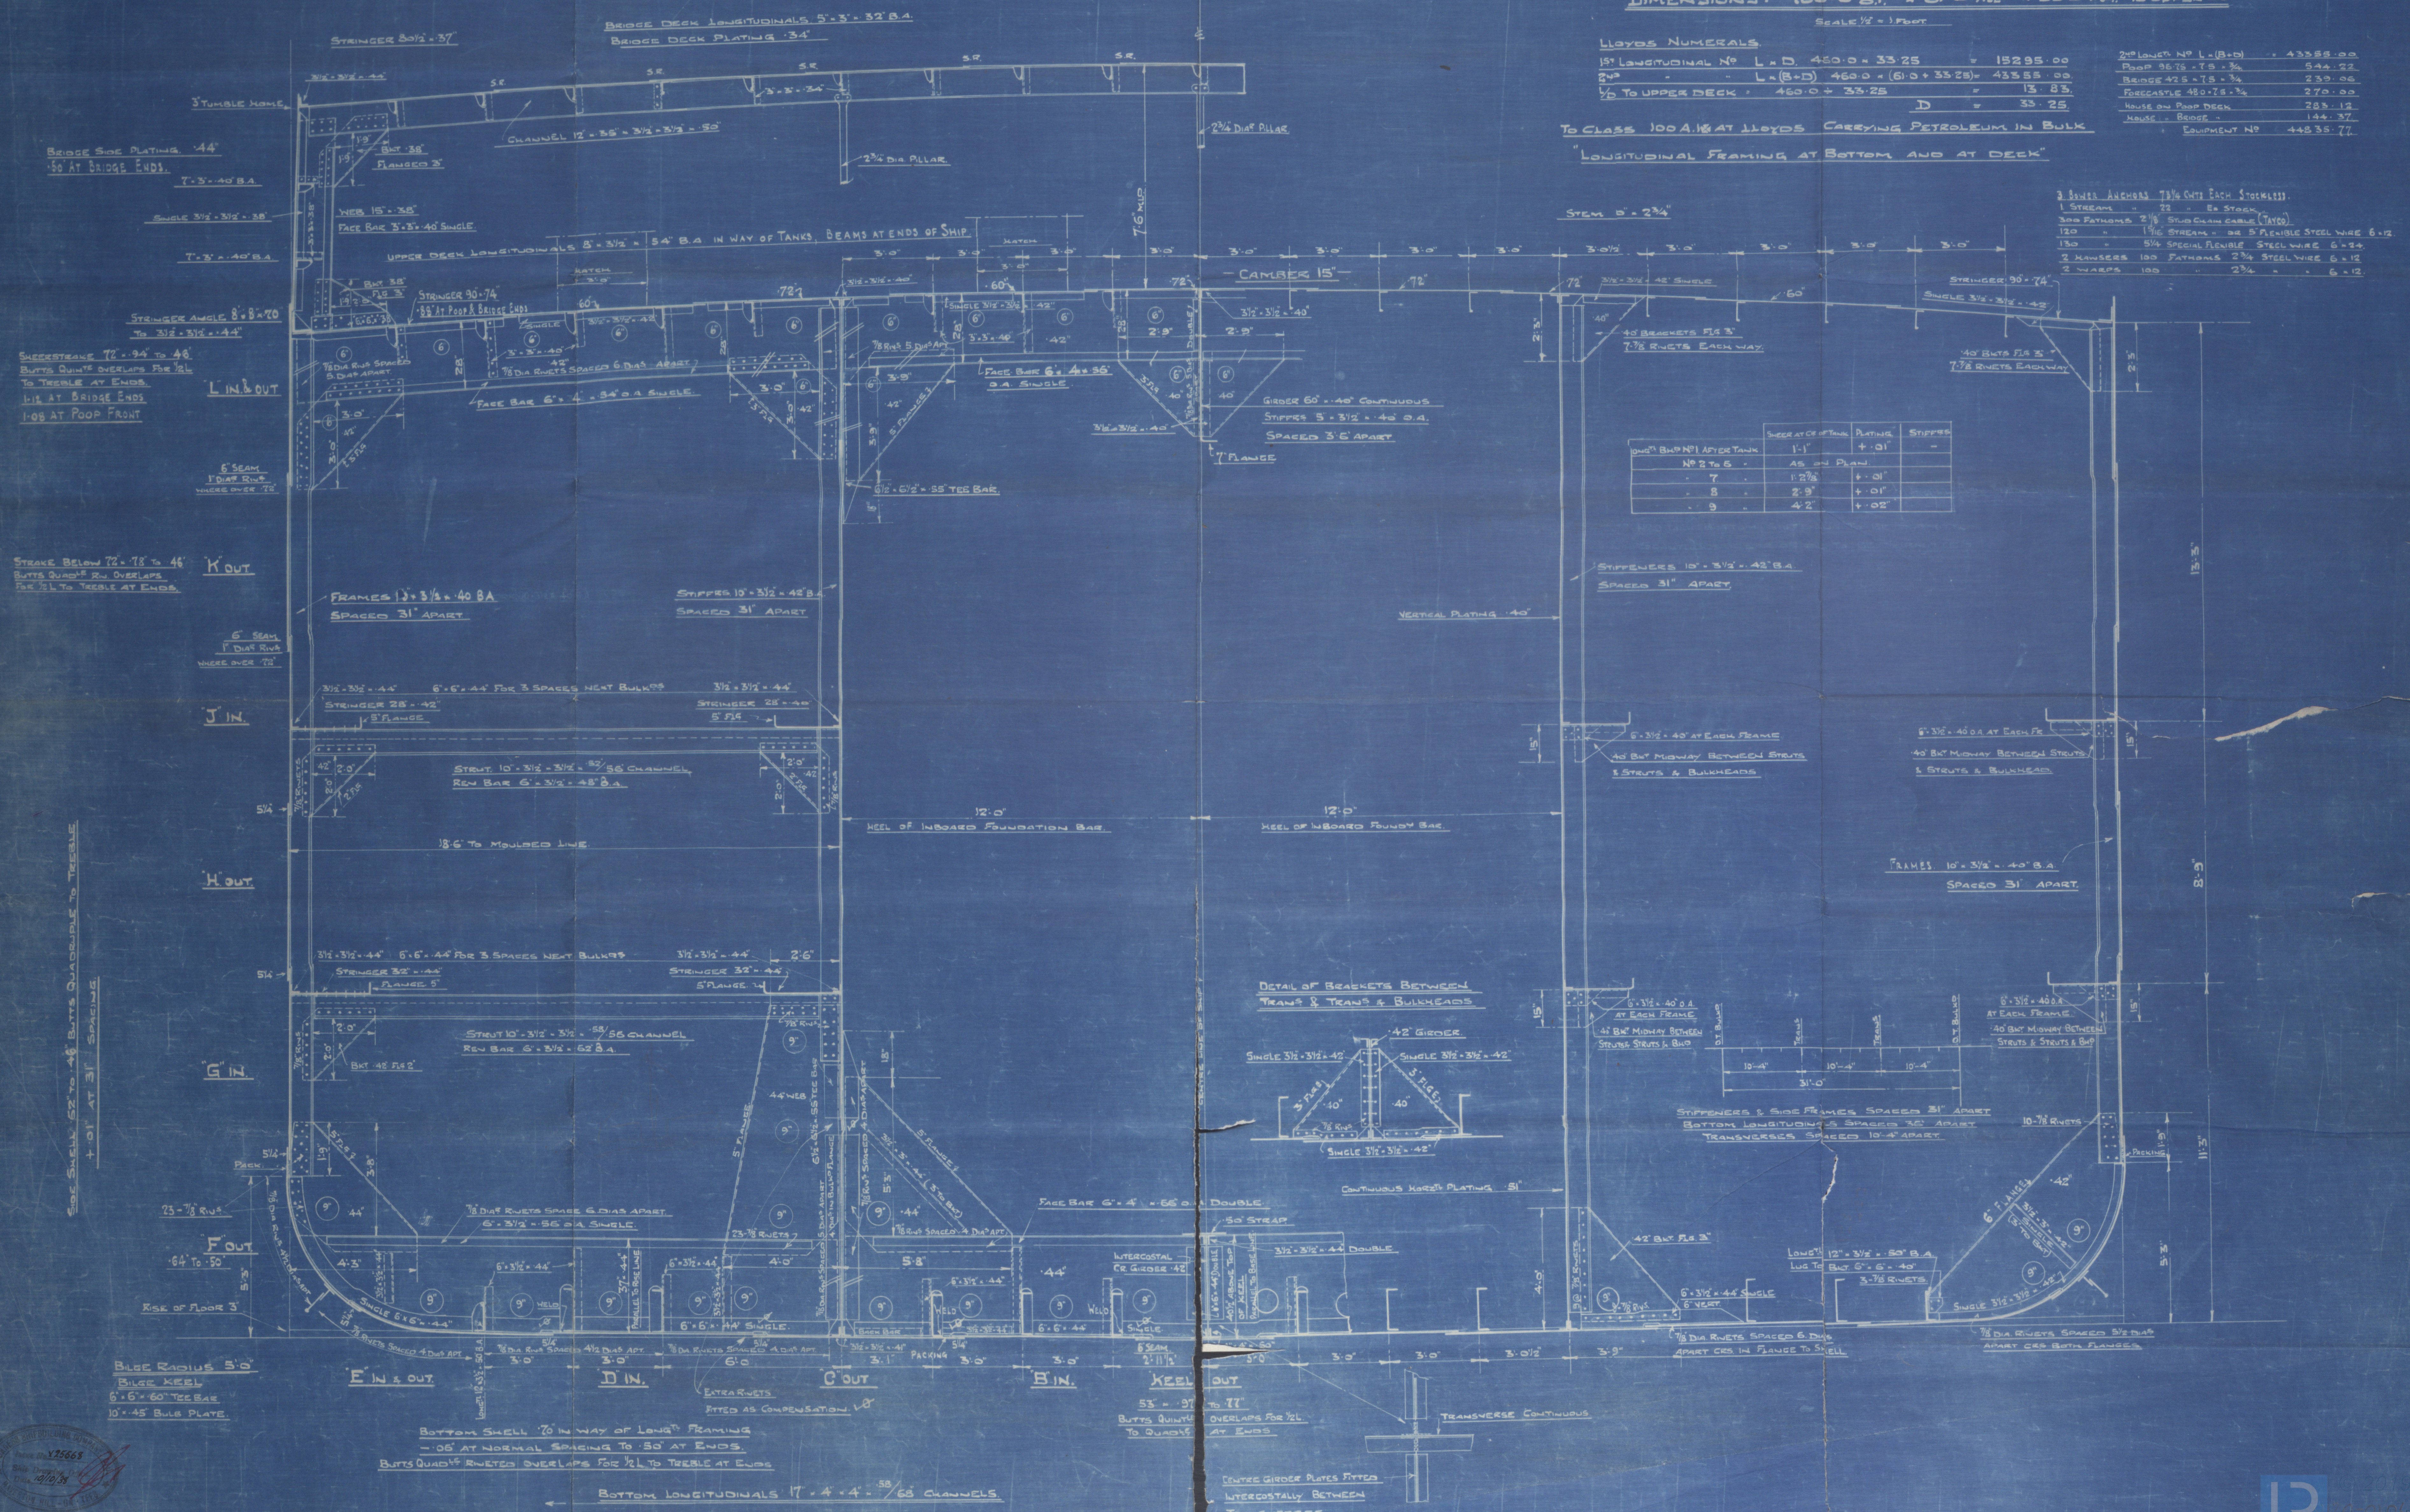

NO. OF BULKHEADS AFTER TANK	SPACING OF BULKHEADS	PLATING	STIFFERS

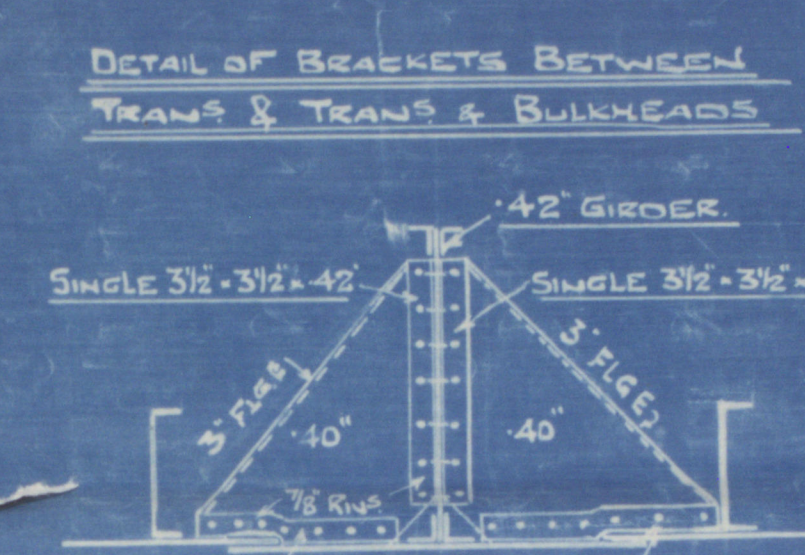

STIFFENERS & SIDE FRAMES SPACED 31" APART
BOTTOM LONGITUDINALS SPACED 31" APART
TRANSVERSERS SPACED 10'-4" APART

CENTRE GIRDER PLATES FITTED INTERCOSTALLY BETWEEN TRANSVERSERS




MESSRS

FURNESS S. B. CO^{LTD}

N^o 283

MIDSHIP SECTION

AS. BUILT.

 SAN DELFINO

MIDDLESBROUGH

RPT N^o 16438

W120-0104

4
17



© 2019

Lloyd's Register
Foundation