


11 FEB 1938

5124 MM ENC. N^o 3831.
5085 " " 3832
5102 " " 3833 } ACTUAL LENGTHS FROM SHIP

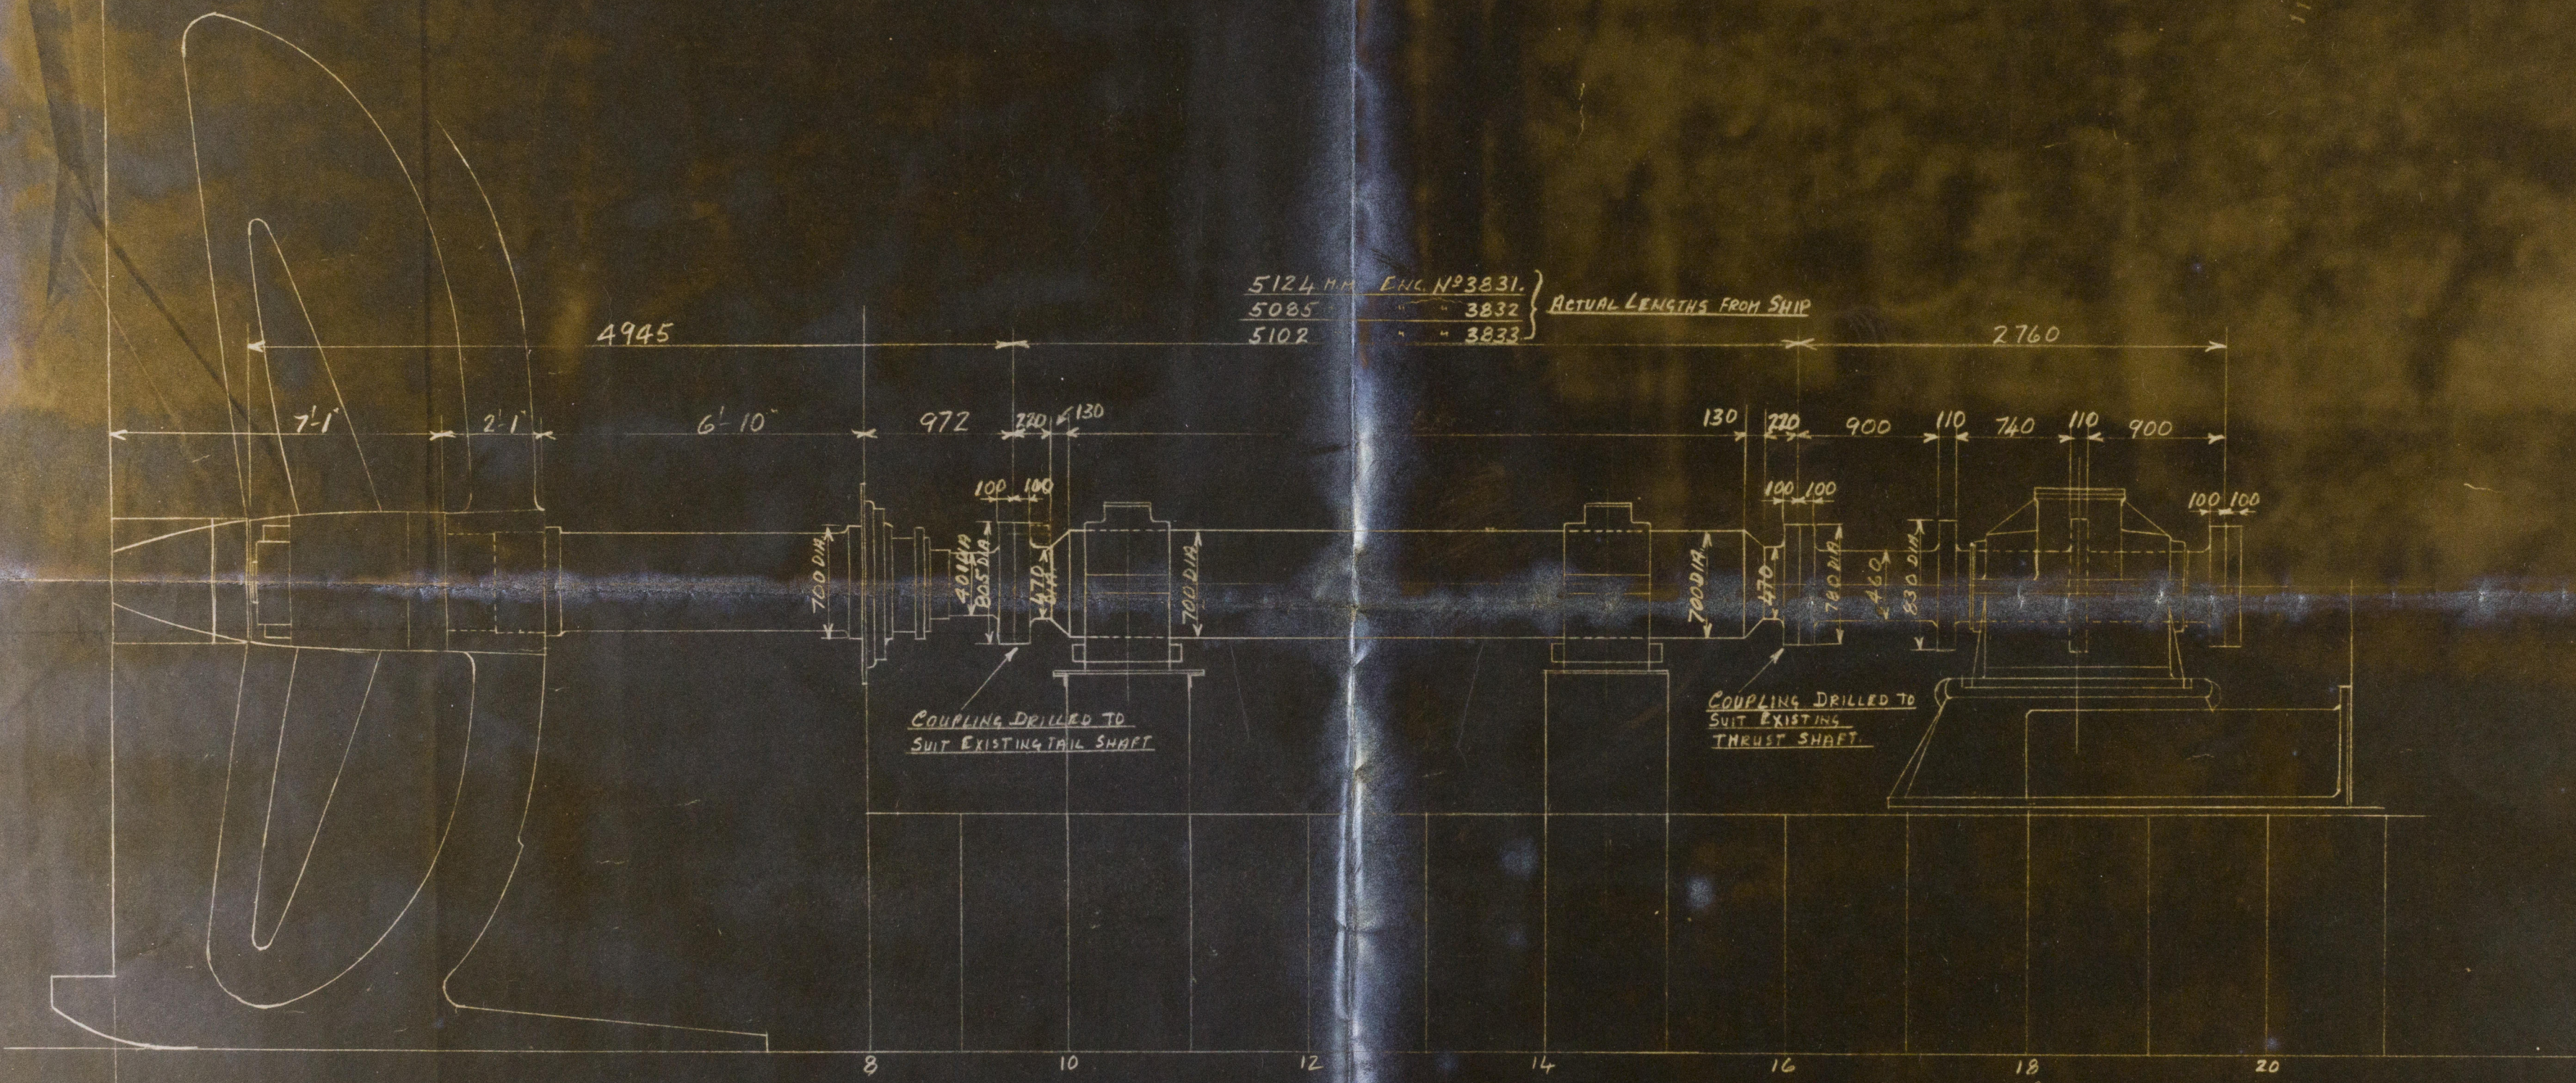

PROPOSED MODIFIED SHAFTING ARRANG^T
SCALE $\pm \frac{1}{25}$.

ENGINE N^{os} 3831-2-3
ORDER N^o 1057.

18/1/38



Lloyd's Register
Foundation

9010-02100
10170-0106

W120-0106

"San Delfino"
Tanner

738

2d 3

"San Delfino". Mal. 16438
Shafting arrangement.

Prop shaft

W120-0106



© 2019

Lloyd's Register
Foundation