
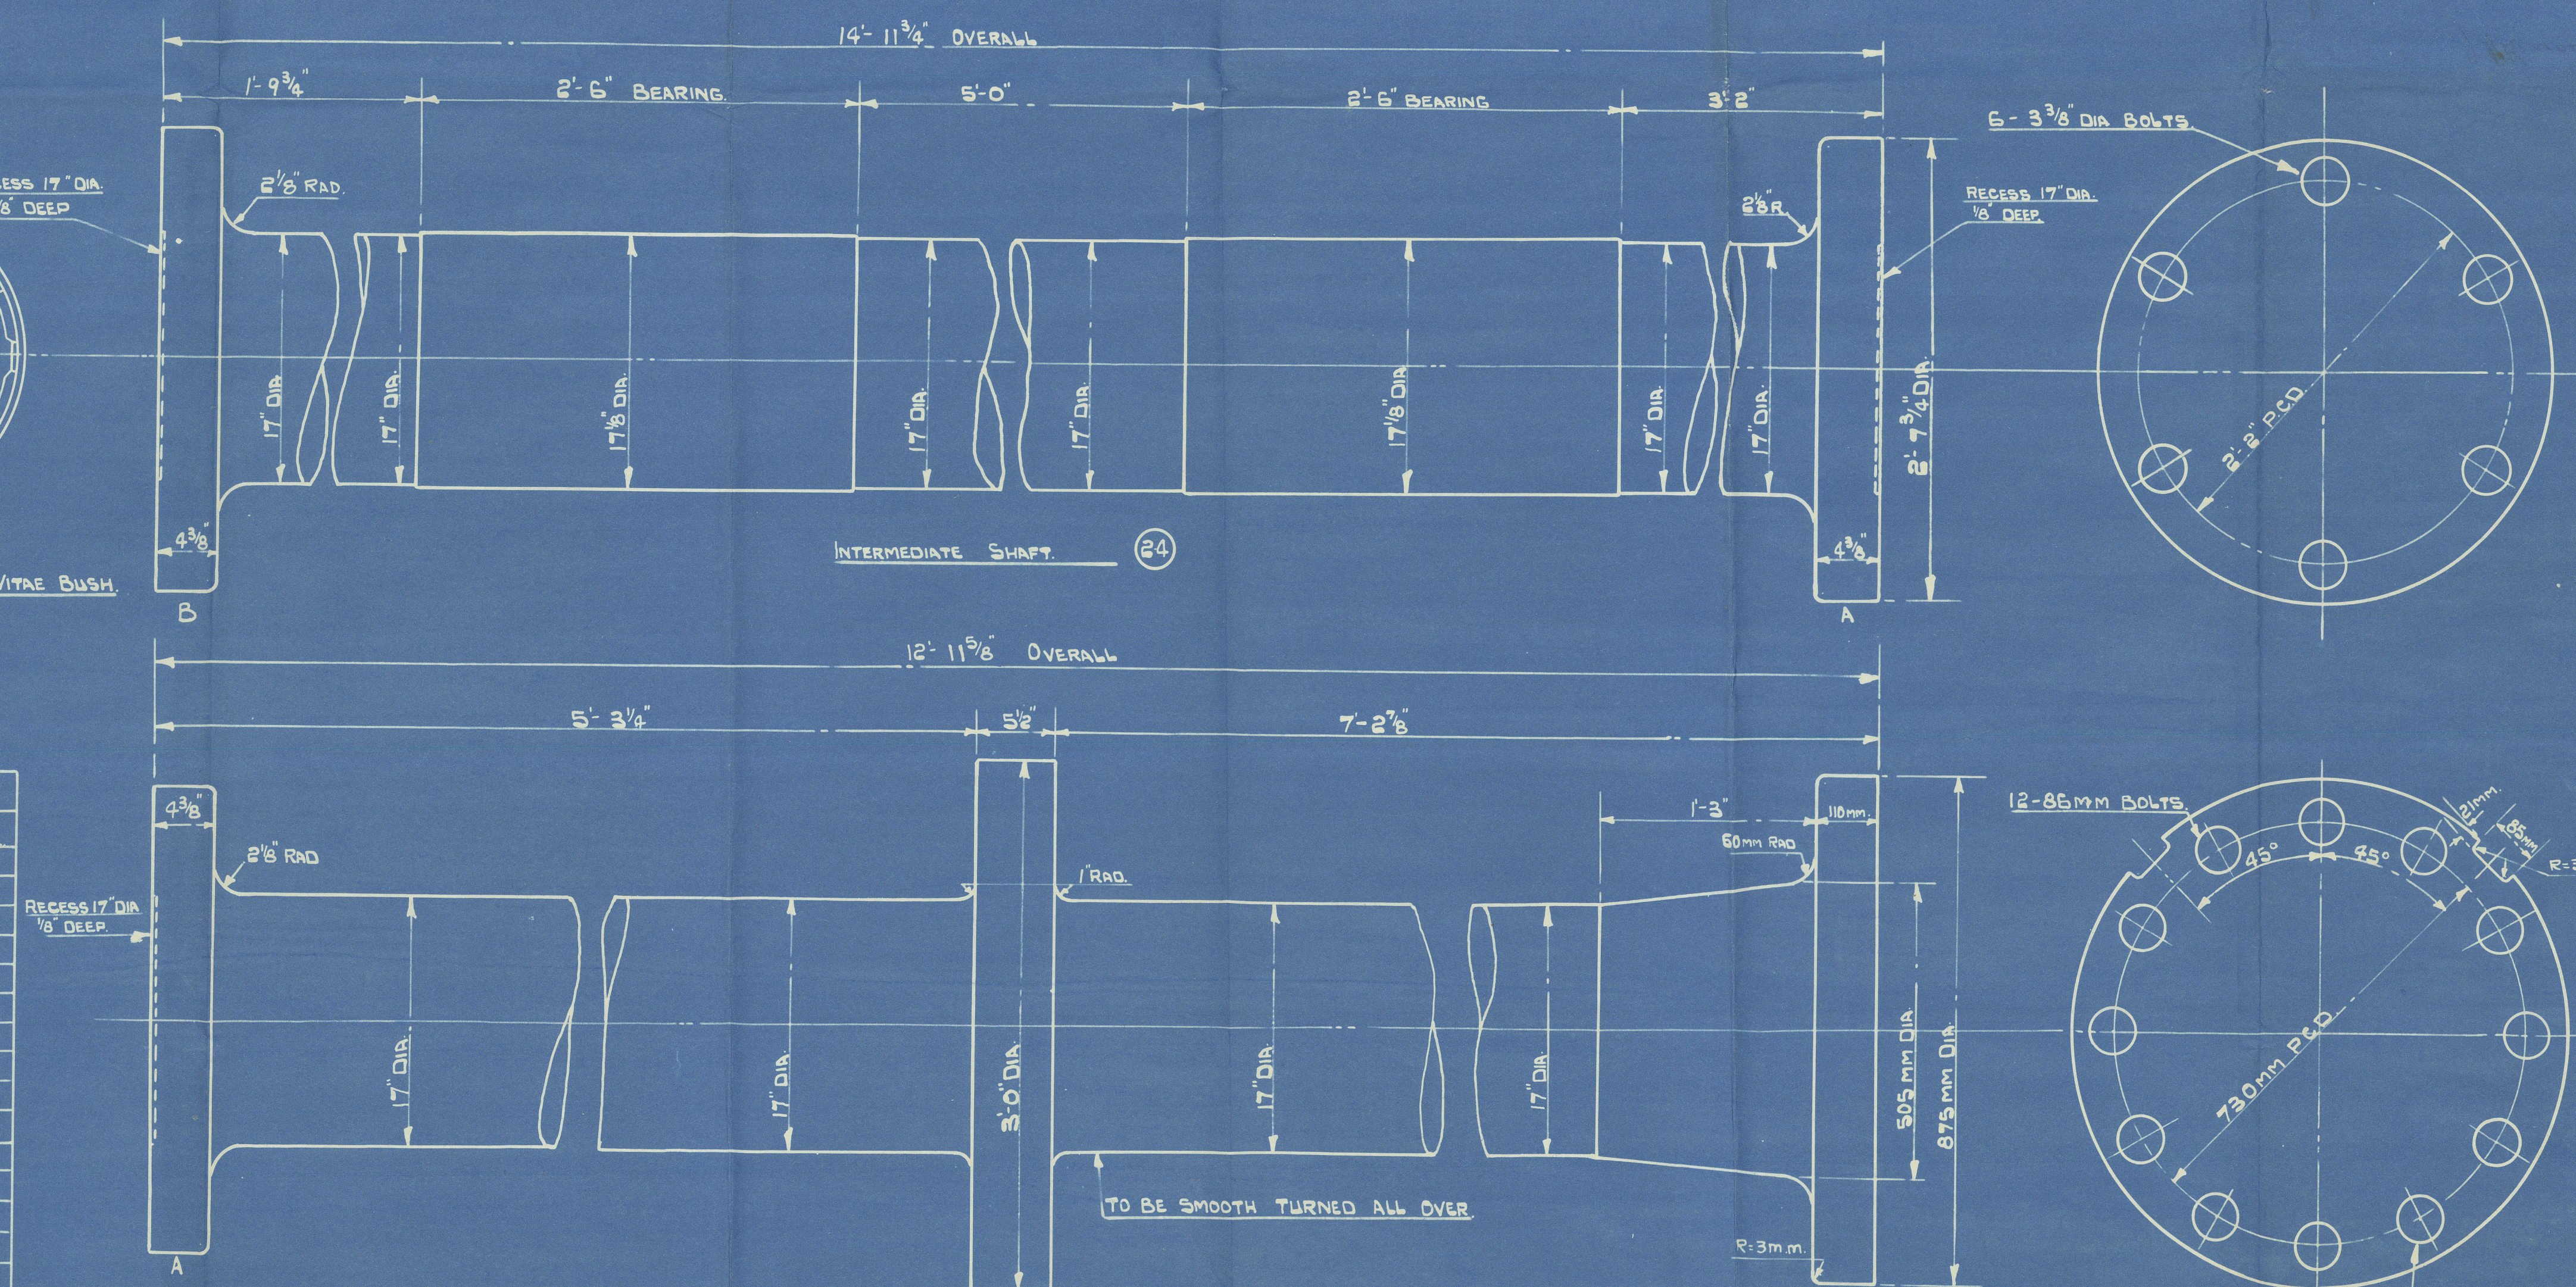


23 OCT 1937

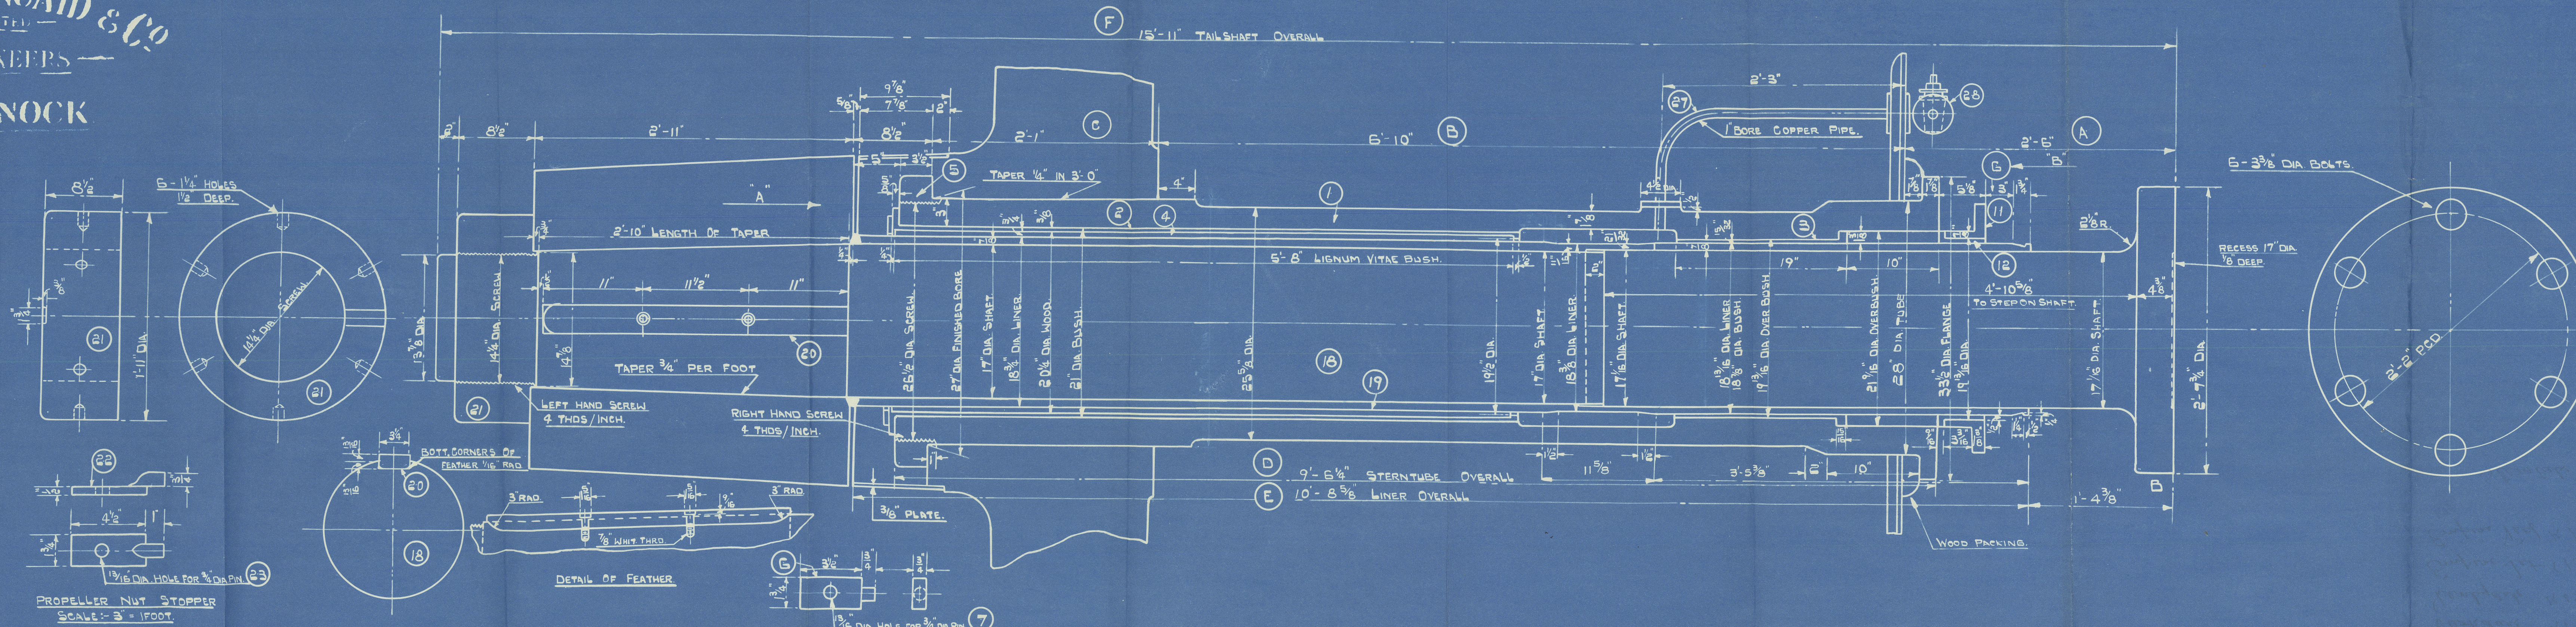

MARK	COST	DESCRIPTION	MATERIAL	N <sup>o</sup> OFF
1	8	STERN TUBE	CAST IRON	WORKING SPARE
2		" AFT BUSH	CUNIPMETAL	
3		" FORG "	"	
4		" WOOD LINING	LIGNUM VITAE	
5		" NUT	STEEL	
6		" STOPPER	"	
7		" " PIN	"	
8		" AFT BUSH PIN	BRASS	8
9		" GUNNARD RING	"	
10		" " PIN	"	8
11		" GUNNARD	CAST IRON	
12		" BUSH	BRASS	
13		" STUD	MUNIZMETAL	5
14		" NUT	BRASS	5
15		" BUSH STRAP	"	
16		" " PIN	"	7
17		" FLANGE BOLTS	STEEL	10
19		" LINER	CUNIPMETAL	
20		" FEATHER	STEEL	
21		" NUT	WROTH IRON	
22		" STOPPER	STEEL	
23		" " PIN	"	
24		INTERMEDIATE SHAFT	SEWING MACHINE	
25		SHAFT COUPLING BOLT	STEEL	12
26		" NUT	WROTH IRON	12
27		STERN TUBE WATER SERVICE PIPE	COPPER	
28		" " COCK	BRASS	
29		RUBBER RING	RUBBER	
30		THRUST SHAFT	SEWING MACHINE	
31		ROPE GUARD	STEEL	2 HALVES

ENC. N <sup>o</sup>	A	B	C	D	E	F	G	DATE
K131								
K132								
K133								
K134								

STERNTUBE & SHAFTING.  
ENC N<sup>os</sup> K131-2-3-4  
SCALE: 1" = 1 FOOT & AS MARKED.  
M. V. N<sup>os</sup> 61-2-3-4  
6<sup>th</sup> OCTOBER 1937

DRG. N<sup>o</sup> 11618



J. J. Keneally, C. Rly S.B.C.

Darkeale K131 61

GRK. REPORT NO. 21159.

Darkeale K132 62

GRK. REPORT NO. 21284.

Empire Jet K133 63

GRK. REPORT NO. 21546

Empire Jet K134 64

GRK. REPORT NO. 21666.

\* N.N. "Norland" Gls. 64740.

Stern tube & shafting

PETAIN

© 2021  
W1200-0082

Lloyd's Register  
Foundation