


ALL STIFFENERS $8' \times 8\frac{1}{2}'' \times 5\frac{1}{2}''$ EXCEPT THREE MARKED 'A' WHICH ARE $8' \times 8\frac{1}{2}'' \times 6''$ ON FWP MATCH ONLY

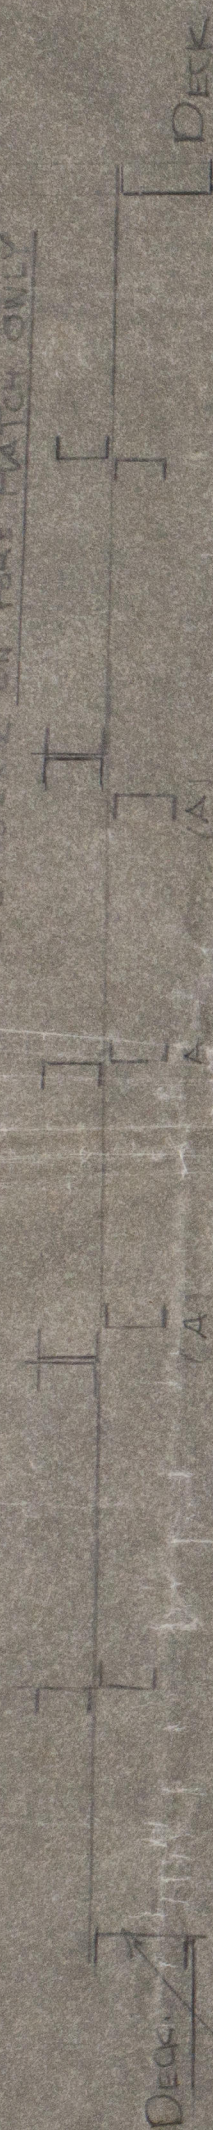

SECTION

12 x 4 x 4 x 18 channels

AFT

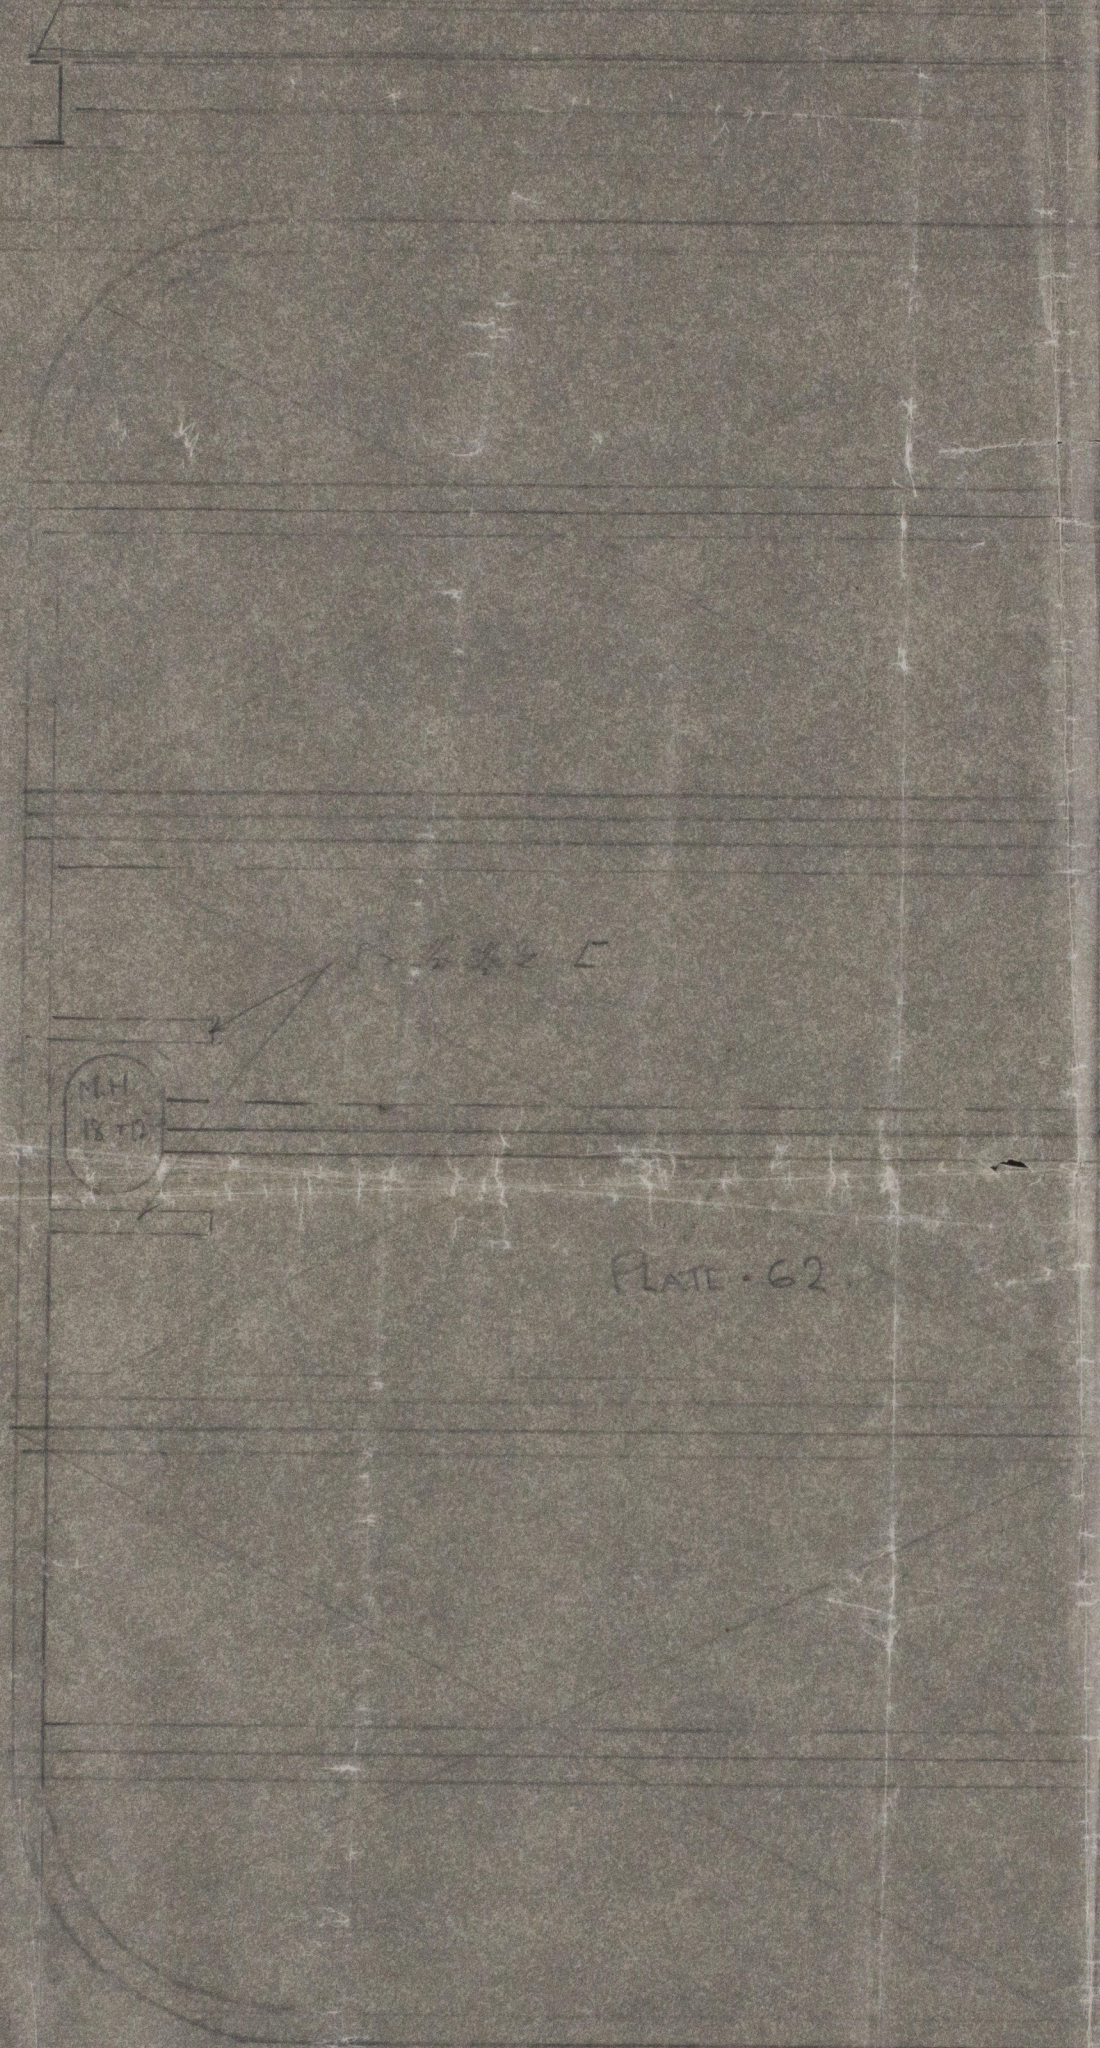


PLATE - 62



PLATE - 62

TANK LIDS
(AS FITTED)

S/S NEW COLUMBIA AS FITTED OCT 1930

SCALE $\frac{1}{2}'' = 1$ FOOT



© 2021
Lloyd's Register
Foundation
W1200-0141

W1200-0141

TANK LIDS
(AS FITTED)
S.S. / NEW COLUMBIA



© 2021

Lloyd's Register
Foundation