

FREEBOARD PARTICULARS.		
LENGTH ON LOAD LINE.		393' 11"
DEPTH MID. TO UPPER DECK.		30' 6"
FREEBOARD COEFFICIENT CORRECTION.		.78.
LENGTH OF ERECTIONS.	POOP. 37' 0" BRIDGE 128' 6" FOCLE. 39' 6"	
MEAN SHEER OVER TOTAL LENGTH.		85 1/2"
SHEER FORWARD		118 "
" AFT.		53 "
" AT 1/8 L. FROM STEM.		65 "
" " " STERN.		29 "
MEAN SHEER AT 1/8 L.		47 "

S. S. <sup>66</sup>WAYFARER. <sup>99</sup>

# PROFILE.

**N° 403.S.S.**

SCALE  $\frac{1}{8}'' = \text{ONE FOOT.}$

CLASSED 100 A.I. AT LLOYDS.



W1201-0002

N. 403.



Profile

Vessel as built

40" WAYFARER

GLASGOW REPORT No. H4960.

RENTAL YAW 2 2

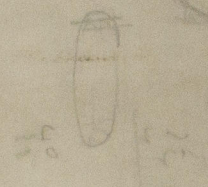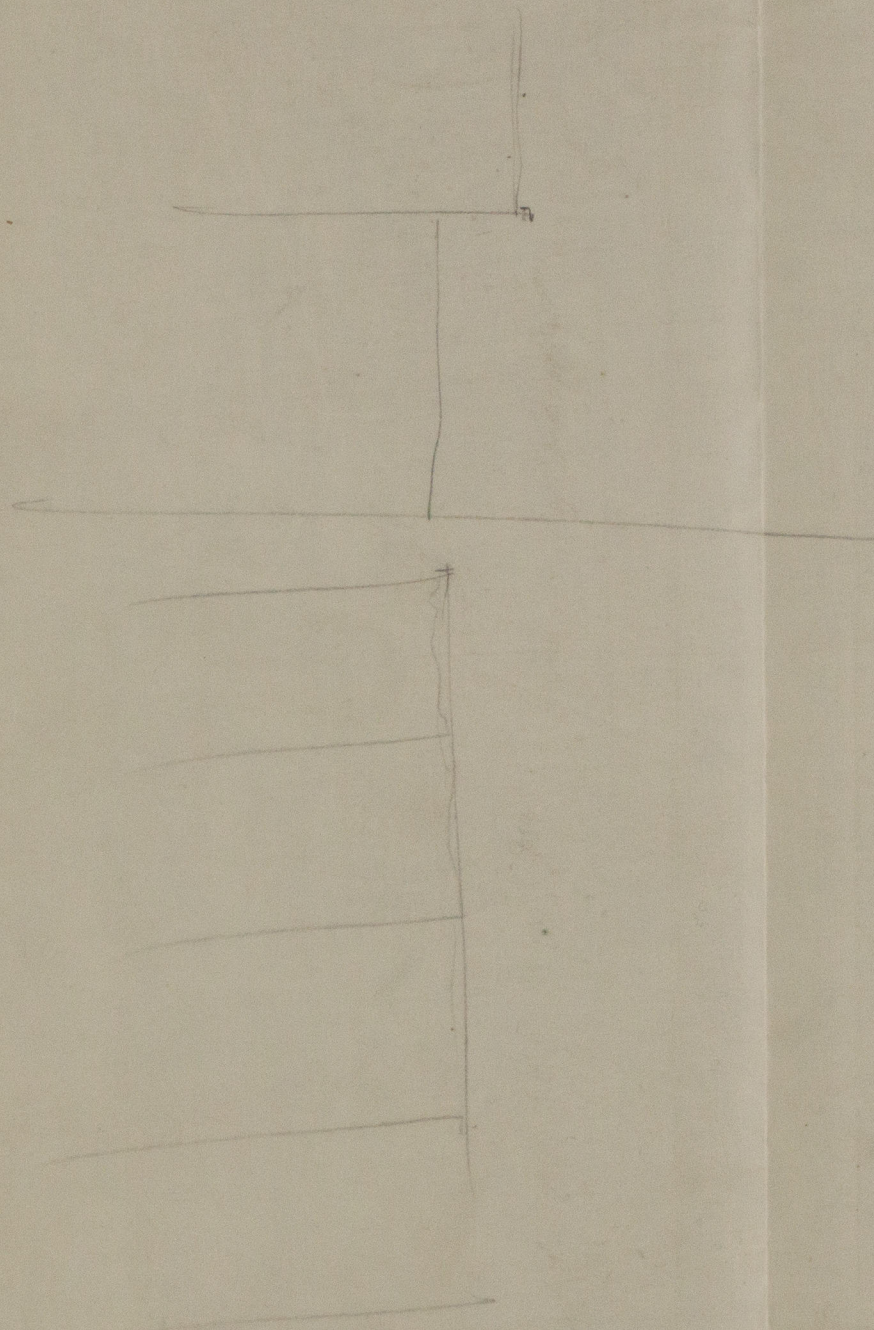

RETAIN



© 2019

Lloyd's Register  
Foundation