


# MIDSHIP SECTION

SINGLE SCREW STEAMER  
CLASS. LLOYDS 100 A.1.  
SCALE 1/2" = ONE FOOT

## DIMENSIONS.

LENGTH B.P. 164' 7"  
BREADTH M<sup>4</sup> 28' 10 1/2"  
DEPTH M<sup>4</sup> 9' to UPPER DX. 13' 2 1/2"

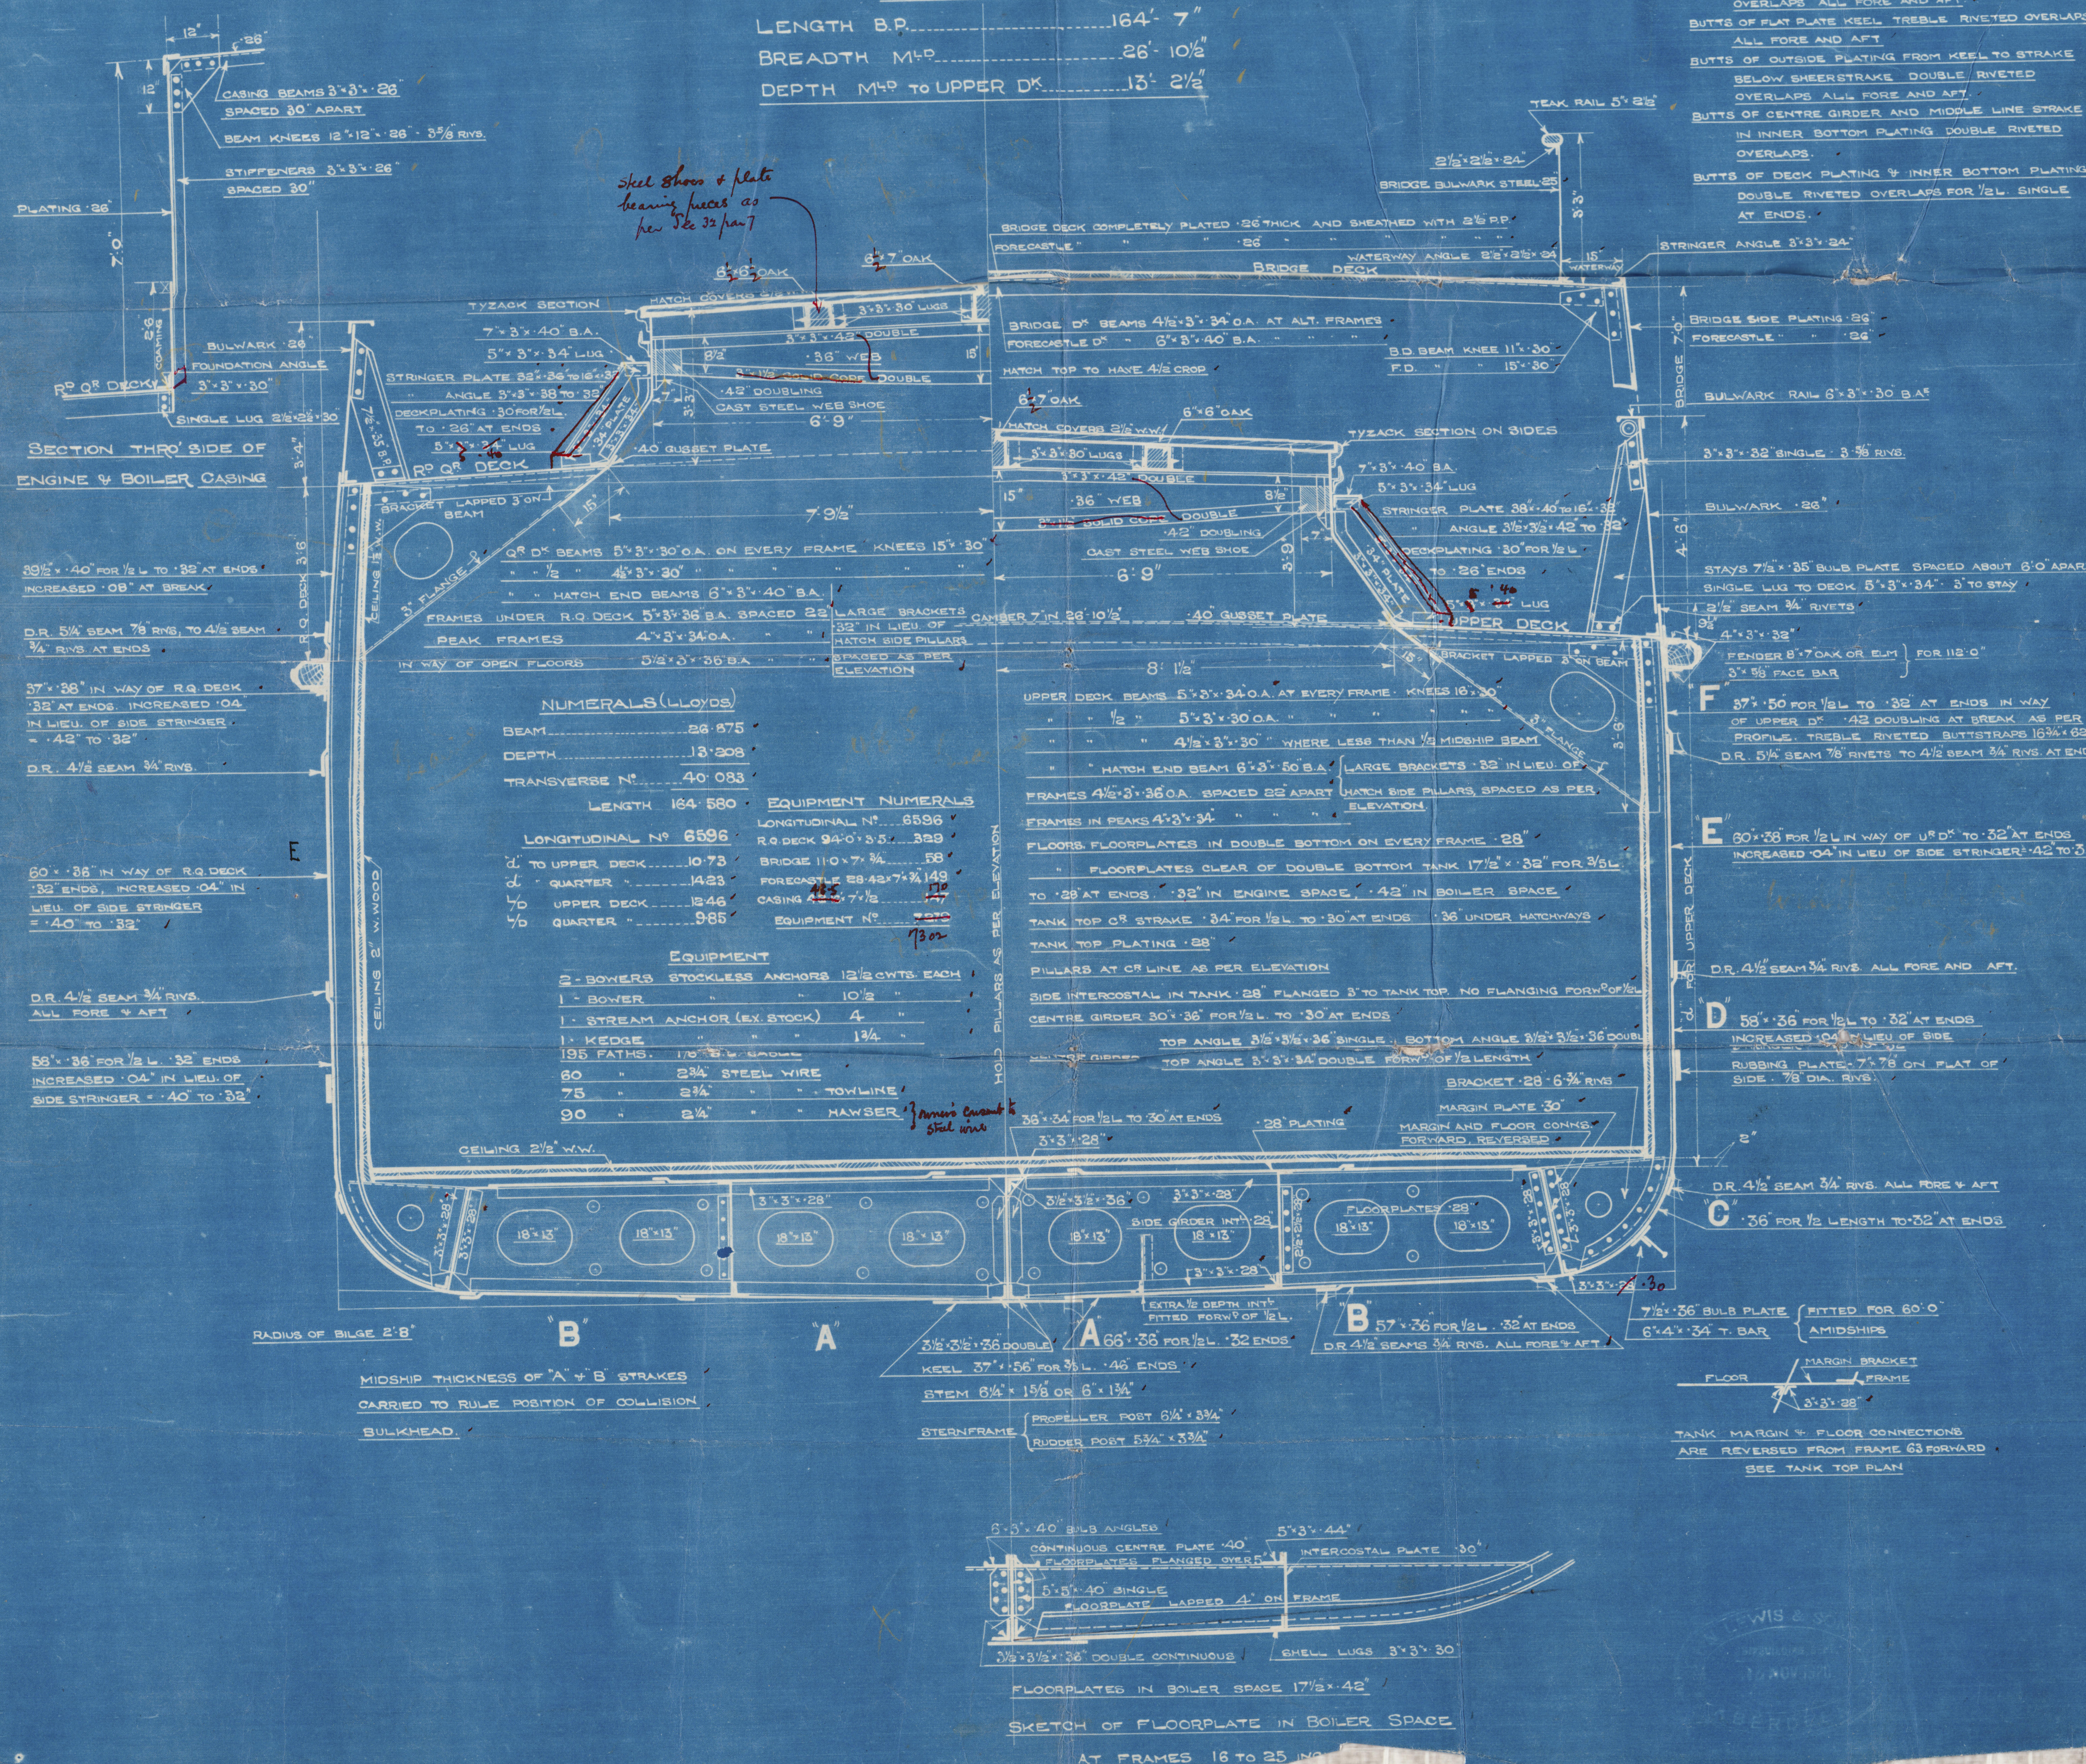


# PROFILE & DECK PLAN

SCALE: 1/8" = ONE FOOT

# YARD N° 73

BULKHEAD		SCANTLINGS	
N° OF BAY	BOUNDARY ANGLE	LOWER PLATE	UPPER PLATE
4 W.T.	5' 6" x 48"	20' - 26"	5 1/2" x 40" O.A.
28 W.T.	5' 6" x 40"	40"	26' - 26"
78 W.T.	5' 6" x 48"	48"	28"
FORE PEAK W.T. PLAT.		BEAMS 4' 8" x 36"	KNEES 11' x 30"

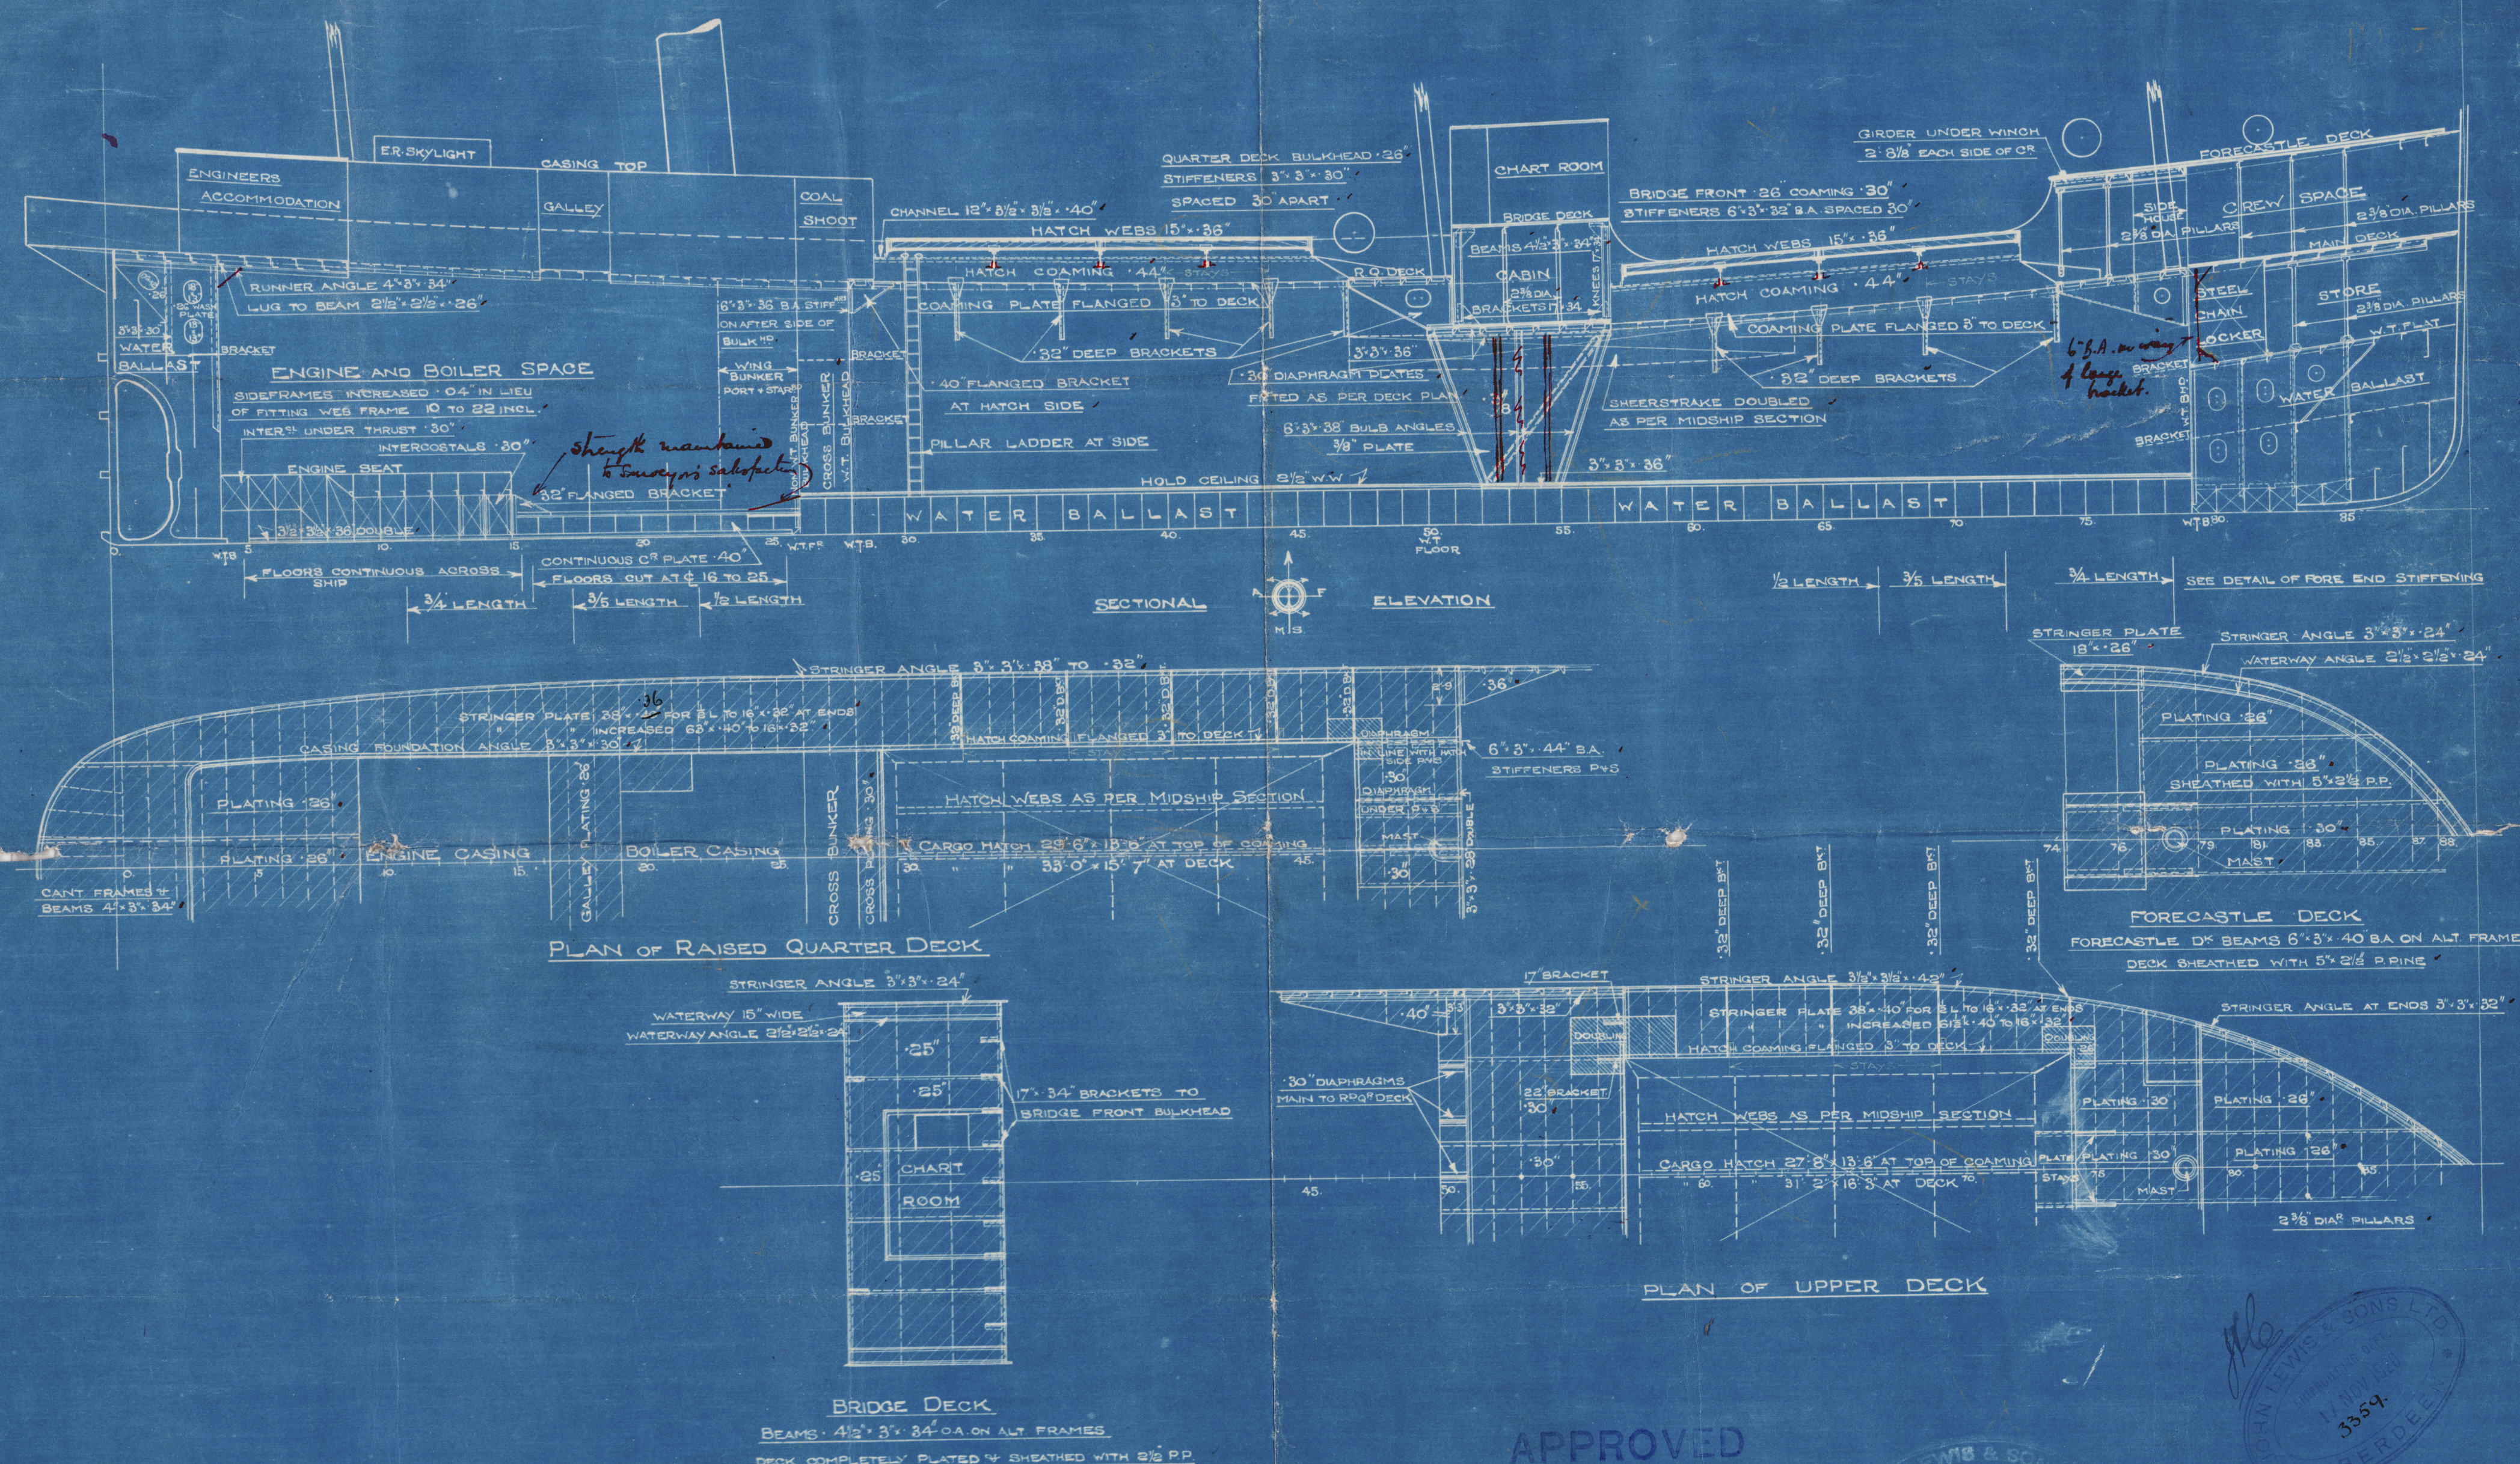

LLOYD'S REGISTER  
18-11-20  
REGISTERED  
OF SHIPPING

RULE SIZE	ITEM	SCANTLING	PROPOSED SUBSTITUTE
R 2 1/2" DE FRAMES 5-8		5 1/2" x 36" S.A.	5 1/2" x 36" S.A.
" " " 10-22		5 1/2" x 36" S.A.	5 1/2" x 40" S.A.
" " " 23-25		5" x 36" S.A.	5 1/2" x 36" S.A.
" " " 26-50		5" x 36" S.A.	5 1/2" x 36" S.A.
UPPER DECK FRAMES		4 1/2" x 34" O.A.	4 1/2" x 30" O.A.
PEAK FRAMES		4" x 34" O.A.	4 1/2" x 30" O.A.
W.T. PLAT. BEAMS		4" x 34" S.A.	4 1/2" x 30" S.A.
R 1/2" DE HALF BEAMS		4 1/2" x 30" O.A.	5" x 30" O.A.

APPROVED  
LLOYDS REGISTER OF SHIPPING  
29.11.20

W1202-005

Ship No. 73  
Drawing No. 1  
13th Nov. 1920  
Lloyd's Register Foundation

MESSRS J. LEWIS & SONS LTD  
MIDSHIP SECTION. PROFILE AND  
DECK PLANS.

Nº 73. S.S. "ANNAGHER"

ABN. REPORT Nº = 13390.

RETAIN



© 2019

W1202-0081  
Lloyd's Register  
Foundation