



STEEL SINGLE SCREW TUG N<sup>o</sup> 1236. 4/207

DIMENSIONS 71'-0" BP x 18'-0" M<sup>o</sup> x 9'-1" M<sup>o</sup>


TO CLASS 100 A "FOR TOWING PURPOSES"

LLOYDS NUMERALS. TRANS N<sup>o</sup> 2708. LONG N<sup>o</sup> 1922.

23.2.14  
31.7.14 (No. 1237)

SCALE  $\frac{3}{8}$ " = 1 FOOT

DRAWING N<sup>o</sup> 6740.

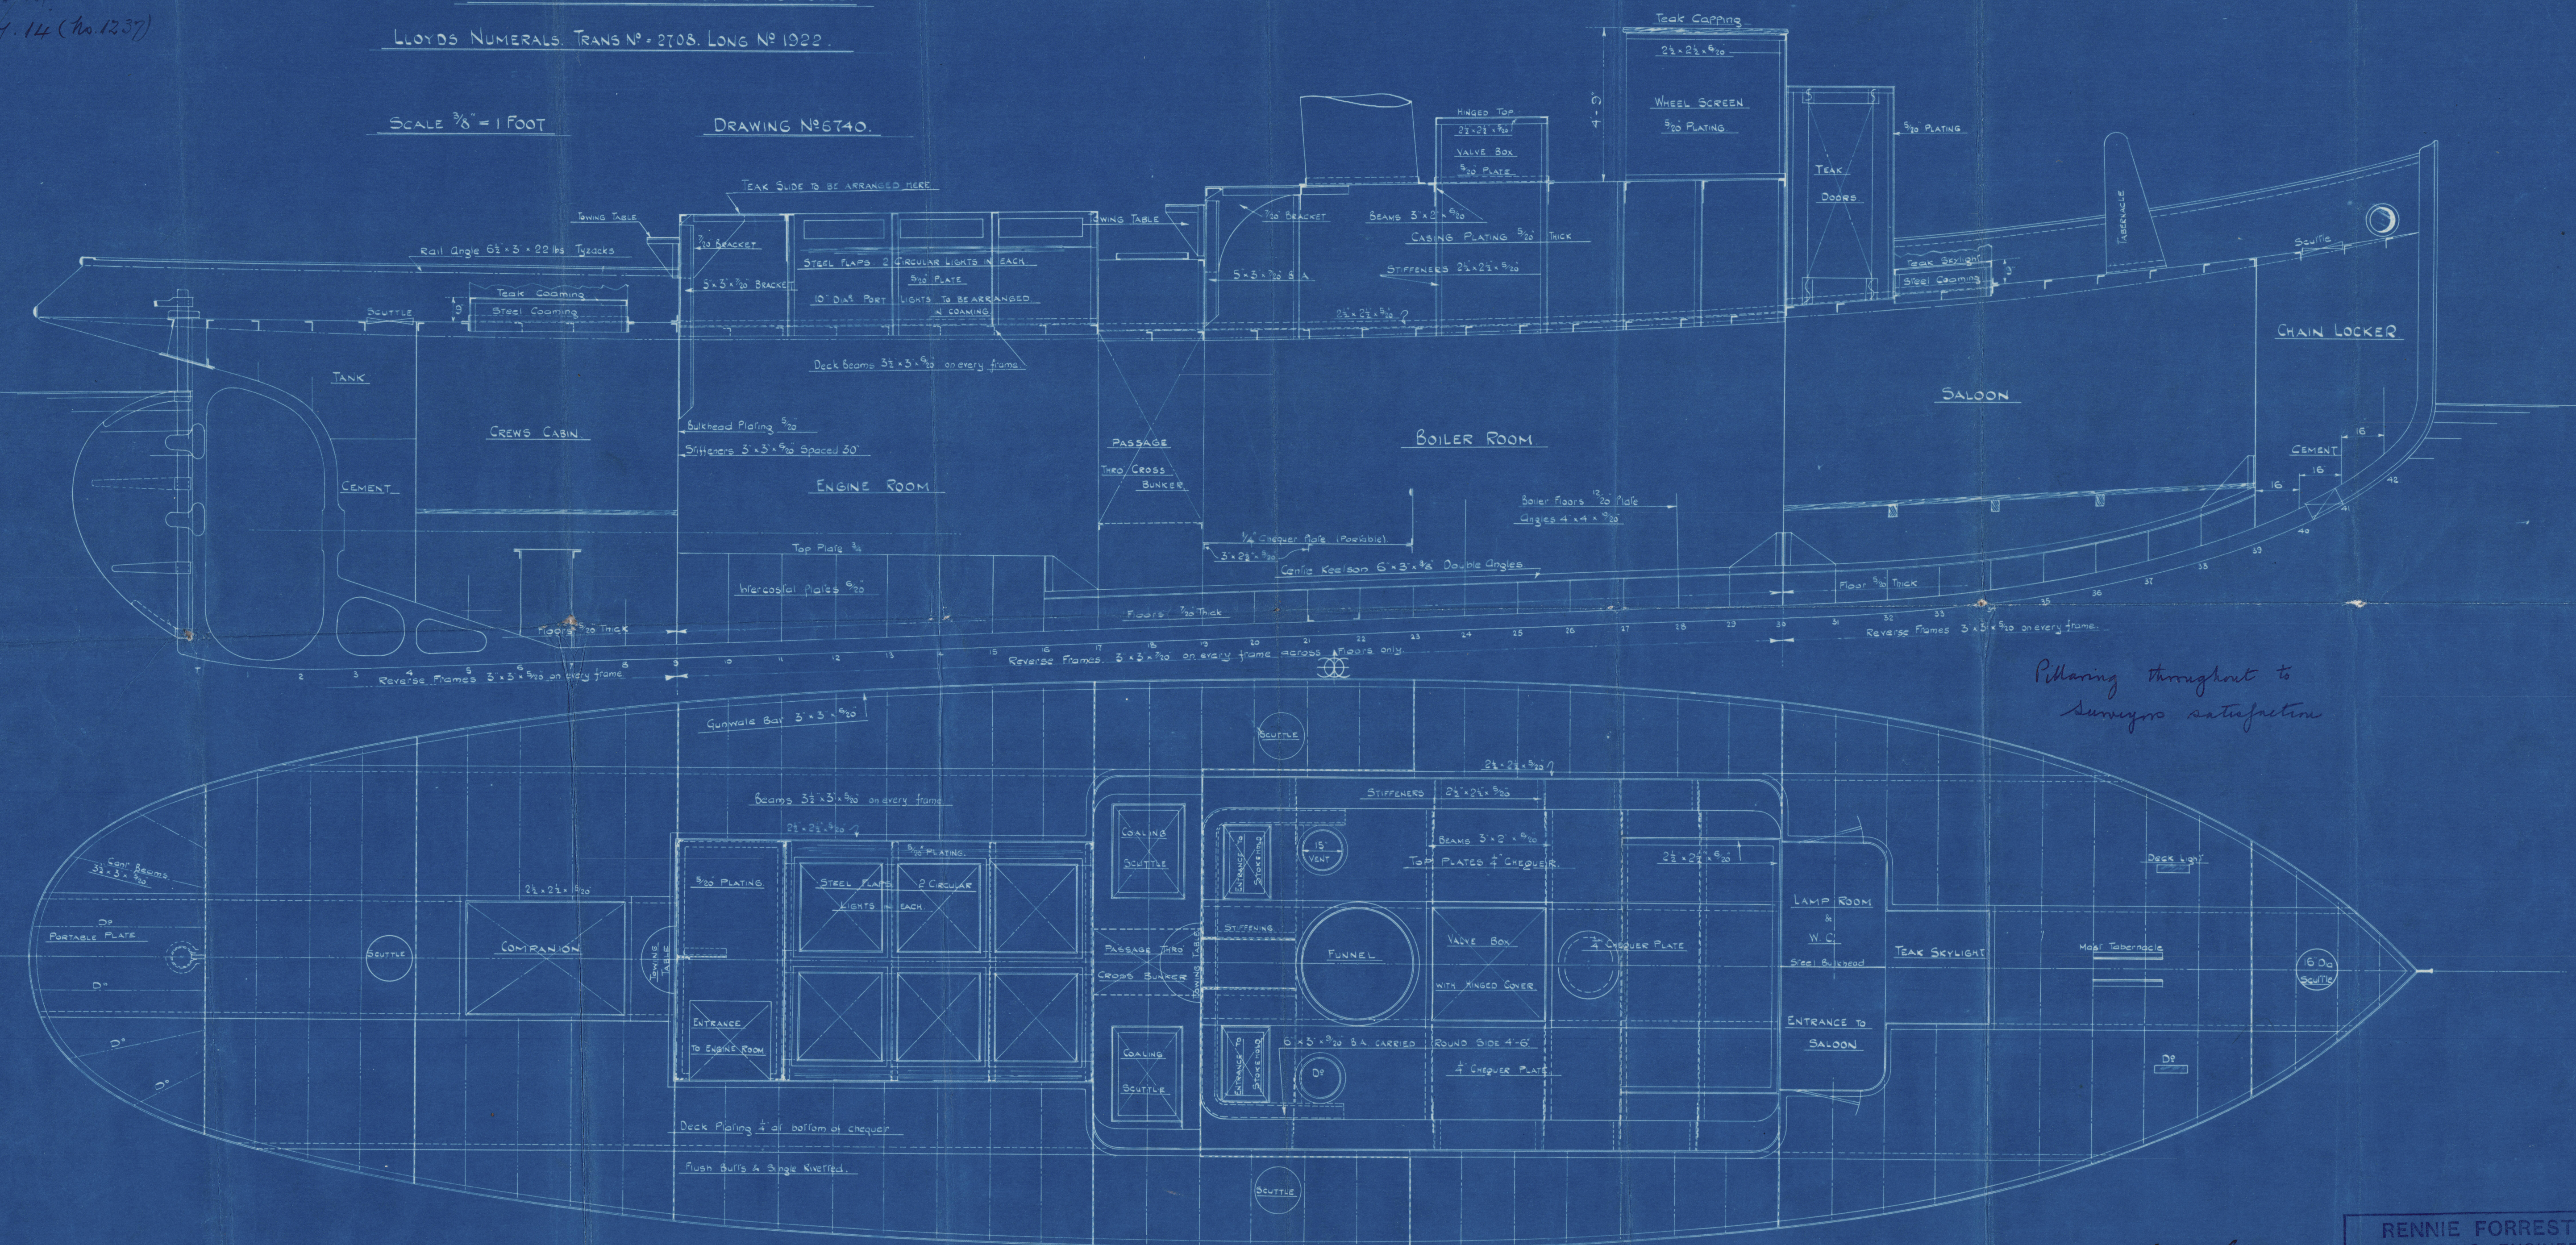

*Pillaring throughout to  
surveyors satisfaction*

*B.F.*  
23.2.14.

RENNIE FORRESTT  
SHIPBUILDING, ENGINEERING  
AND  
DRY DOCK Co., Ltd.  
Works:- WYVENHOE, ESSEX.  
London Offices:- 716-717, SALISBURY HOUSE,  
LONDON WALL, E.C.



W1202-0223



1236

1237

Profile




s/s 'Brazy

Row. 77152

S.S. 'Tenacity'

Lon 77270.

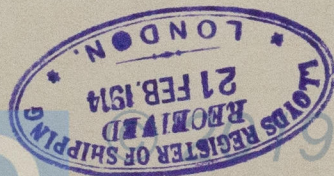

RETAIR



Lloyd's Register  
Foundation

W1202-0223