
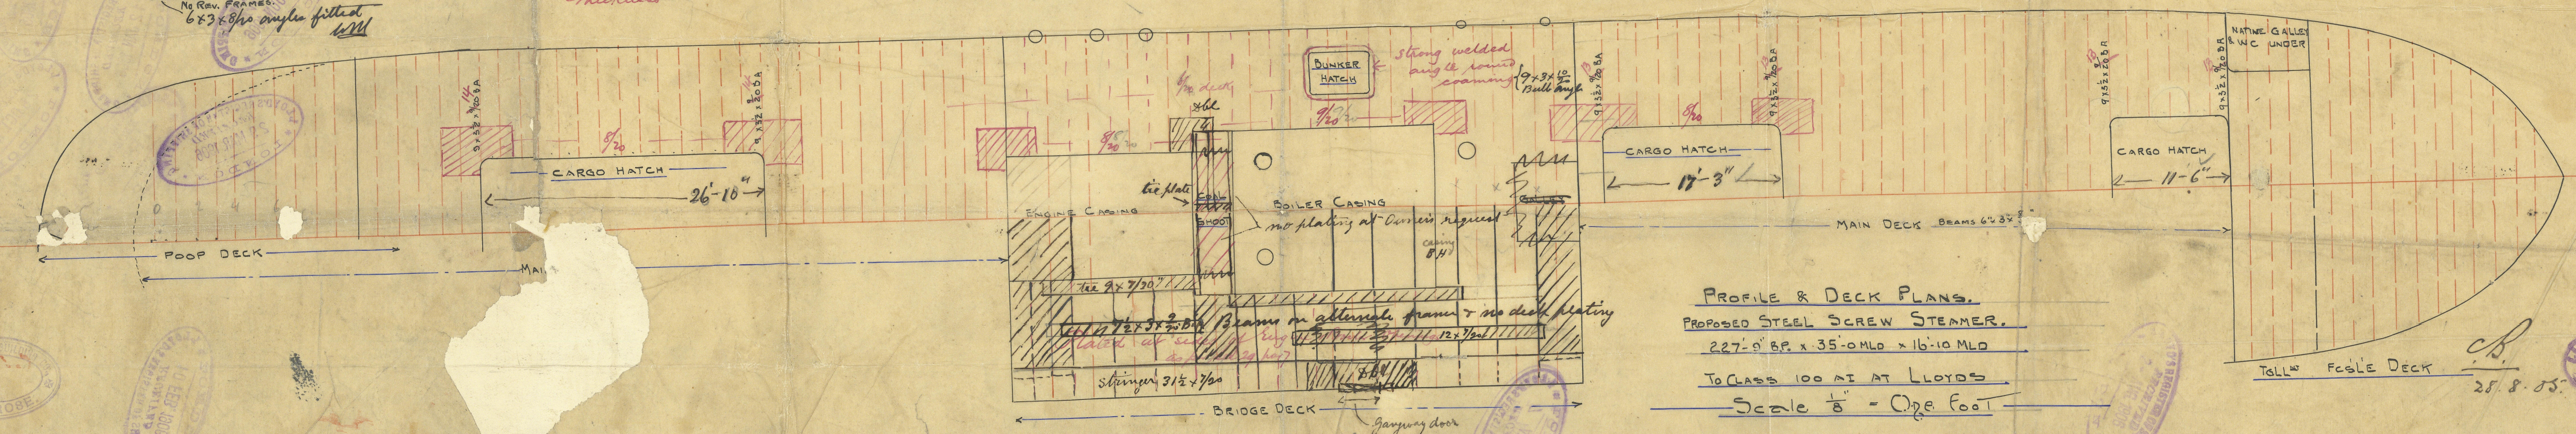


28.8.05
30.10.05
12.1.06
6.2.06
10.2.06
22.2.06
24.4.06
14.5.06
19.6.06
3.8.06
29.9.06

POOP SIDE PLATING $\frac{5}{16}$ "

POOP. PILLARS $2\frac{3}{4}$ " DIA.
POOP. SIDE PLATING $\frac{5}{16}$ " THICK.

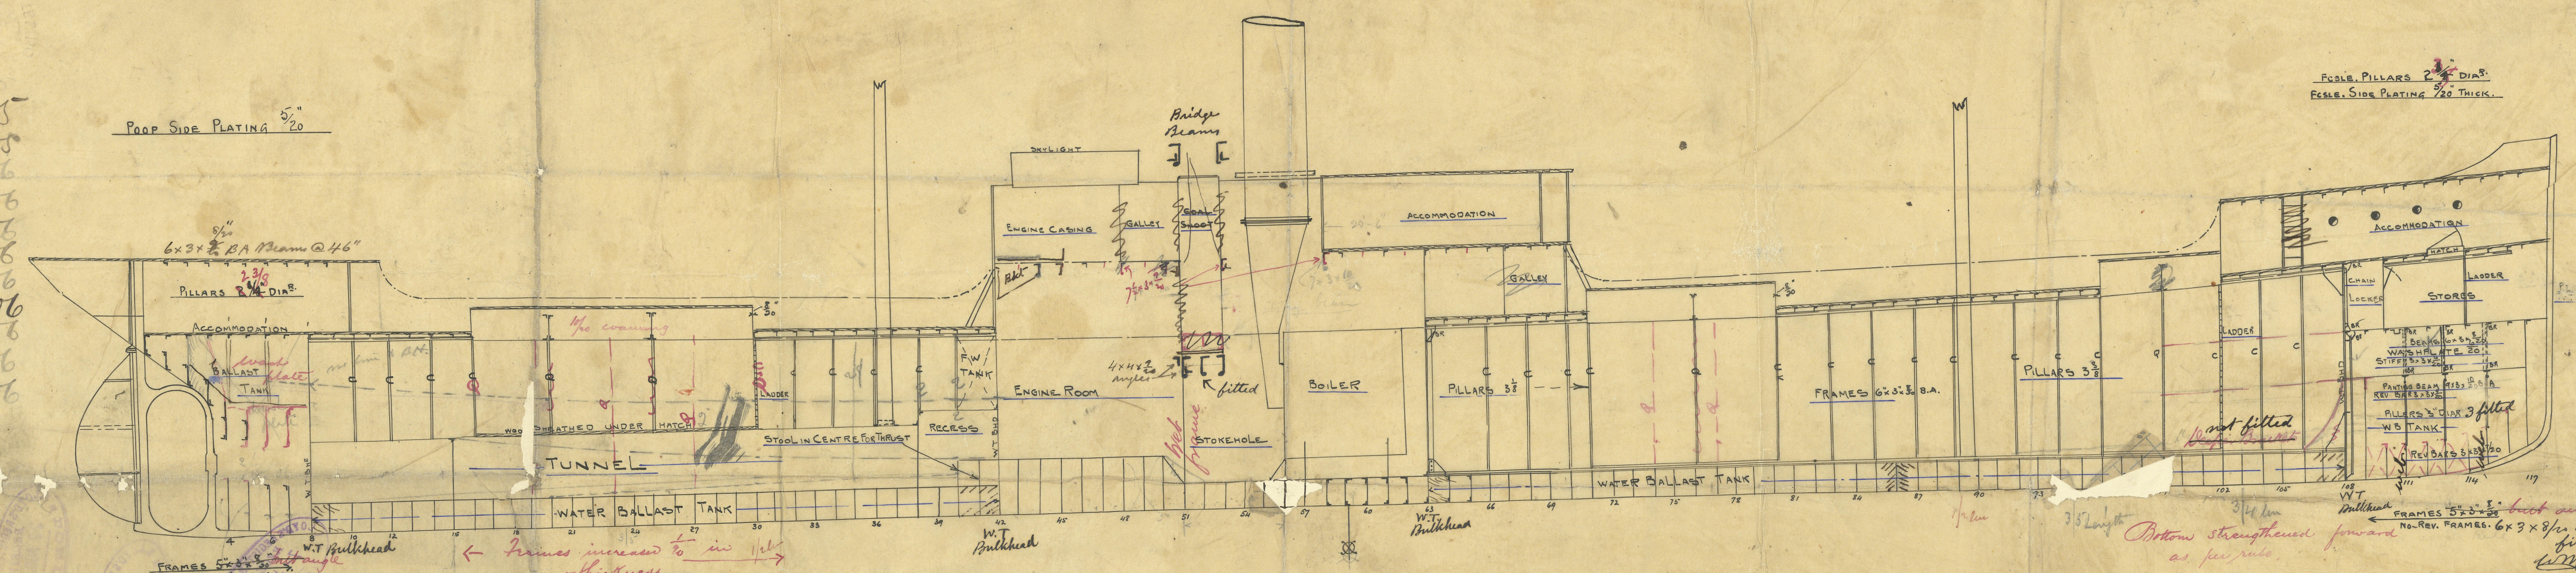

PROFILE & DECK PLANS.
PROPOSED STEEL SCREW STEAMER.
227'-9" BP. x 35'-0" MLD x 16'-10" MLD
TO CLASS 100 AT LLOYD'S
Scale $\frac{1}{8}$ " = ONE FOOT

28.8.05
LLOYD'S REGISTER
SHIPPING

Profile Plan

Montrou S. B. boy's

S. S. No 32

S. S. Ban Hong Liong

Sum Pht No 7184



LR

Lloyd's Register
Foundation

W1202-0263