


SCALE $\frac{1}{2}$ " TO ONE FOOT.

SCALE $\frac{1}{2}$ " TO ONE FOOT.

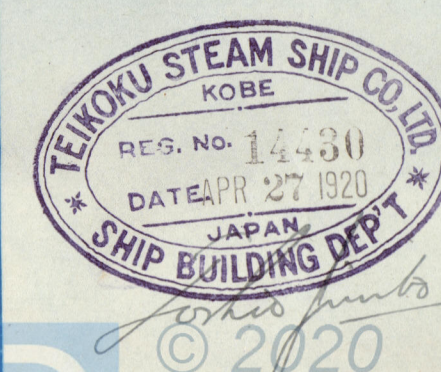

Kobe 2867

T. S.S. Form No. 48.

TOBA YARD No. 55.

Ship's Name: "DAIHO-MARU, No 1"

MIDSHIP SECTION

As finished Plan.

Rept: No.

TEIKOKU STEAMSHIP CO., LTD. KOBE, JAPAN.

RETAINLR

© 2020

Lloyd's Register
Foundation

WI 203-0083