


# NO. 55. S.S. 'DAIHO MARU, No. 1. PROFILE, DECK & INNER BOTTOM PLANS. SCALE $\frac{1}{8}$ TO ONE FOOT.



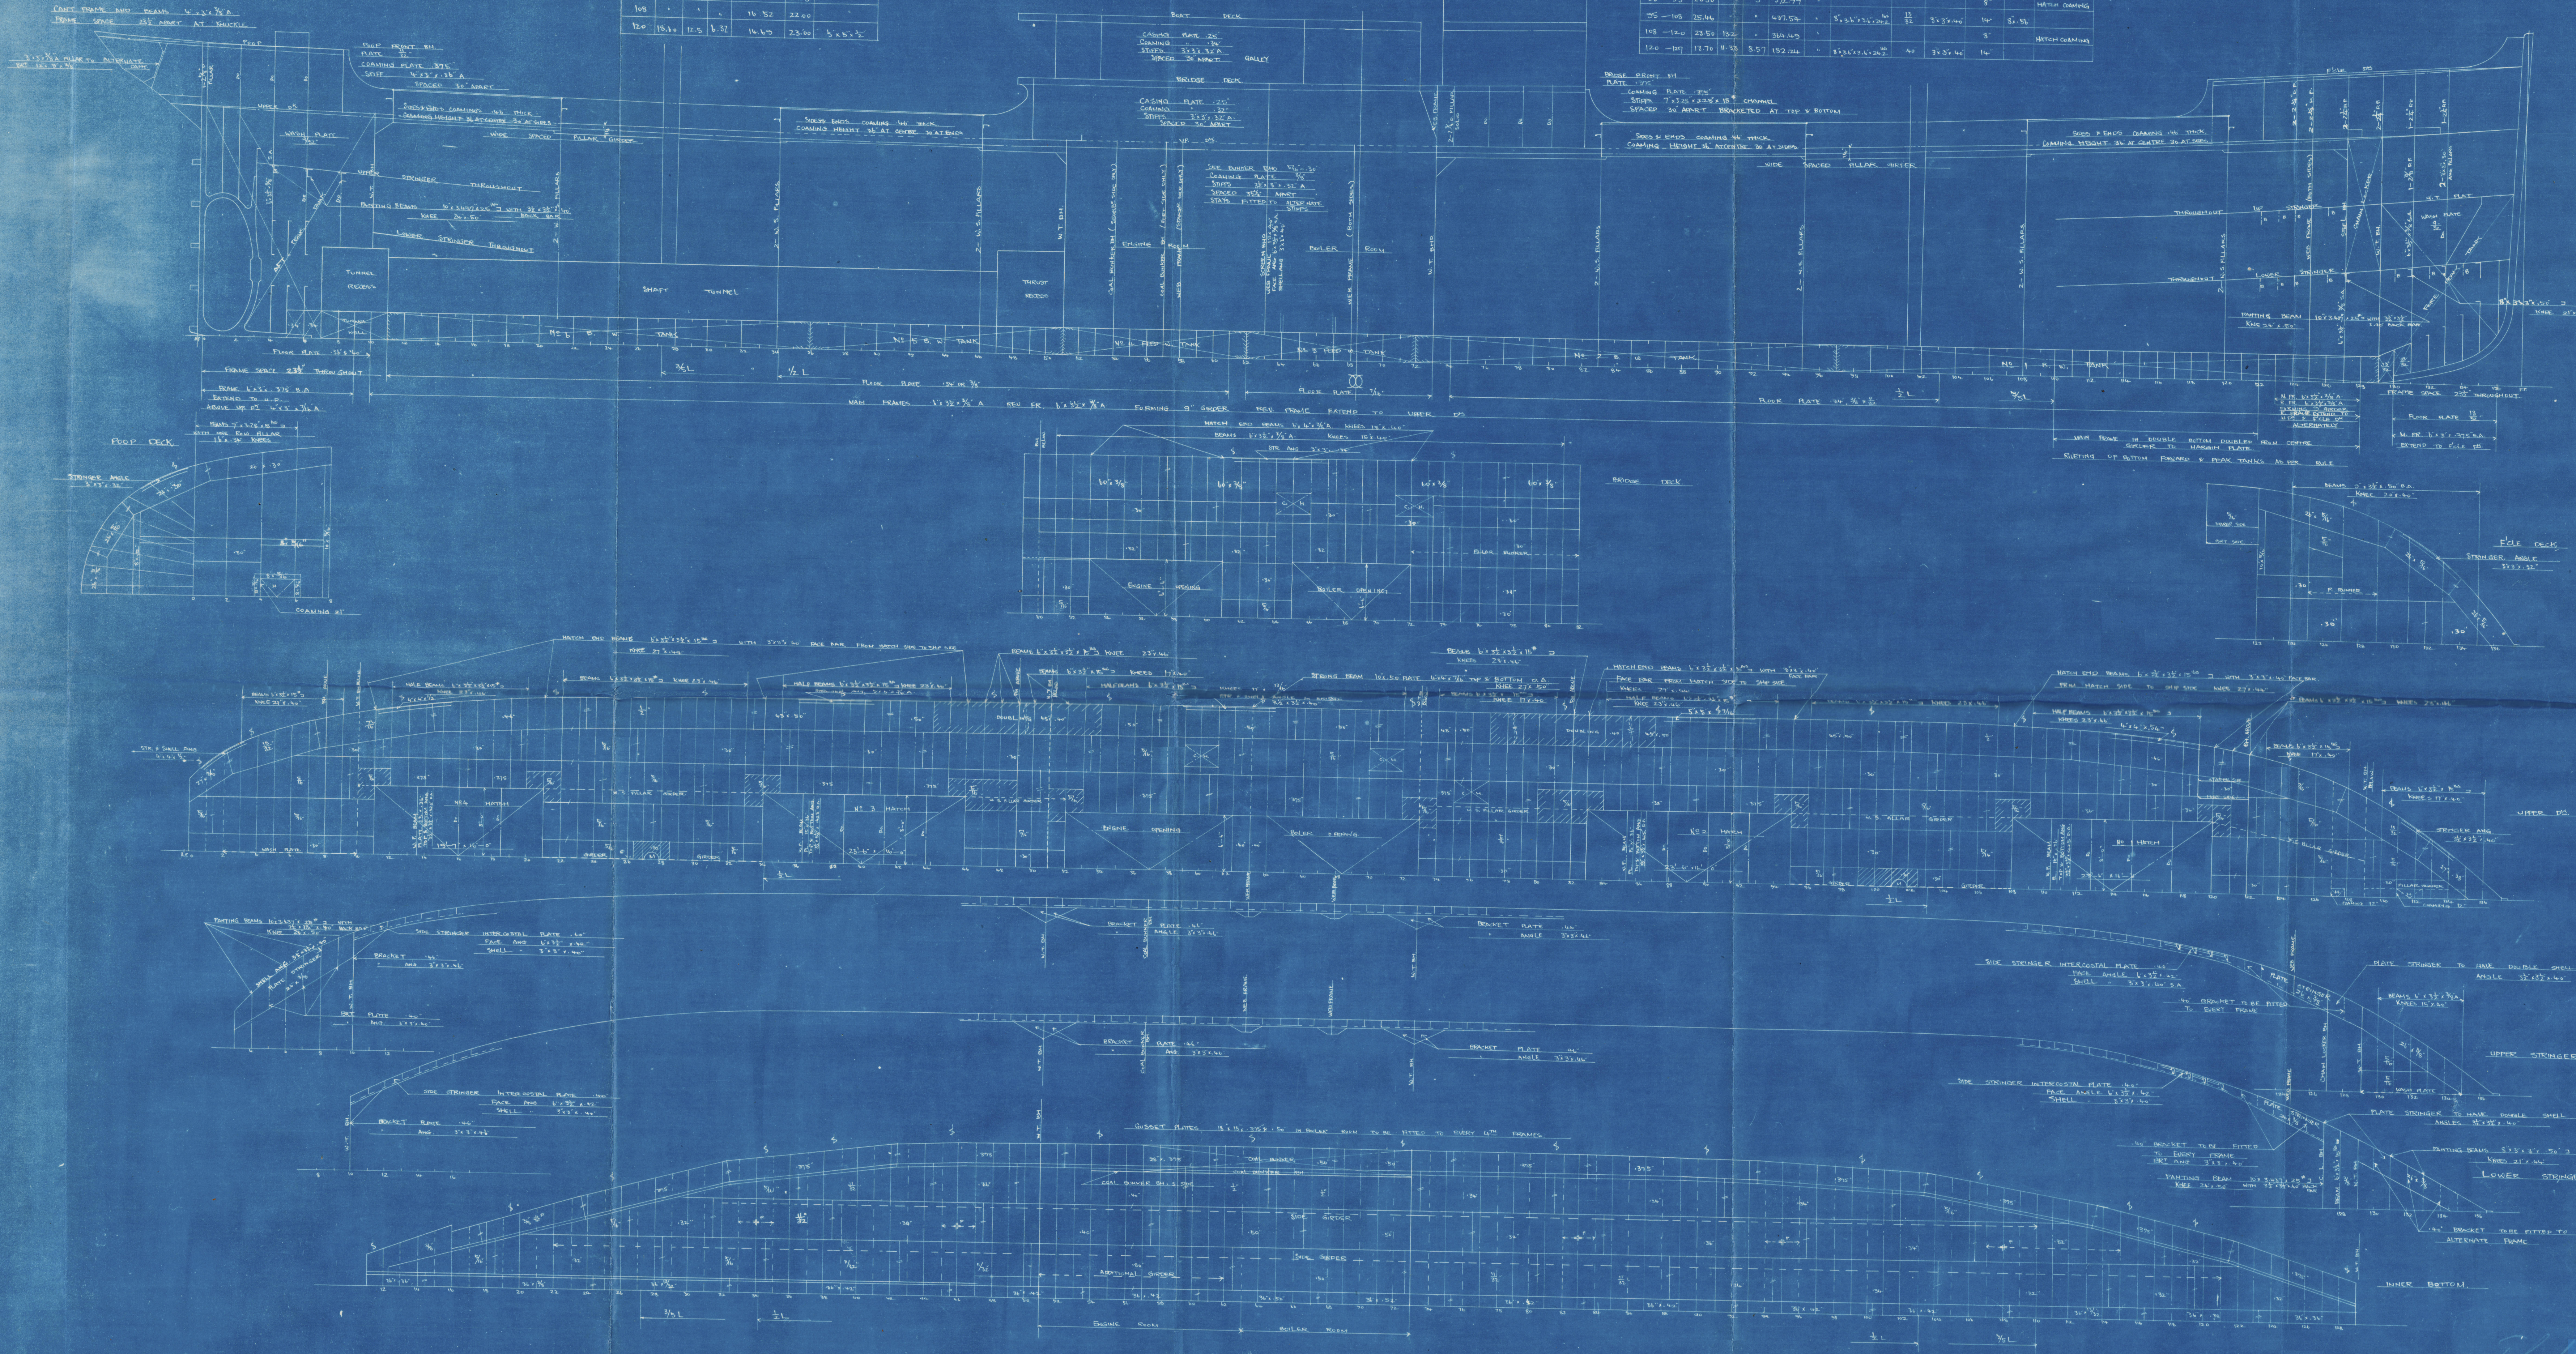

W1203-0084



Kobe. 2867

T. S.S. Form No. 37.

TOBA YARD No. 55.

Ship's Name: "DAIHO-MARU, No. 1"

**CONSTRUCTION PROFILE DECK & INNER  
BOTTOM PLAN.**

*Rept.*

No.

As Finished Plan.

TEIKOKU STEAMSHIP CO., LTD., KOBE, JAPAN.

RETAIN R

© 2020

Lloyd's Register  
Foundation

W1203

0084