
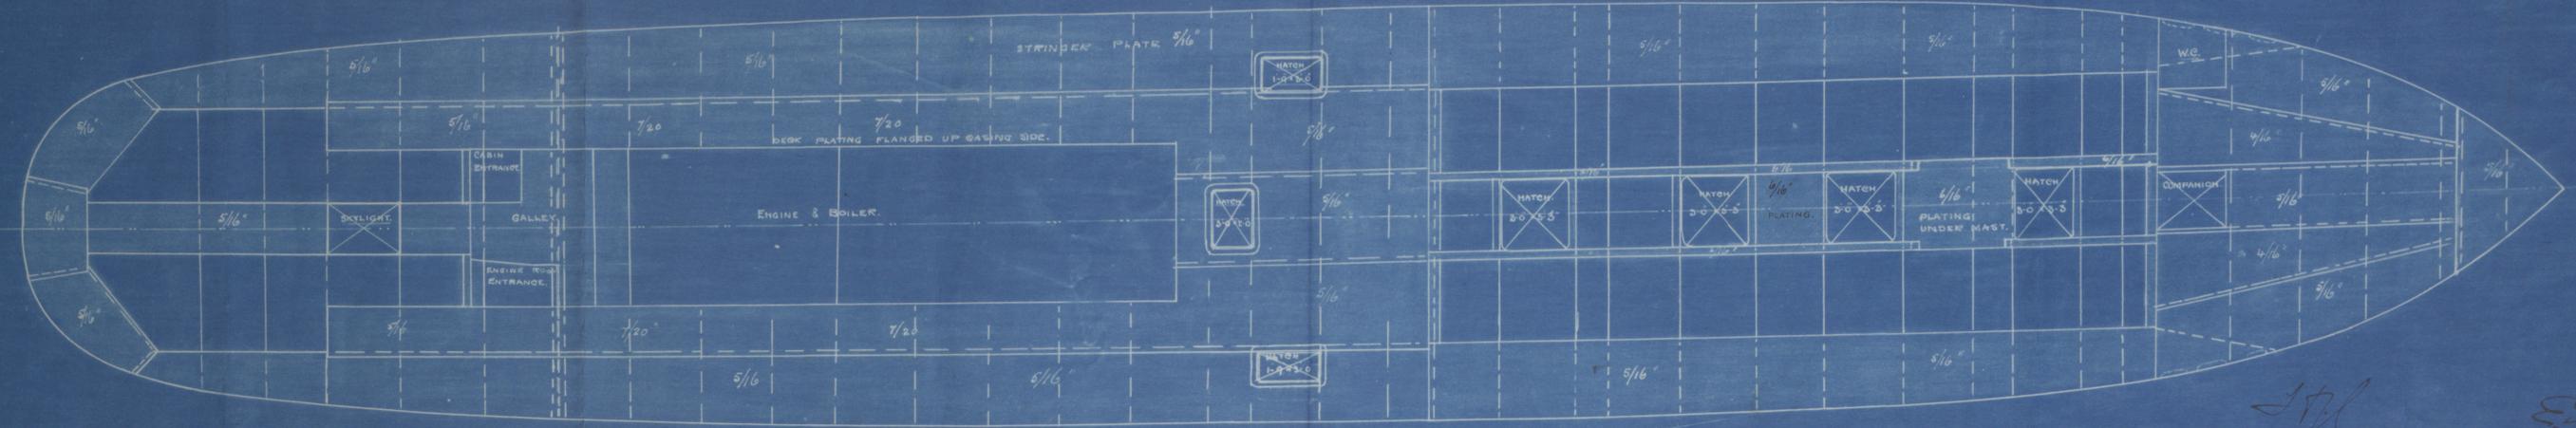


11.7.04

PROFILE & DECK PLAN.

N^o 329.

115'-0" x 21'-6" x 12'-4" M.T.P.
SCALE 1/4" = 1 FOOT.

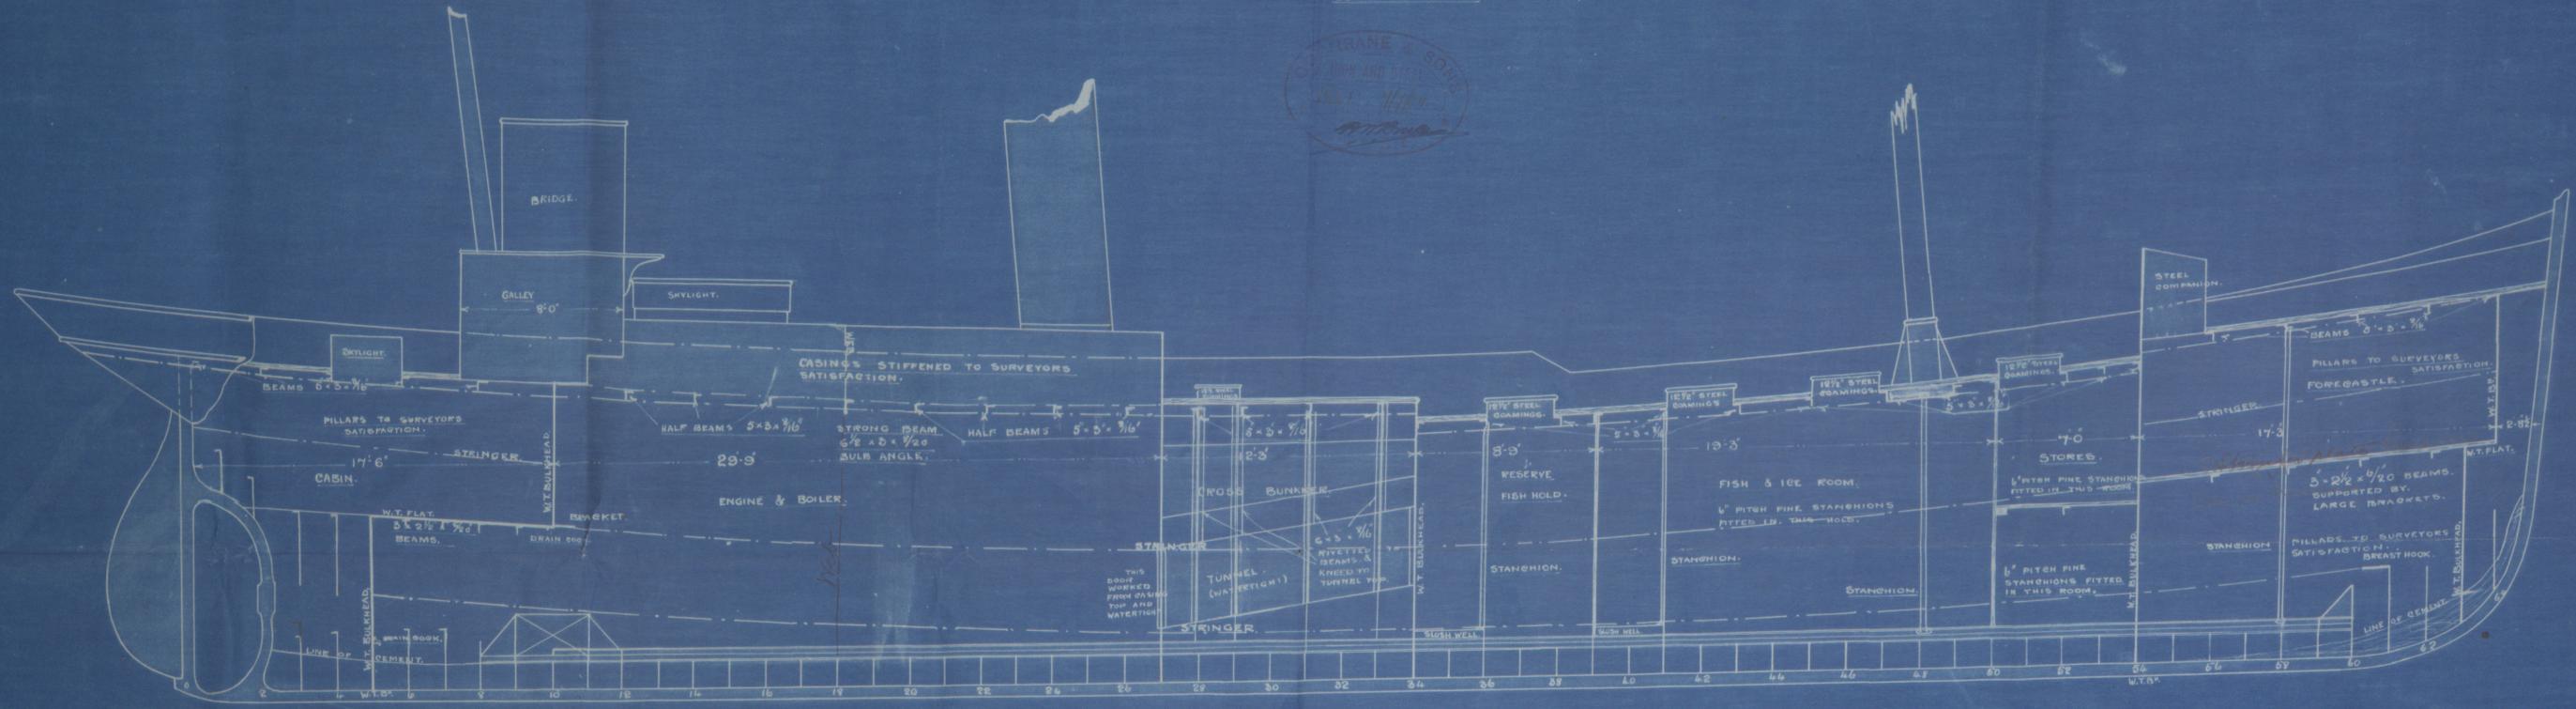

J.H.L.
9/17/04

T.S.T.




Profile -
- No. 329 s/s -

s/s "Reliance"
Hull Report No: 16402



RETAIN

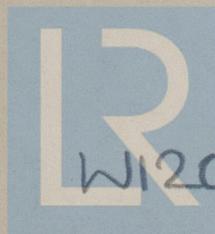

© 2020

Lloyd's Register
Foundation

W1204 - 0032