



11-7-04

Midship Section Steel Screw Trawler.

Length, 115'0"; Breadth, 21'6"; Depth ^{11'10"} 12'4" _{11'2" 6"}


— No. class 100 A-1. Steam Trawler —

— Scale $\frac{1}{2}$ " = 1 foot. —

— Raised Quarter 8'60"x12" Raised Yock 8'14"x12" —

E & B Casing as previously approved.

Deck plated over in way of E & B casing

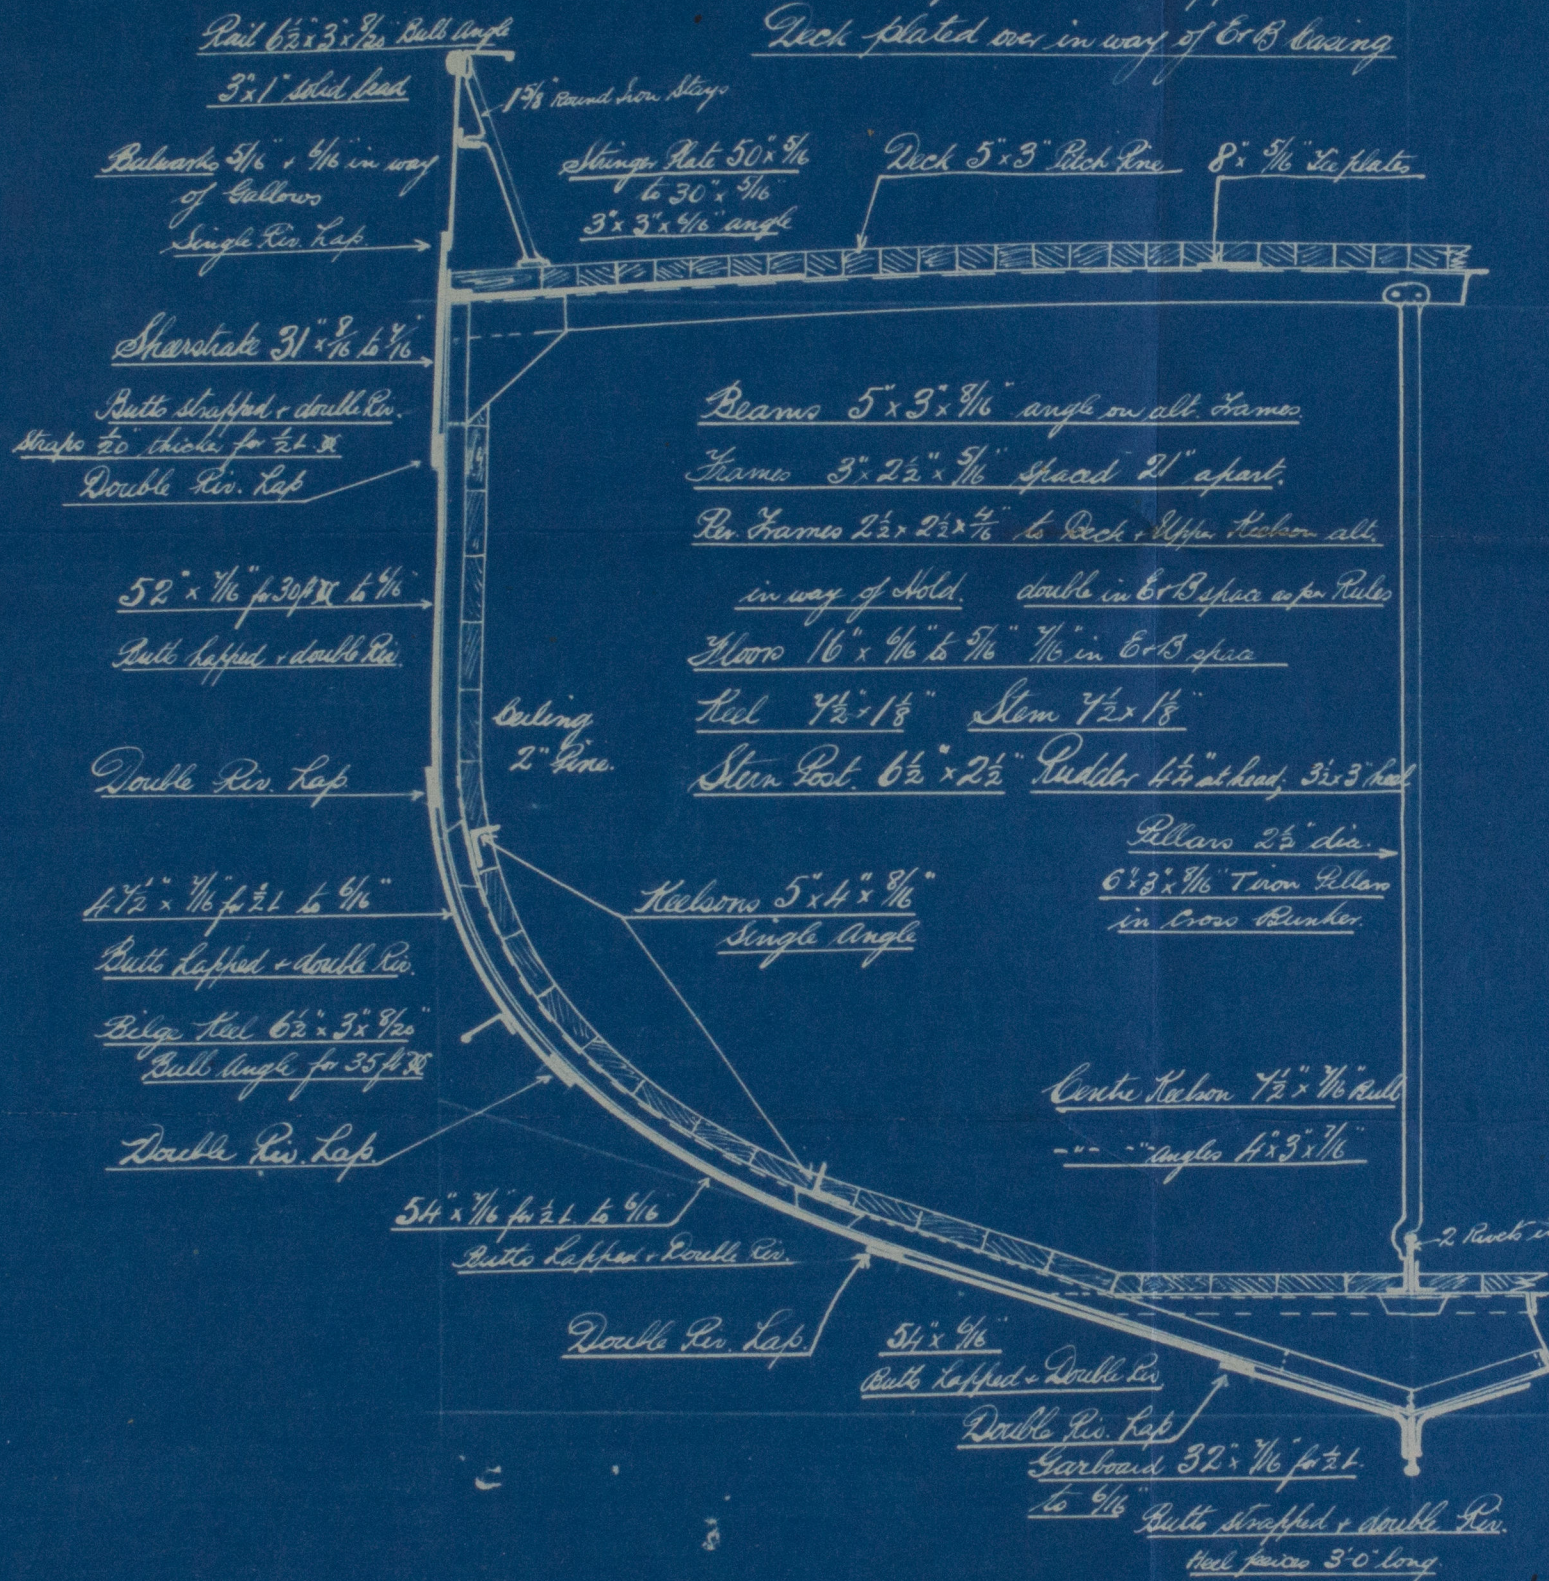

— S.S. No 329 —

Cochrane & Sons

Shipbuilders

Selby

Numerals as per Rules.

1/2 Breadth 10.75

1/2 Girth 19.05

Depth as per Rule 12.78

42.58 1st No.

113.84 Rule Length

4847.30 2nd No.

Proportions Breadth to Length 5.4.24

Depth --- 8.9

Equipment.

1st Bower 5 cuts ex stock


2nd --- 4 1/2 --- ---

3rd --- 2 1/2 --- ---

90 faths 1" Cable

60 --- 5 1/2" Hawser

60 --- 4" Warp.

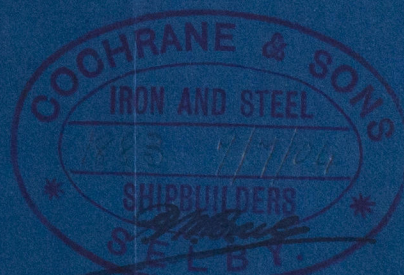

J.V.L.
9/7/04



E.D.T

W1204-C033

Midship Section

~ No 329 ~

Lochran & Son -

"Reliance"

Hull Report No. 16402



RETAIN



© 2020

Lloyd's Register
Foundation

W1204 0033