

Received at



Lloyd's Register of British and Foreign Shipping

(Report on Vessel No. 16402 Port

Hull
% Release

No. 8.041

SHIP FORGINGS OR CASTINGS.

I have to report that the undermentioned Iron ~~or Steel~~ Forgings ~~or Castings~~, manufactured by Emerson, Walker & Co.,
of Dunston for the Vessel No. 329, being built
by Cochran & Sons of Glasgow Hull
have been inspected by me as set forth below and found to be, so far as can
be seen, Sound.

Mark on Forgings.




Lloyd's
No. 2422-N
J.H.H.W.C

John H Heck & McCampbell

Newcastle
21.9.04

	STERN FRAME.	RUDDER FRAME.	STEM.
Material*	Scrap	Scrap	
How made	Forged & Smithed	Forged & Smithed	
Dimensions	6 1/2 x 2 1/2	11 1/4	
Progress on Inspection	Finished	Smithing	
Date when Inspected	July 8-1904	August 20-25 Sept 1 st 1904	

SKETCHES OF FRAMES SHOWING POSITION AND DESCRIPTION OF WELDS OF FORGINGS, OR PARTICULARS OF TESTS APPLIED TO CASTINGS.

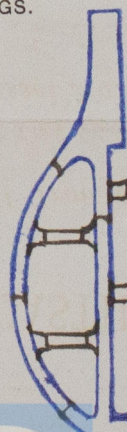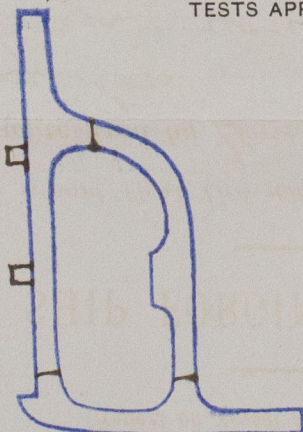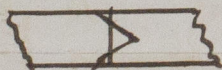

Fee (if any chargeable) £

To be paid at