

# S.S. No 285 MIDSHIP SECTION

LENGTH B.P. 385-0  
BEAM EXTREME 32-0  
BEAM MOULDED 31-8  
DEPTH IN HOLD TO CELL BOTTOM 24-0  
DEPTH MOULDED TO UPPER DECK 26-6  
SCALE 3" = ONE FOOT

STEEL SCREW STEAMER  
CLASS 100 A.I. SINGLE DECK


ANCHORS & CHAINS  
EQUIPMENT No 32159

1 BOWER ANCHOR	56-1-0	STOCKLESS
1 " "	56-1-0	"
1 " "	47-2-0	"
COLLECTIVE	160-0-0	"
1 STREAM ANCHOR	15-0-0	EX OF STOCK
1 KEDGE	6-2-0	"
270 FATHOMS OF	2 1/2	STUD CHAIN CABLE
30 " "	1 1/2	STEEL CHAIN OR 4 1/2 STEEL WIRE
120 " "	1 1/2	STEEL TOWLINE OR 4 1/2
2 OF 90 " "	1 1/2	HANSEK OR 2 1/2
2 OF 90 " "	1 1/2	WARPS OR 2 1/2

17.11.13.  
21.11.13  
20.1.14

## SECTION THRO ENGINE ROOM

## SECTION THRO HOLDS

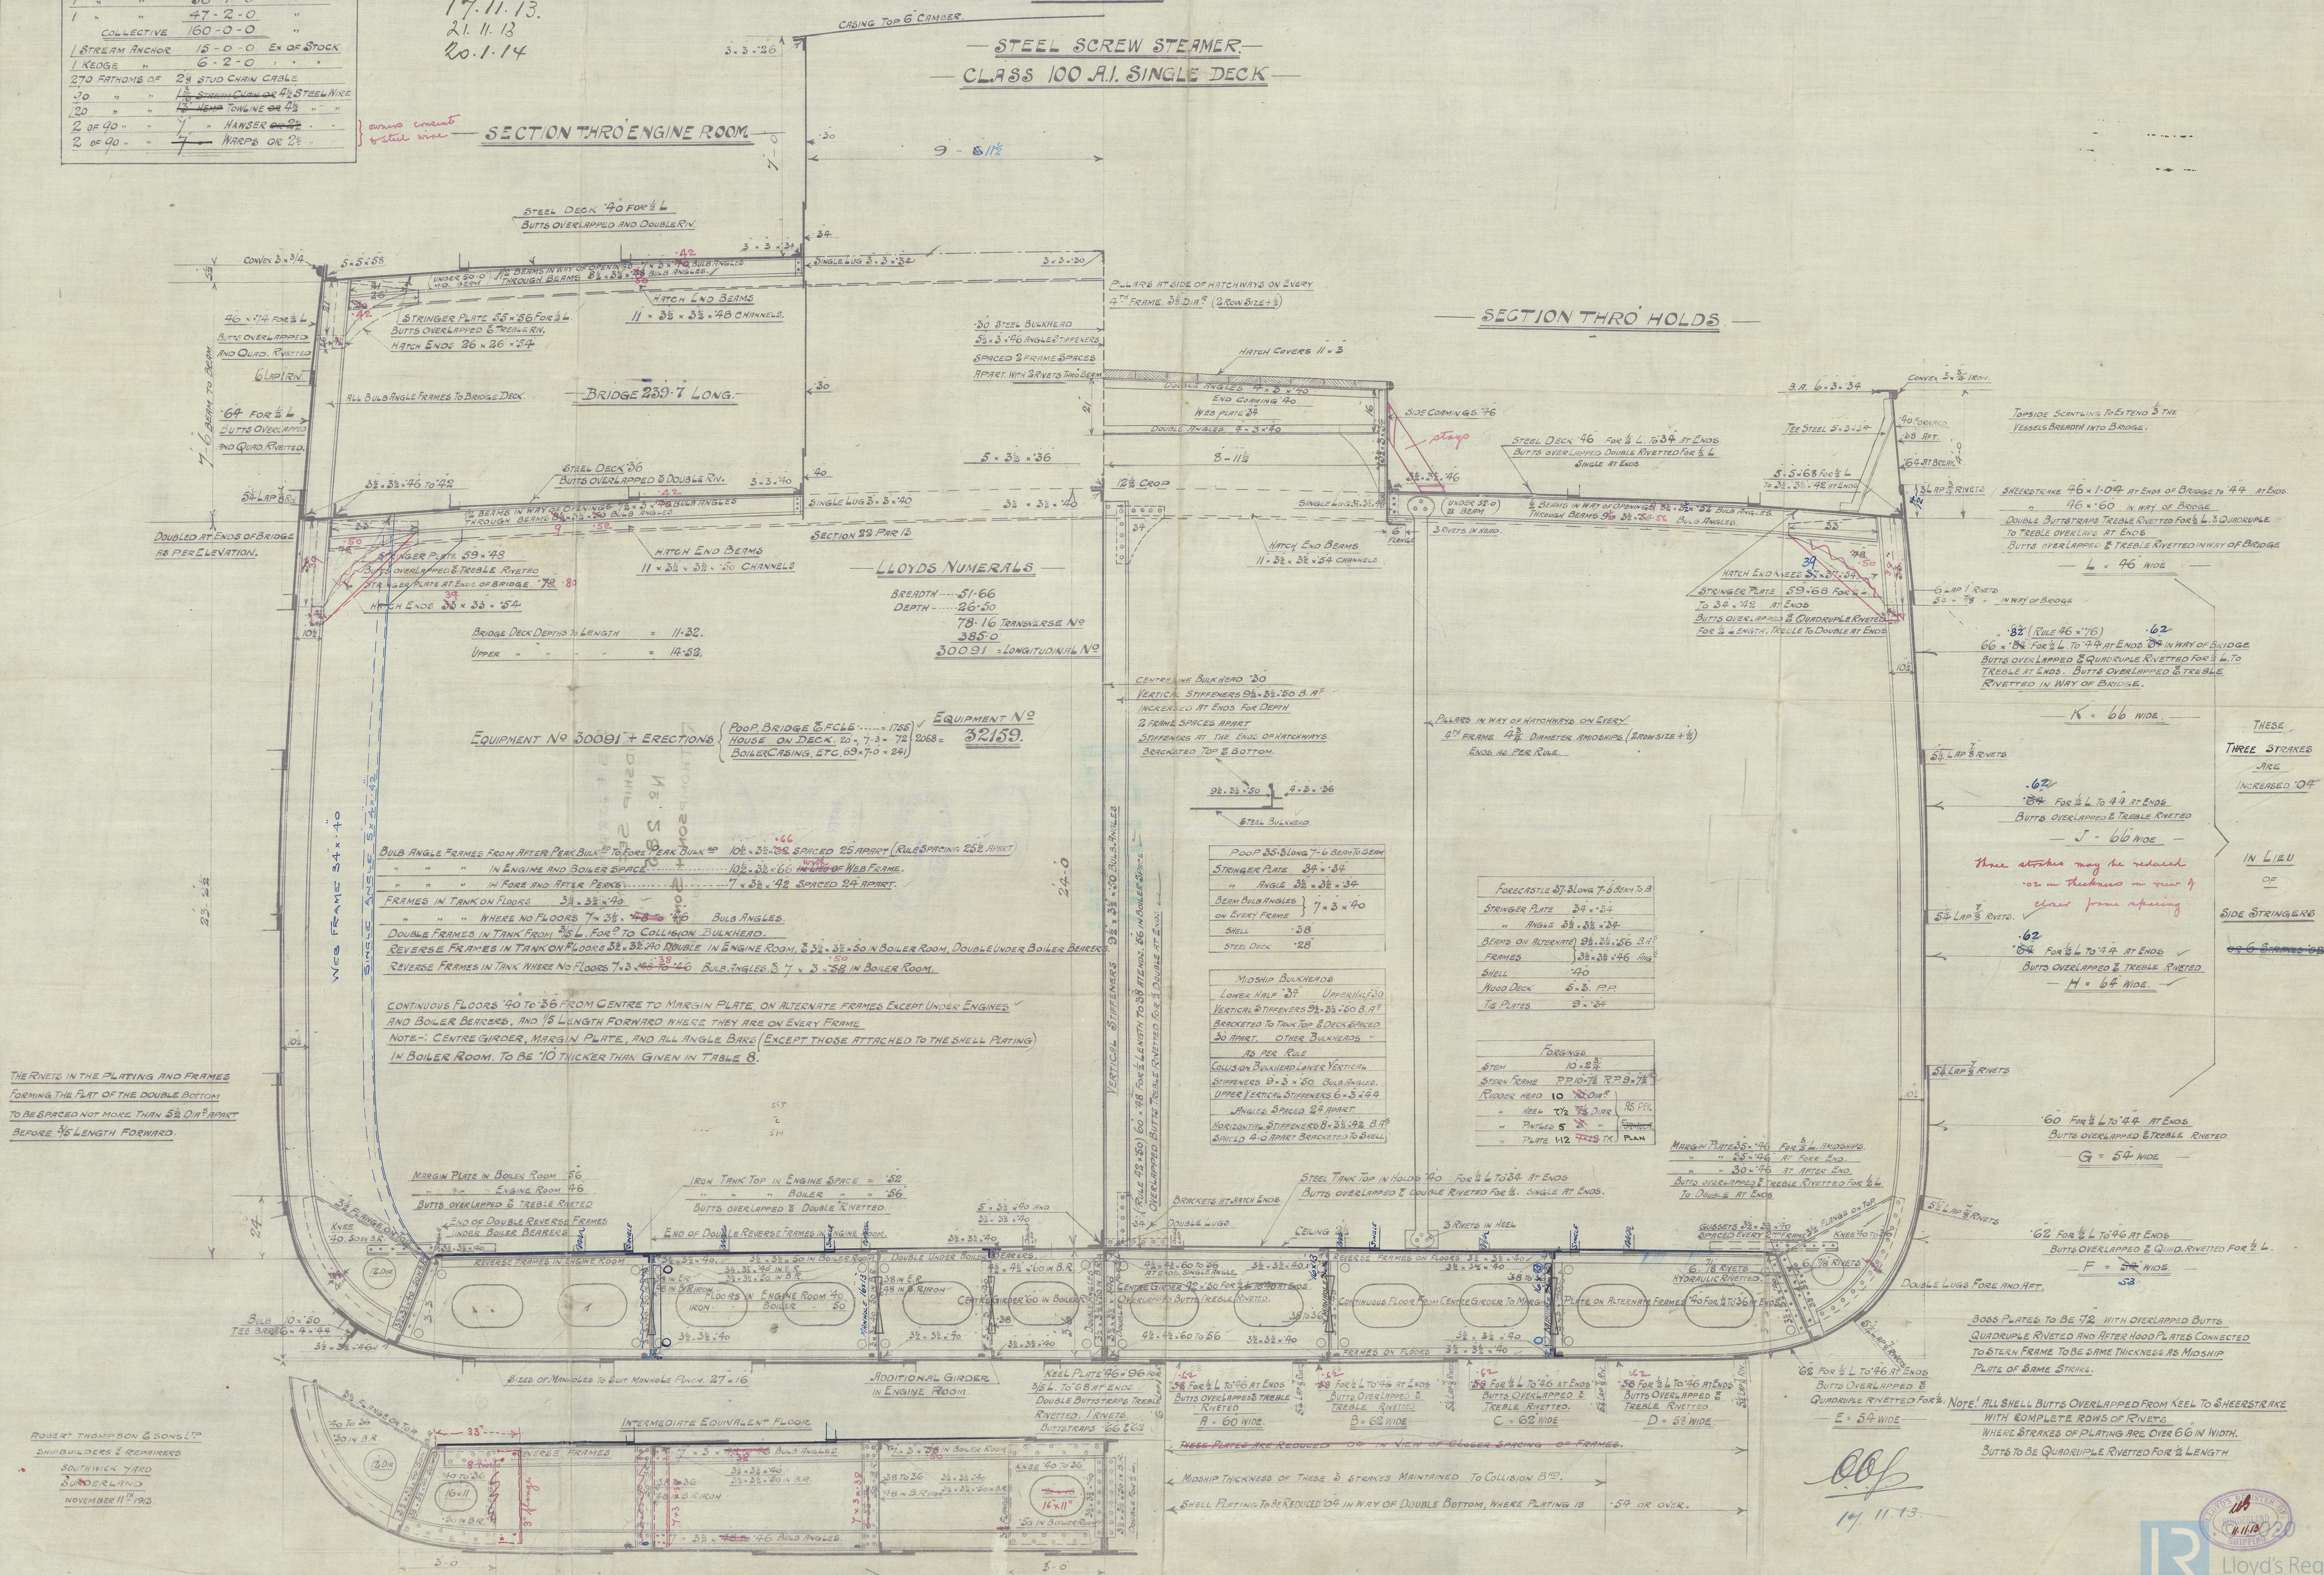

THE RIVETS IN THE PLATING AND FRAMES FORMING THE PLAT OF THE DOUBLE BOTTOM TO BE SPACED NOT MORE THAN 5 1/2 IN APART BEFORE 3/8 LENGTH FORWARD.

ROBERT THOMPSON & SONS LTD  
SHIPBUILDERS & REPAIRERS  
SOUTHWICK 7980  
SUNDERLAND  
NOVEMBER 11 1913

W1205-0028



S.S. EGGESFORD

MIDSHIP SECTION

Nº 285

R. THOMPSON & SONS LD

SLDRPT Nº. 26282

