


S. S. 705

Sir W. S. Armstrong & Co

Midship Section

S. S. Timna

Nwe 41437

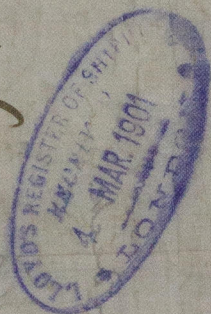





© 2020

Lloyd's Register
Foundation

Steel plate for floor & c.

Beams of built angle
in truss
to support
steel plate

in truss
to support
steel plate

3" pillars 8'-8" apart

built angle 12" x 12" x 1/2"

Steel plate 12" x 12" x 1/2"

Beams of built angle 12" x 12" x 1/2" for 3/4 length

Strong beams on walls in line of quarter pillars
Plate 12" x 1/2", single deck angle 2" x 2" x 1/2", bottom angle 6"
Main back beams have been increased in depth
Hotel and beams built plate 12" x 1/2", single angle 2" x 2"
Strong beams on back in square plate 12" x 1/2" x 1/2"

Beams spaced 22' apart




© 2020

Lloyd's Register
Foundation