

26-3-03

HEATING SURFACE	SQ. FEET
TUBES	405
FURNACES	78
COMBUSTION CHAMBERS	81
TUBE PLATES	31
I. BOILER	595

WORKING PRESSURE 120 LBS PER SQ.
TEST " 240 " " "

CHECKED BY
DATE March 1903
TIME CHARGED TO



BOILER, ORDER N° 149 B.

FOR SIR W.G. ARMSTRONG & WHITWORTH'S N° 142 SHIP.

TO BE CONSTRUCTED TO PASS LLOYDS SURVEY.

1. OFF THIS

SCALE 1" = 1 FOOT

MARCH 19TH 1903

PLATES MANUFACTURED BY J. SPENCER & SON


PLATES OF STEEL

RIVETS " "





MAIN STAYS " "

CC STAYS " "

TUBES OF IRON.

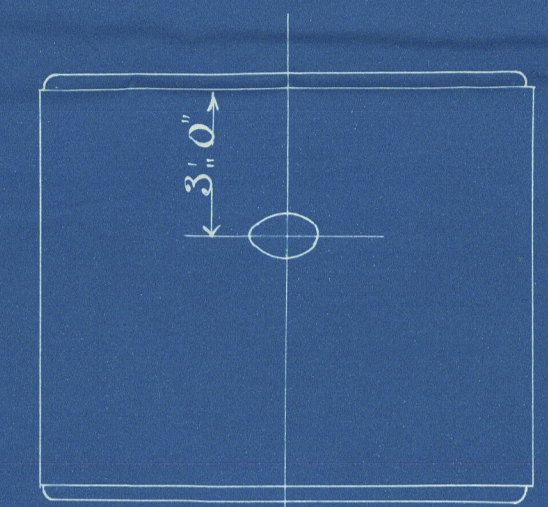

FRONT OF BOILER

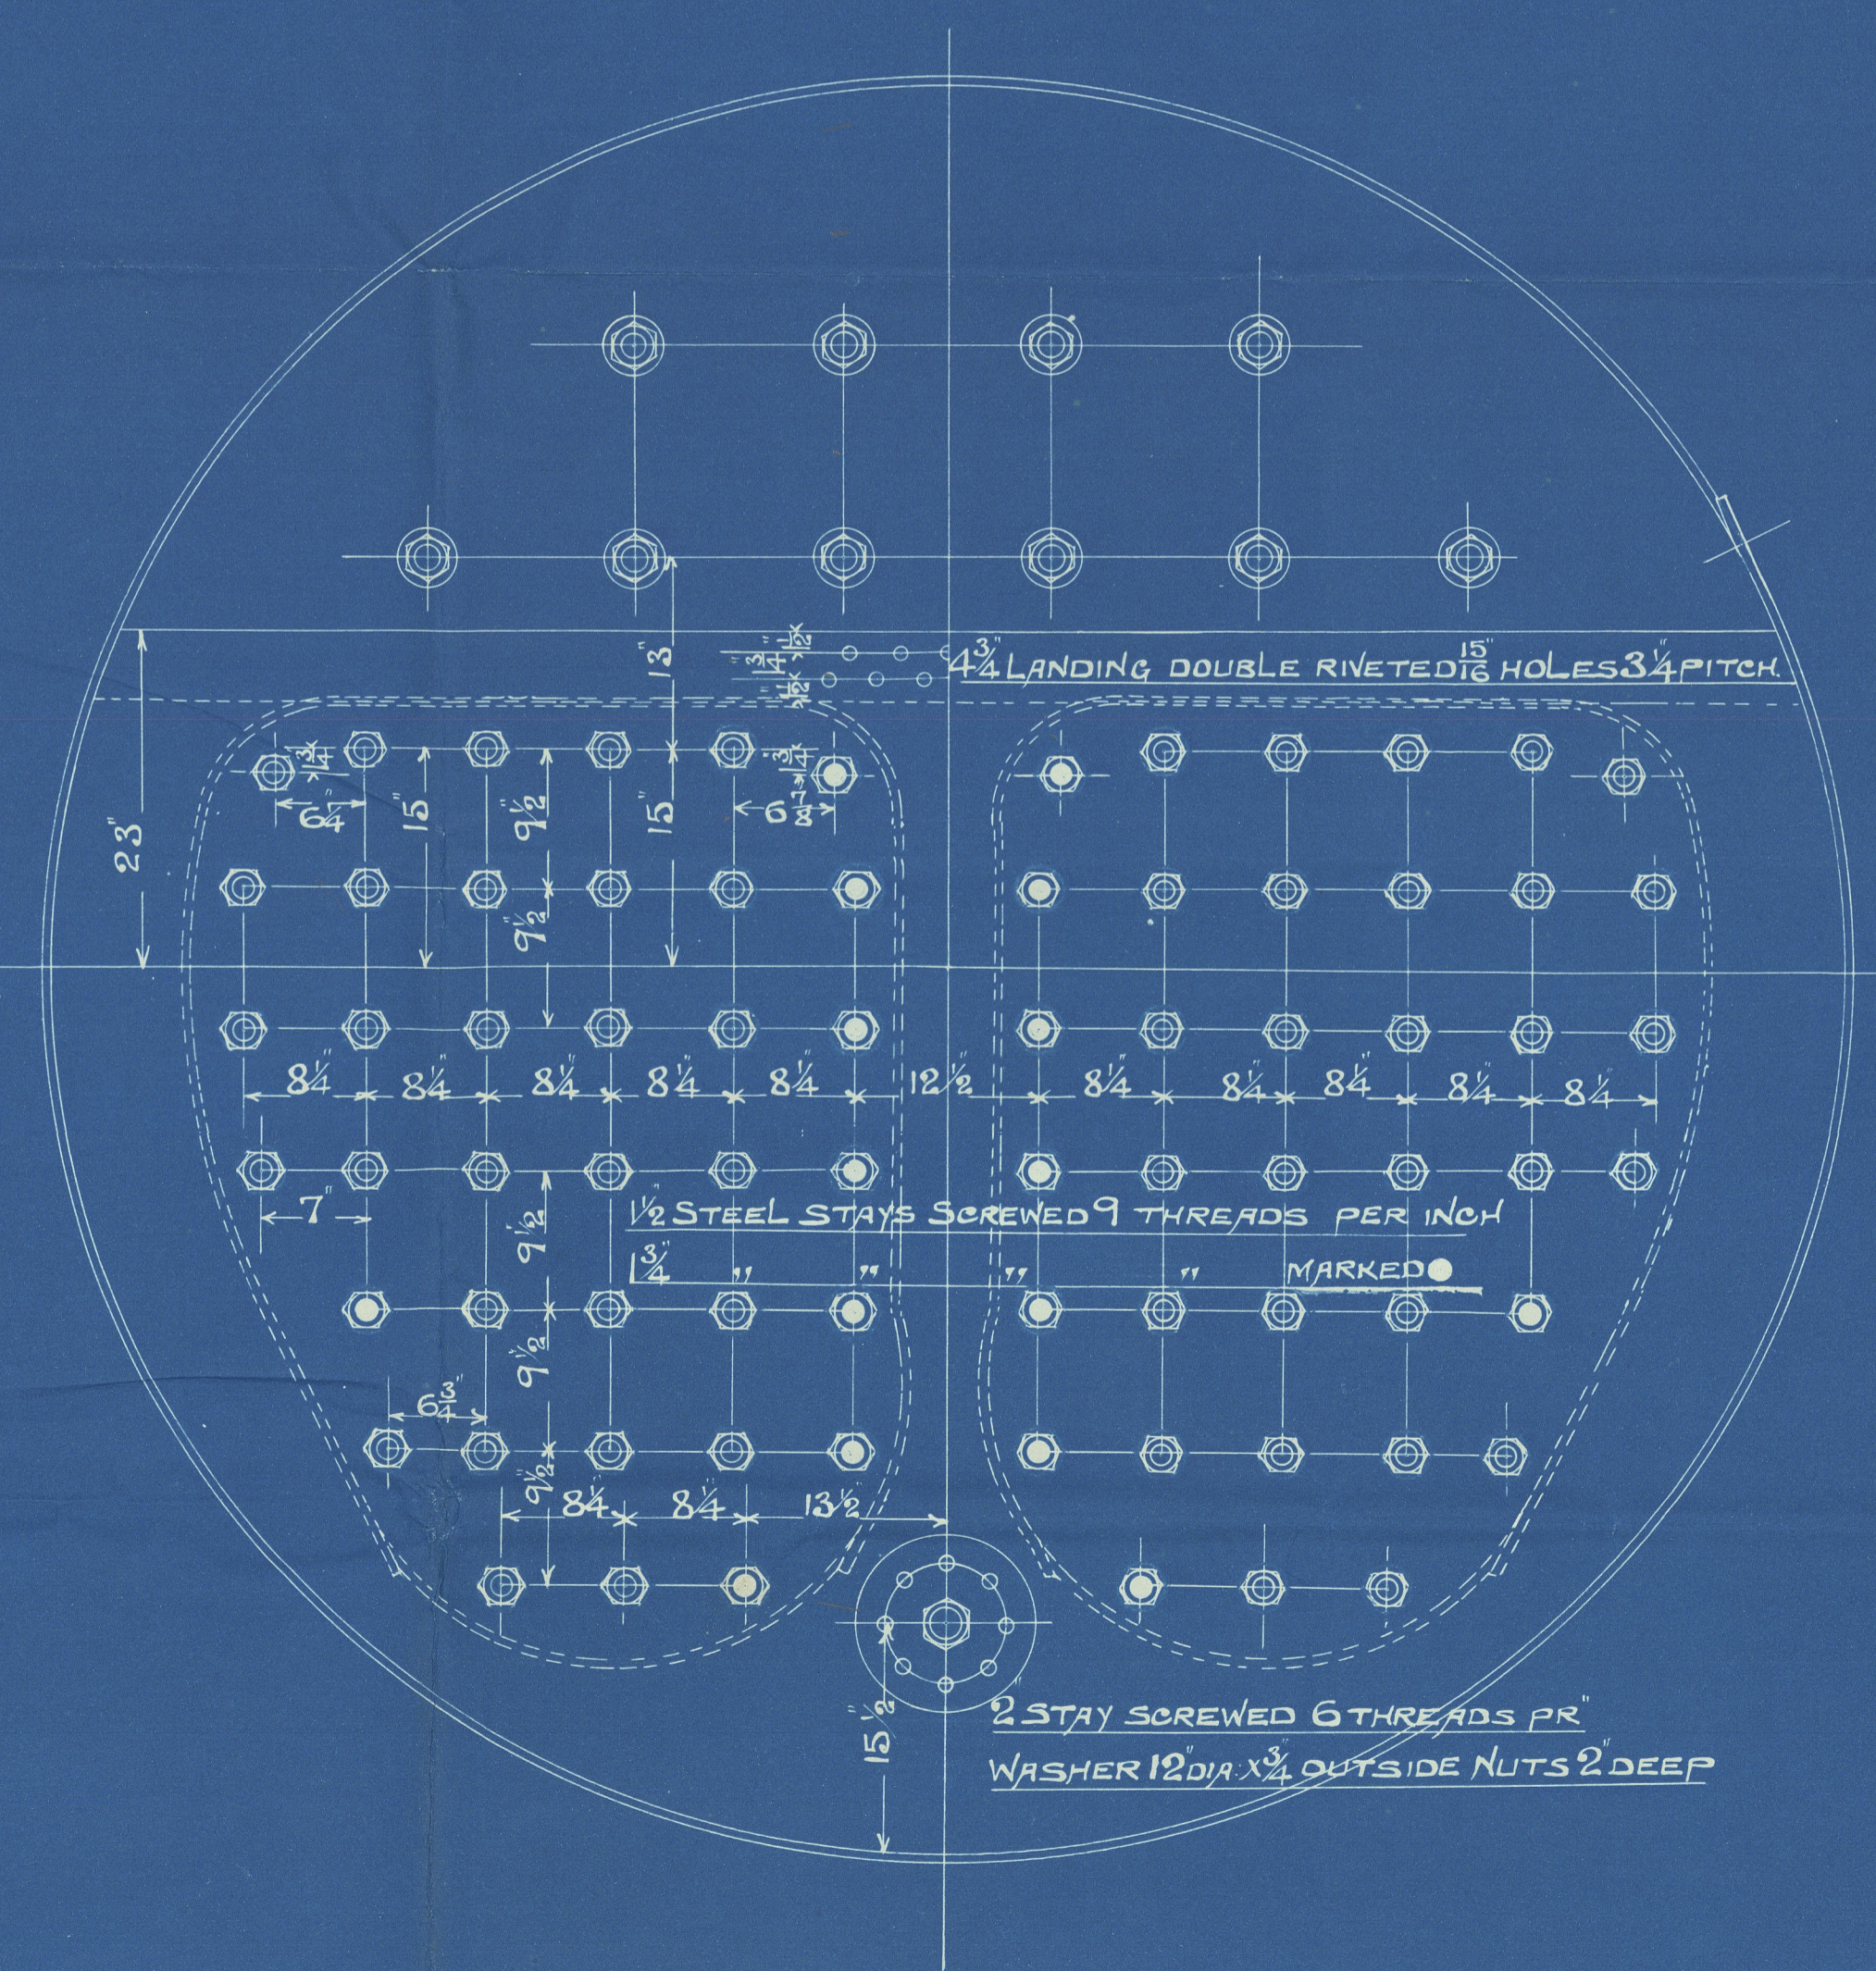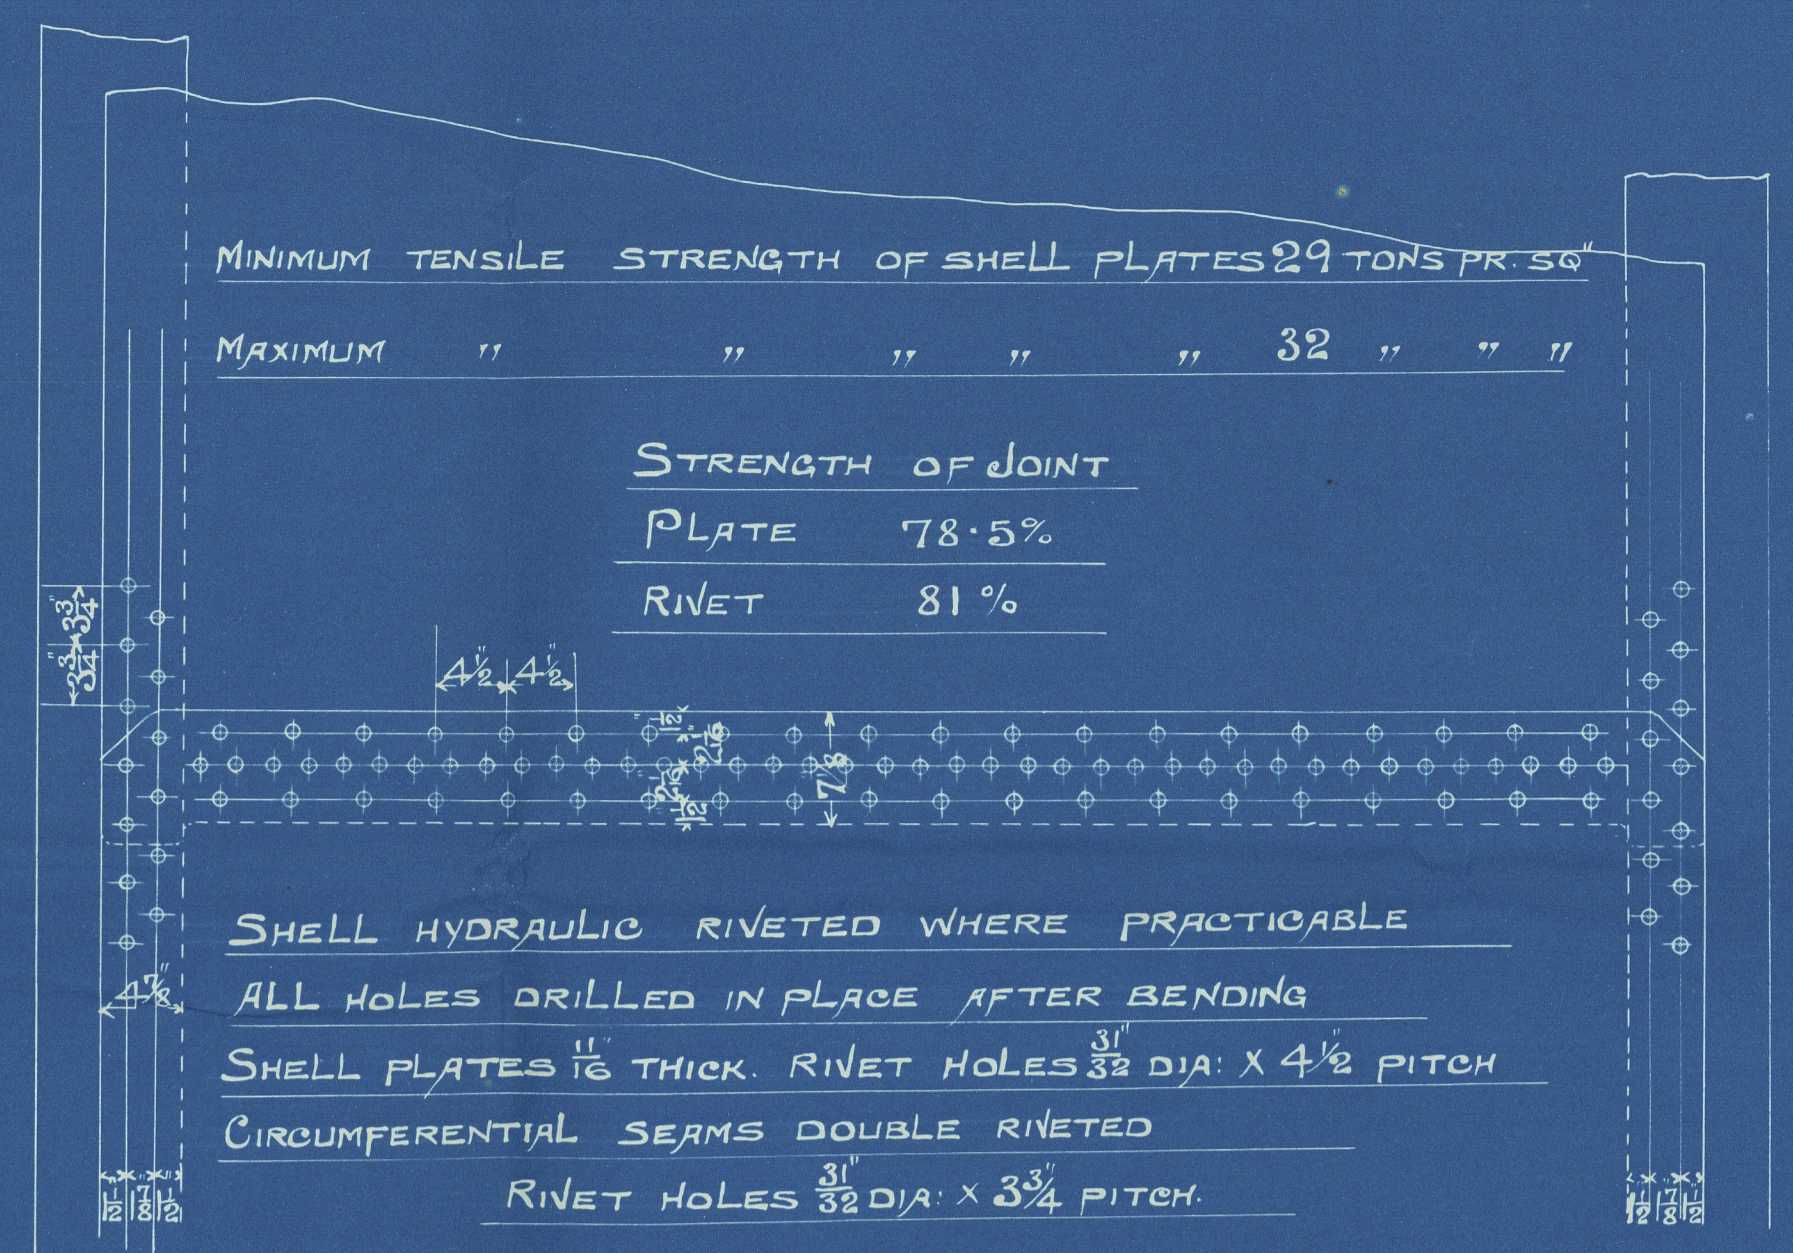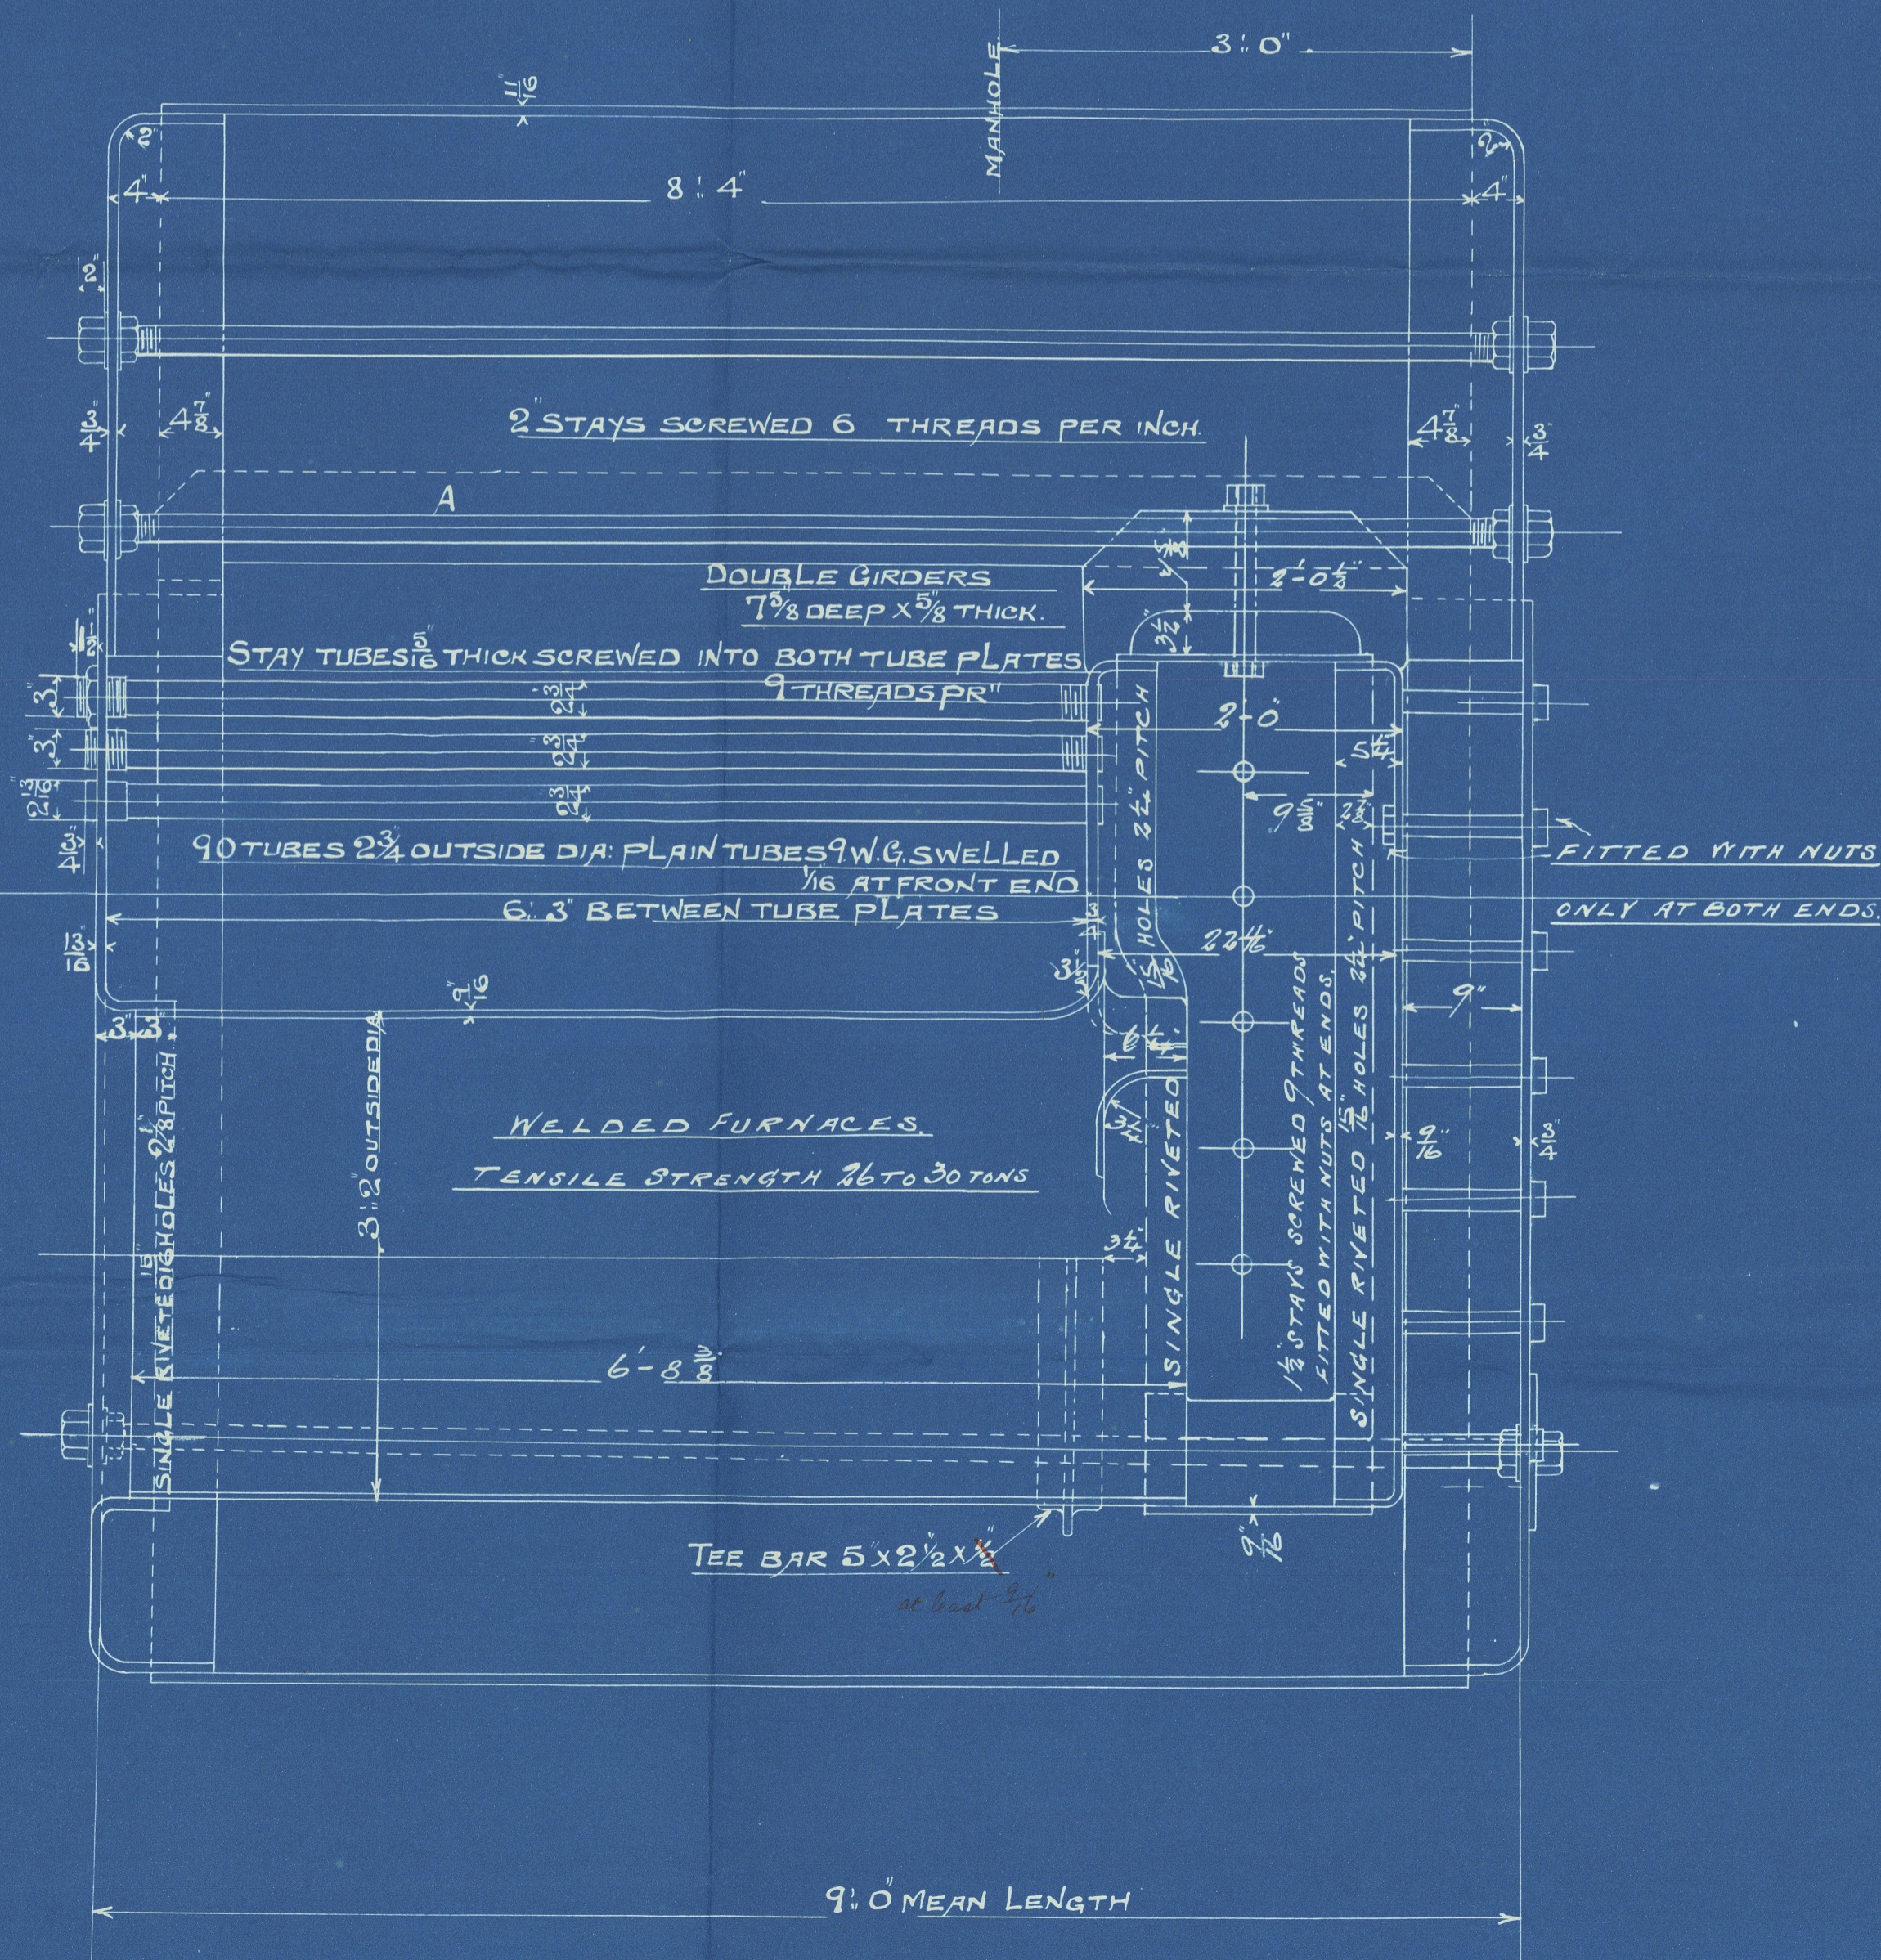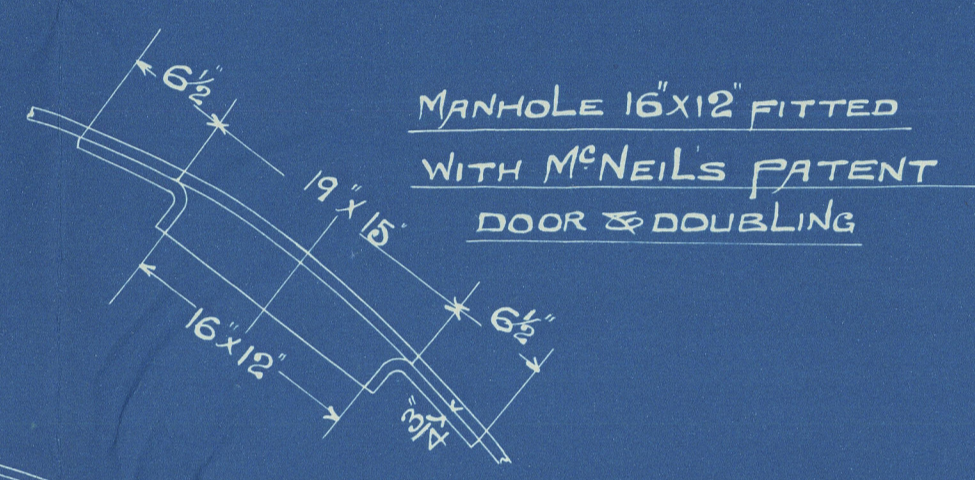

26-3-03

Walsand Shipway

149 B. Sontag trials

Mr. Armstrongs 742 ^s/₈

15.E.
120.V.P.

no 6608
Lloyds Est
24 0/16
G.A.H. 17/6/03



J.P. Lingue

Newcastle Report

N^o 46.265 /

RETAIN



© 2020

Lloyd's Register
Foundation

W1206 - 016