

95'-0" B.P. x 19'-0" M<sup>2</sup> x 11'-0" M<sup>2</sup> DEPTH

CLASS A. FOR RIVER PURPOSES

COOK WELTON & GEMMELL LTD  
SHIPBUILDERS  
BEVERLEY





W1208-0291

Amended  
Friendship Section

N<sup>o</sup> 161


Cook Welton & Gemmell

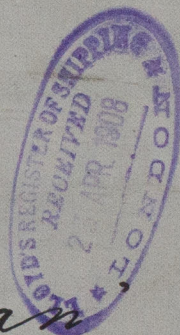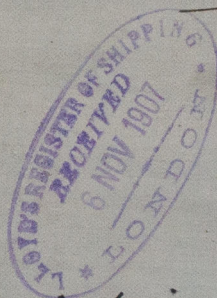

S<sup>r</sup> Hunsman

Hull Report N<sup>o</sup>

RETAIN

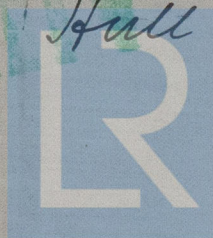

Lloyd's Register  
Foundation