

11.5.23

W1210-0070

2 working cyl.s

Diam. 165 mm.




Stroke 200 mm.

Max. pressure in cyl. 35 kg/cm²
Revolutions per min. 550.

aux. compr. cyl.s (compound)

L.P. diam. 130 mm.

Stroke 200 mm.

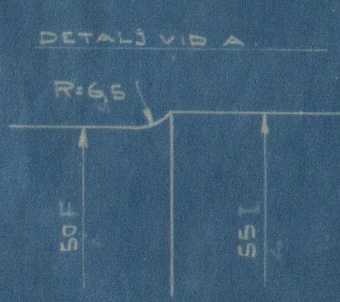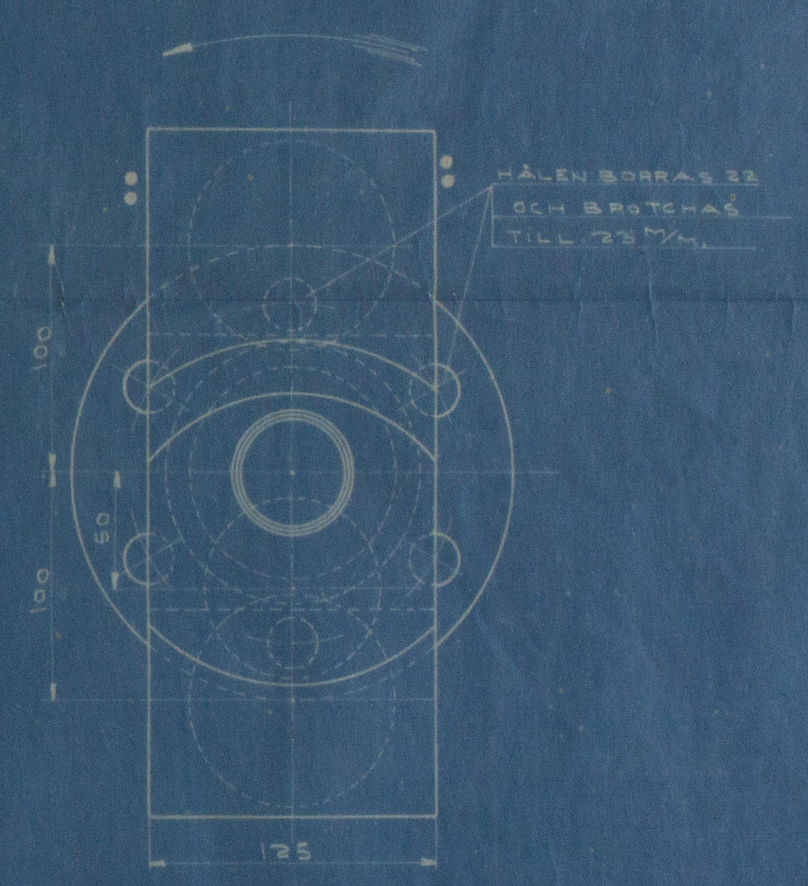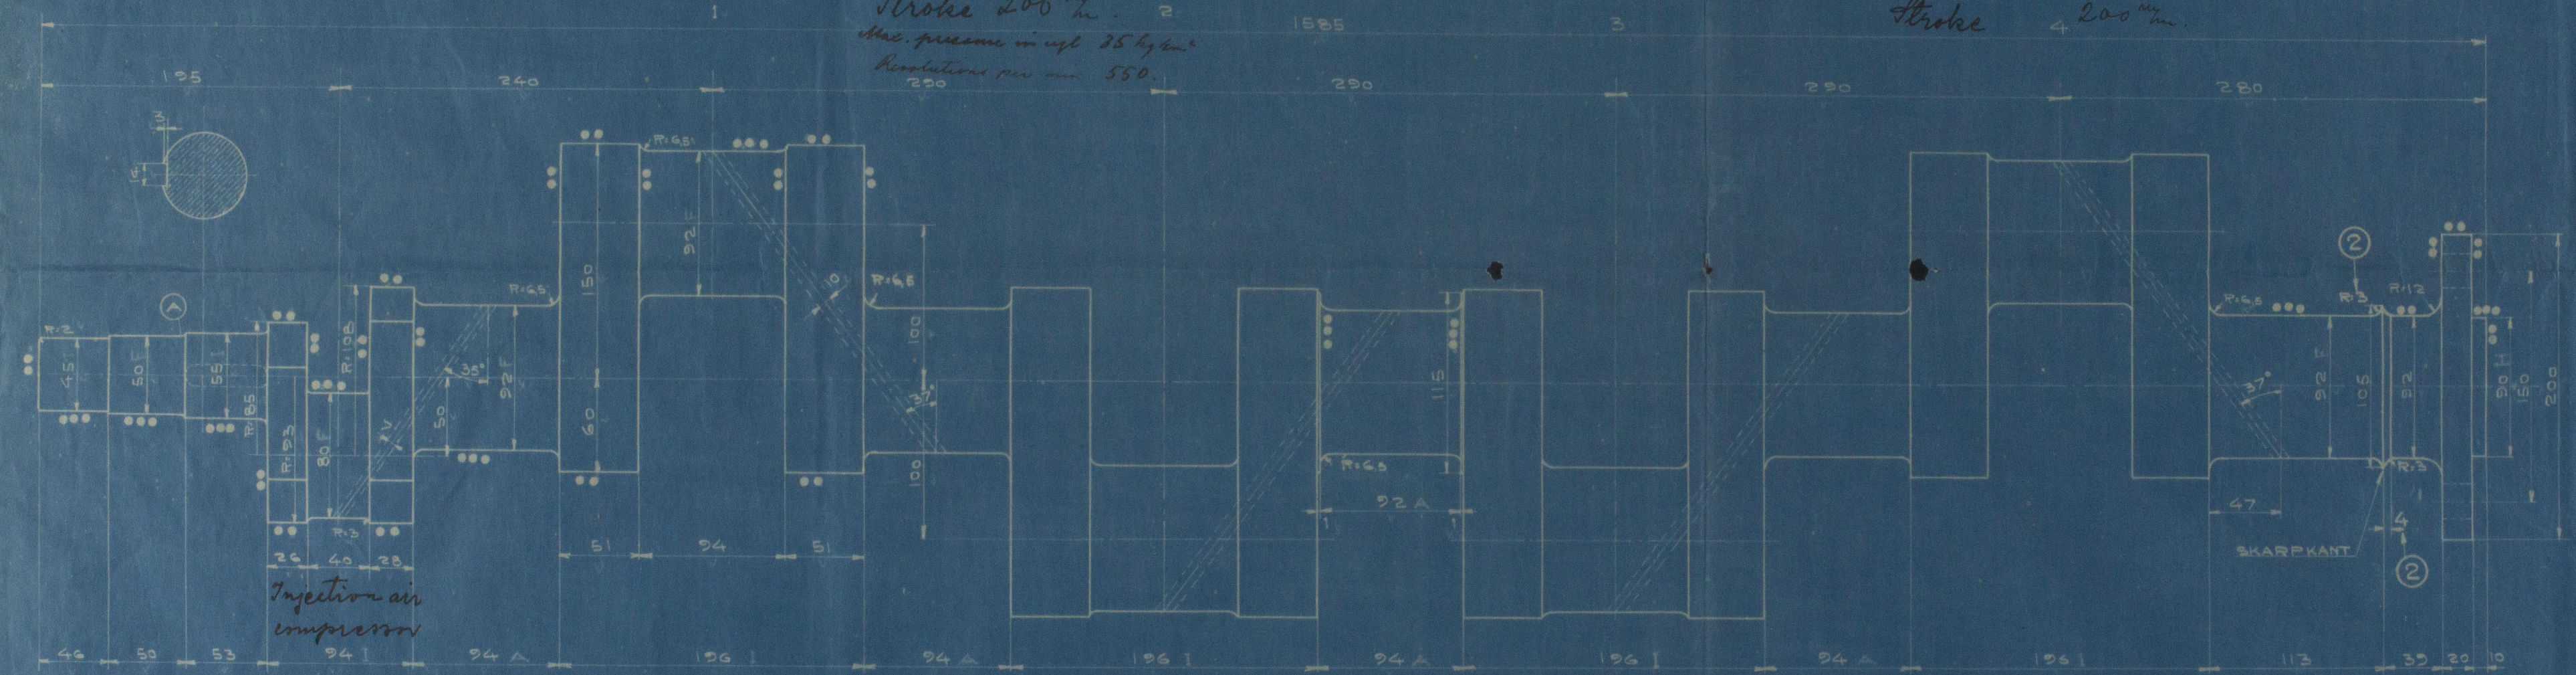

The copying of this drawing is strictly prohibited. The drawing must not be made accessible to competitors.
A. B. ATLAS DIESEL
DEPARTMENT
DIESELS MOTORER
STOCKHOLM

AKTIEBOLAGET ATLAS DIESEL
AVDELNING:
DIESELS MOTORER
STOCKHOLM

11.5.23

Cranks shaft for aux Diesel engine with compr.

VEVAXEL TILL LZ2C		SKALA 1:3
No LZ2C-A313		KONSTR. <i>CP2</i> DATO. <i>25 APR 33</i>
A-B ATLAS DIESEL AVD. DIESELS MOTORER STOCKHOLM		KÖPIER. <i>CP2</i>
		KONTR. <i>CP2</i>

ÄNDRINGAR OCH TILLÄGG
MÄTT ANGRÄPETILL 33
4 mm FRÅN RESE 6555 mm
OLJEAVKASTN. NÄRSKANTEN
UTFÖRES MED SKARPT HÖRN.
DEN 5/11/23

Auxil. Engine with compressor.

Crank shaft.

M/S. N^o 12

AB. Karlshamns Skeppsvärk.

Malmö

Gen Box 4084

"Epoca"

Mmo 620

RELIANT



© 2021

Lloyd's Register
Foundation

W1210-0070