

9/5/04 PRINT No 144.



19.5.04

N^o 753


ELEVATION

OF A STEEL SCREW TRAWLER

TO CLASS 100 A.I. BY LLOYDS

DIMS. 120'0" x 21'6" x 13'6" MLD

SCALE 1/4" = 1 FT.

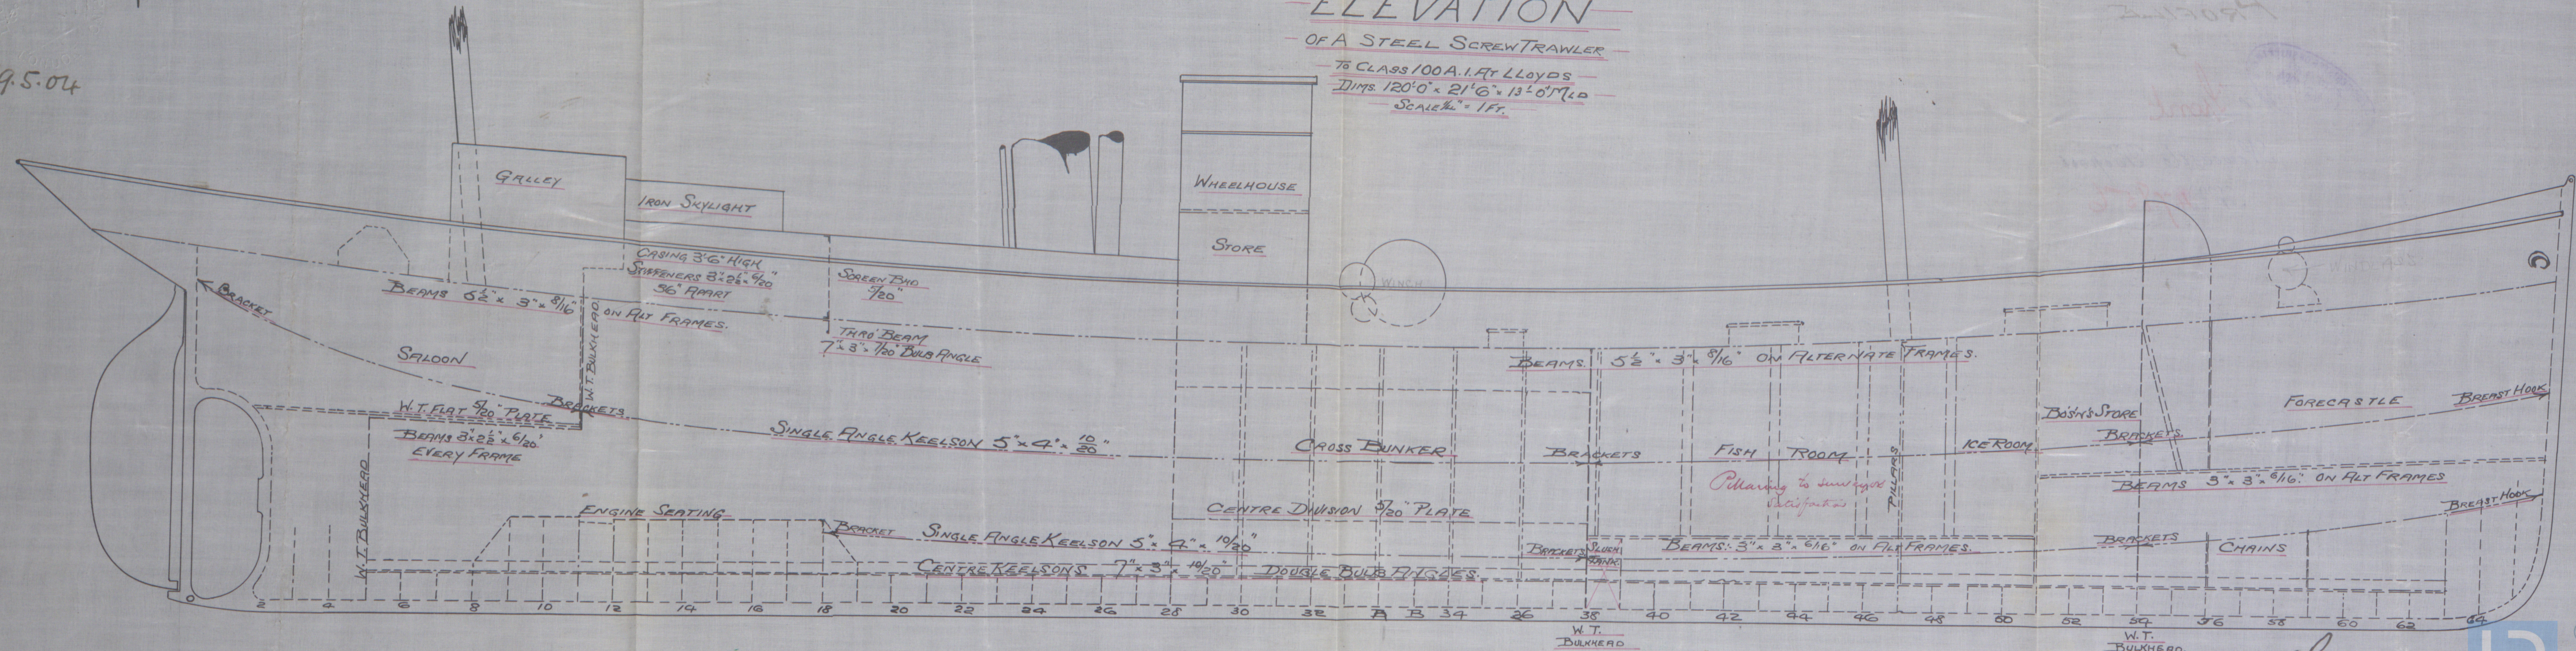

SMITH'S DOCK CO.
No 753
TRAWLER

C.B.
19.5.04.



© 2020
Lloyd's Register
Foundation

WIZIZ-0275

SMITHS DOCK CO
No 753
PROFILE



Newcastle Report

No 147.856



Lloyd's Register
Foundation

WIZIZ-0275