


REGISTER OF SHIPS

11. 5. 14

— No 155. —
— PROFILE & DECK PLAN —


— 1/4" = 1 Foot. —

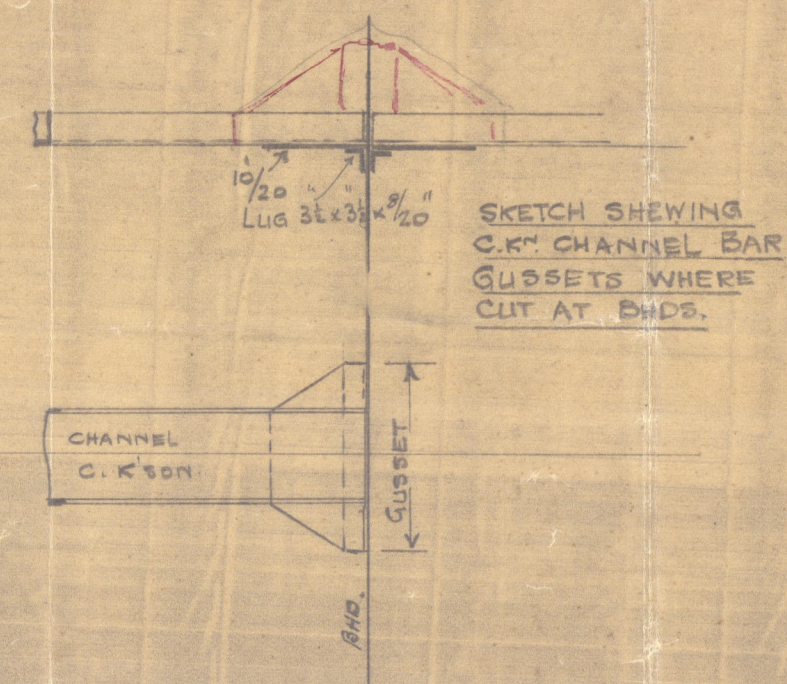

NOTE:—

SIDE STR. ANGLES STOPPED AT W.T. B.H.D.s.
& BRACKETED AT EACH SIDE
OF KELSON CHANNEL STOPPED AT W.T. B.H.D.s.
& BRACKETED EACH SIDE.

SEE MID. SECTION
FOR SCANTLING.

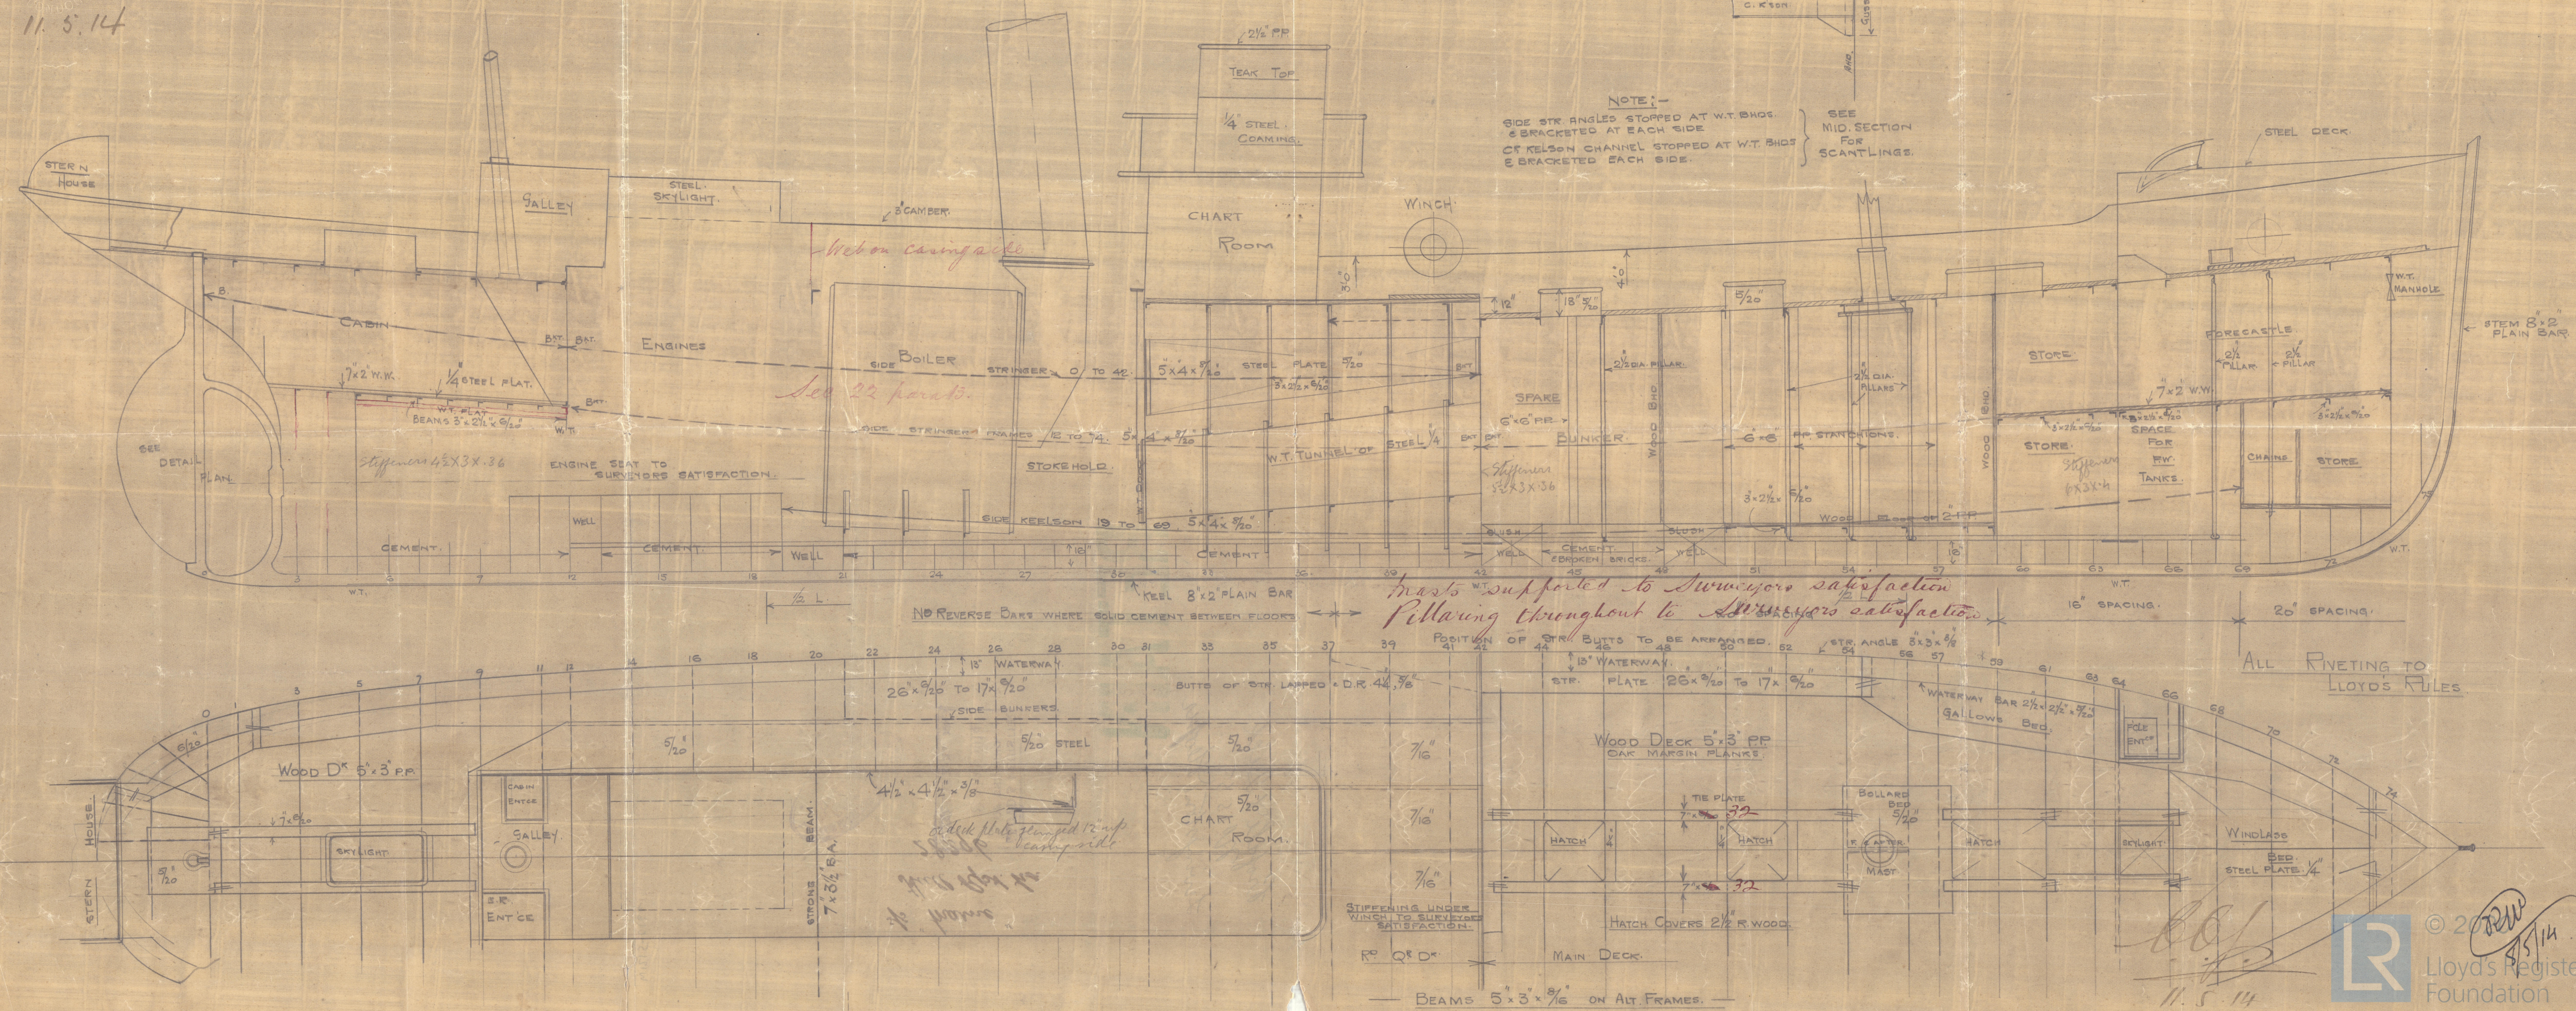

*Masts supported to Surveyors satisfaction
Pillaring throughout to Surveyors satisfaction*

ALL RIVETING TO
LLOYD'S RULES.



© 2014
Lloyd's Register
Foundation

W1215-0164

Profile & Deck
No 155
Livingstone Hooper

s/s "maene"
Hull Rpt. No.
28296

LLOYD'S REGISTER
OF SHIPPING
2 MAY 1914
LONDON



© 2020

Lloyd's Register
Foundation

W1215-0164