

10073  
messrs Lloyd's Surveyors  
Hull

# PROFILE & DECK PLAN

STEEL SCREW TRAWLERS

N<sup>os</sup> 489-90-1



DIM<sup>ns</sup> LEN 131'8" X 23'0" EX X 12'9" DEPTH MOULDED

SCALE 1/4" = ONE FOOT

PLAN No. 673  
FOR ENCLOSURE TO  
Messrs Lloyd's Surveyors  
Hull FROM  
COCHRANE & SONS.  
SHIPBUILDERS, SELBY  
DATE Sept 21 11

10073  
messrs Lloyd's Surveyors  
Hull

10/2/11 R.R.

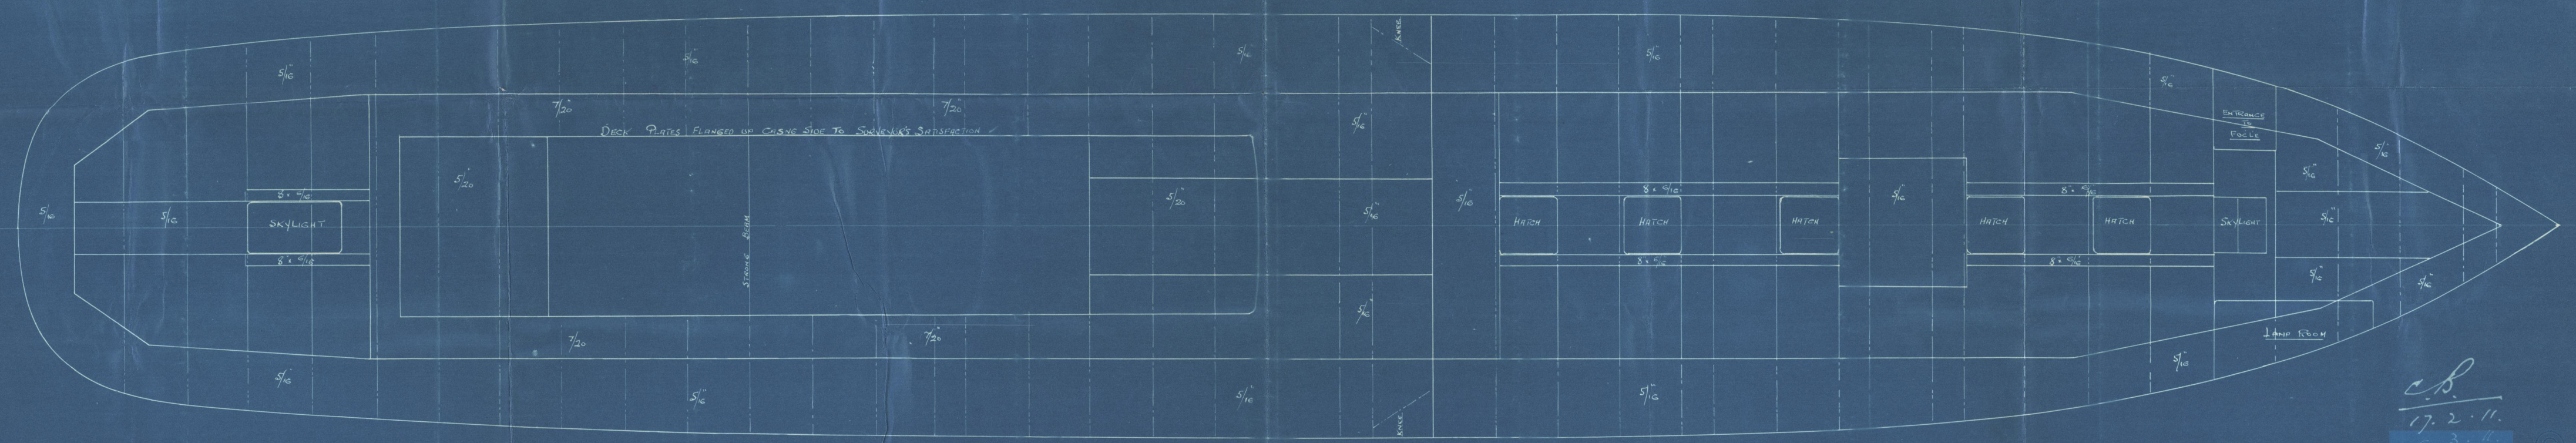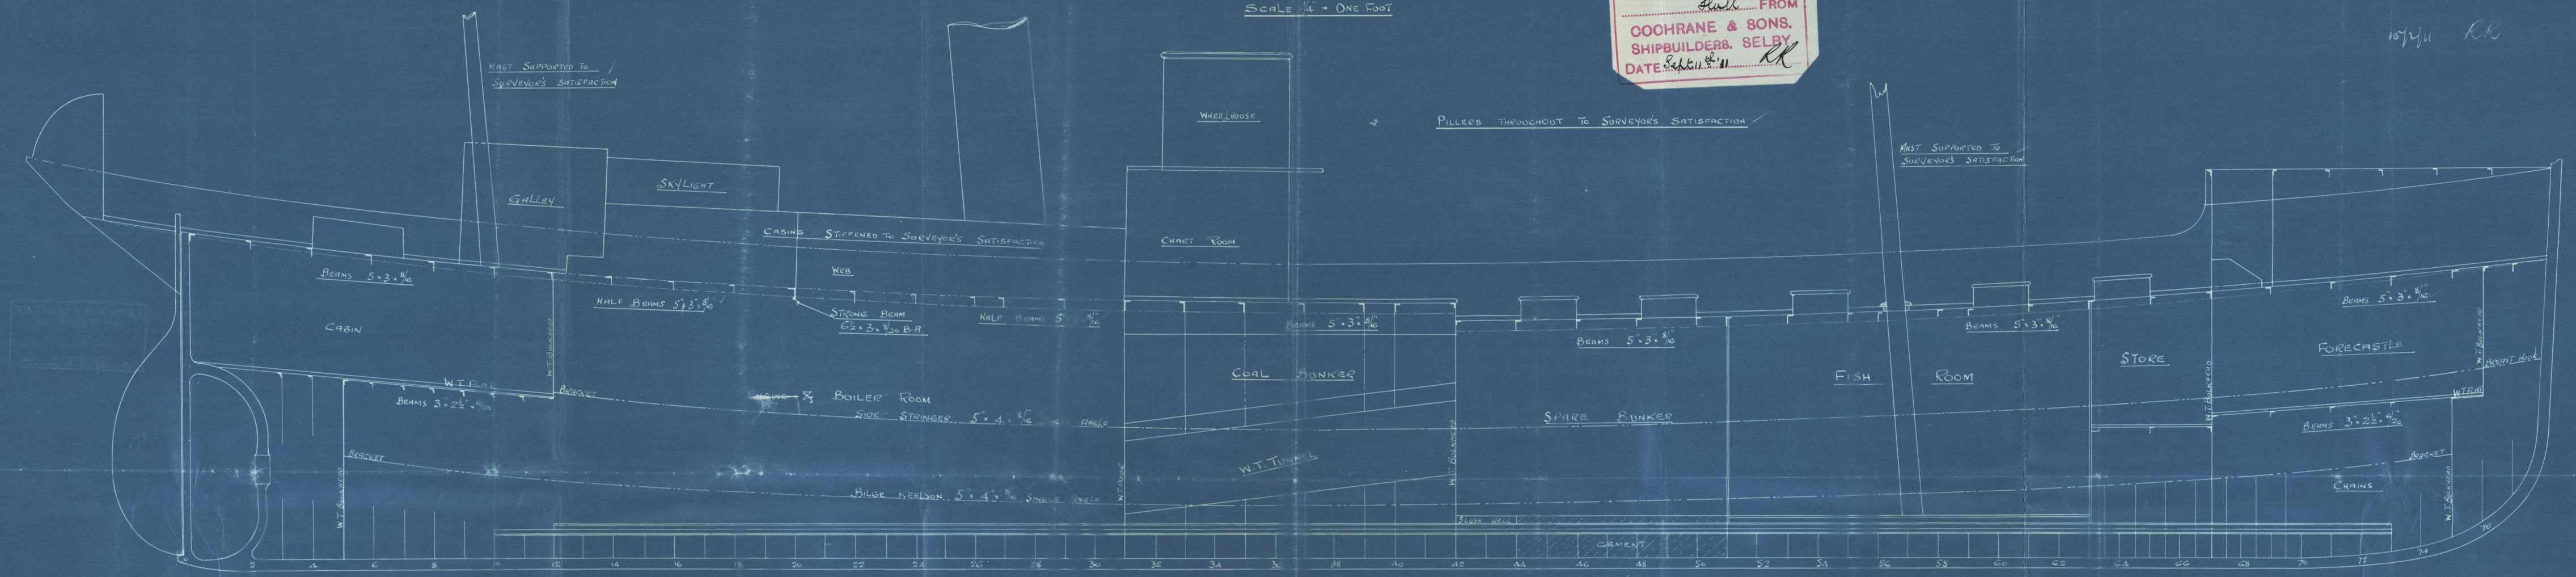

C.B.  
17.2.11.  
18.3.11.



© 2020  
Lloyd's Register  
Foundation  
W218-0046



Cochrane & Sons.

N<sup>os</sup> 489 - 490 - 491

Duplicate

Profile and Deck Plan.

S.S. "Lord Salisbury". Hull Rpt. N<sup>o</sup>. 24208

"Michael Angelo". " " " 24222

"Lord Knollys". " " "

RETAIN



© 2020

Lloyd's Register  
Formulation  
W1216-0140