


16 **APPROVED**

- Midship Section
book "Wilton Gemmels"
No 86

of Chief Cabin
Hull Report No. 17419

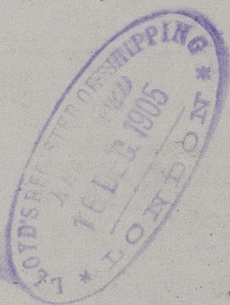

W1218-0045

RETAIN



© 2019

Lloyd's Register
Foundation