

S. S. № 460<sup>г</sup>/Б. 435' x 55' x 31' К. 70 Б.

LLOYD'S 100 A1. CLASS.


Jm.  
 15-12-15  




Harland & Wolff Ltd

Nº 460 G/B.

Amended Profile

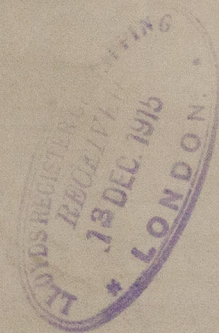

GLASGOW REPORT No. 36829.

<sup>8</sup>/<sub>5</sub> Millias

n.n. Scottish Star



© 2020

Lloyd's Register  
Foundation

W122-002