

15.12.15.

MIDSHIP SECTION


SS N° 460 $\frac{9}{16}$ B-435'-0" x 55'-0" x 31'-0" K to S. UPPER DECK.

SCALE 1/2" = 1' 0"

LLOYD'S 100 A1 CLASS.

A=0 55'-00" 85'08" ST. W. H. C. R. L.
L. 5'-3" 135'85'08" 37010 2nd
10 1142 SHUTTER DECK
10 9.14 BRIDGE
2 1500 AT 8

EQUIPMENT NUMBER
L. 3+0 37010
EFFECTS 3830
40840

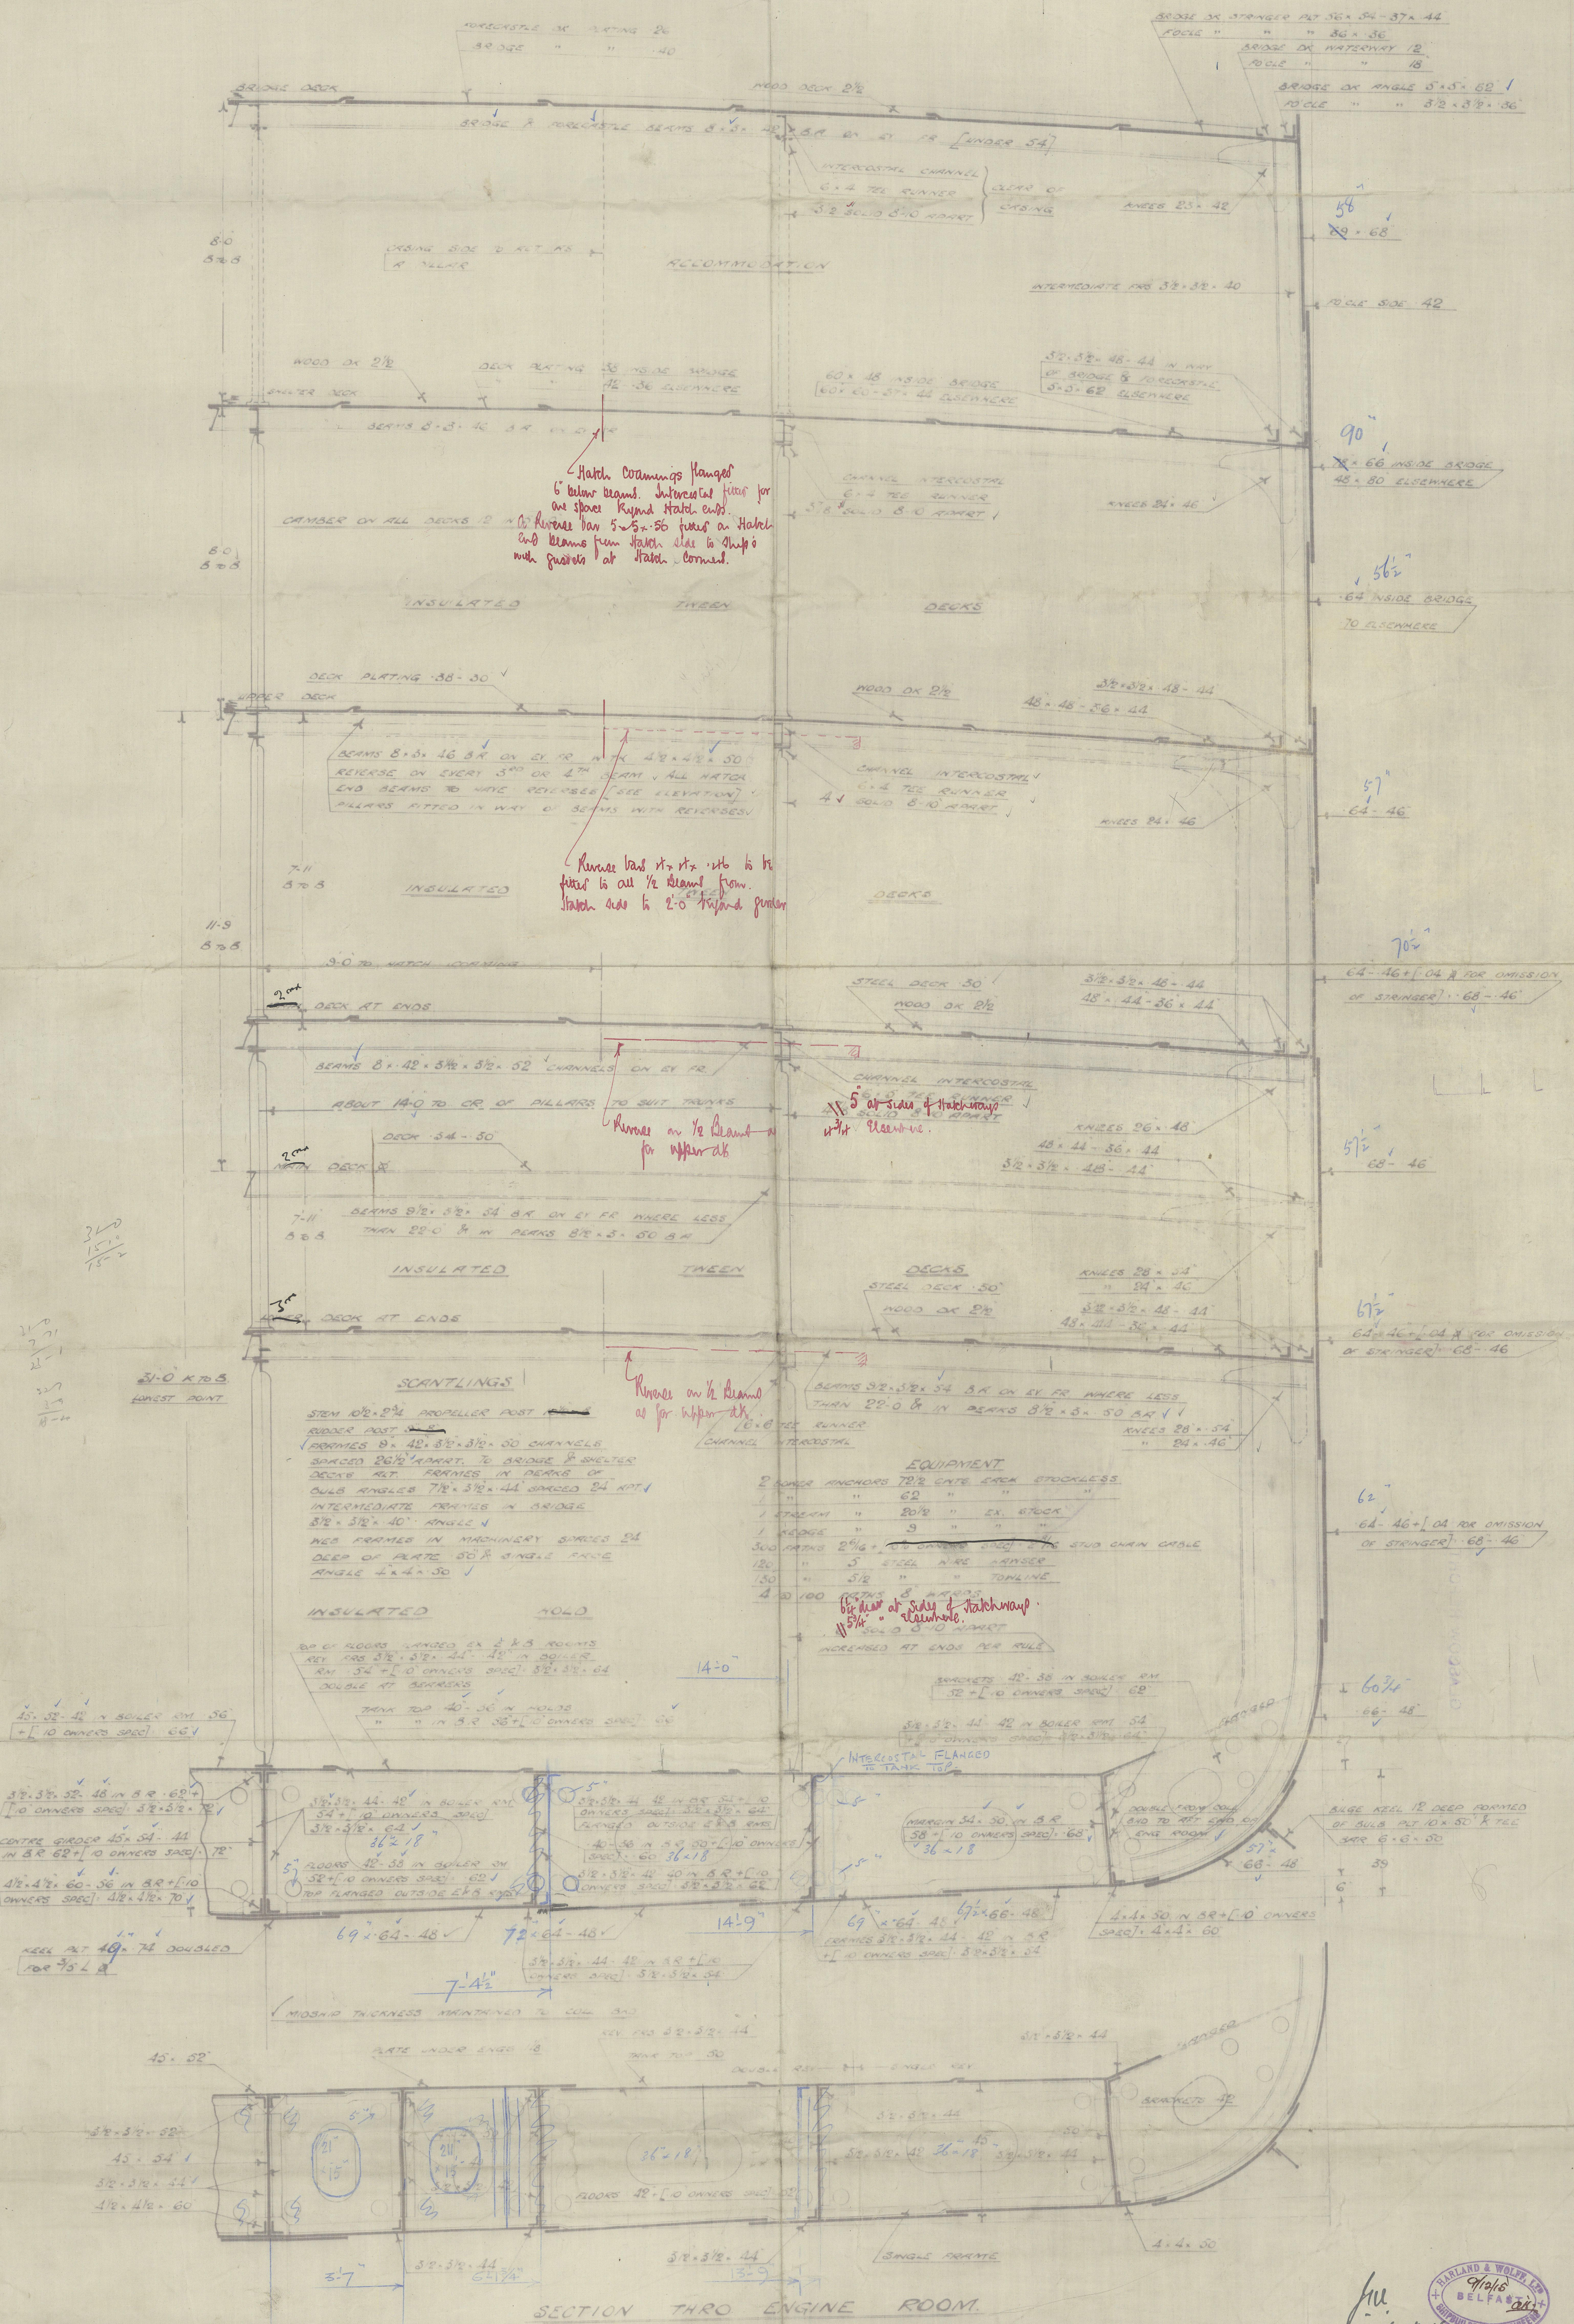

15.12.15.

Harland & Wolff Ltd.


Nº 460 G/B

Amended Midship Section

GLASGOW REPORT No. 36829

^{S/S} Millias

n.n. *Scottish Star*

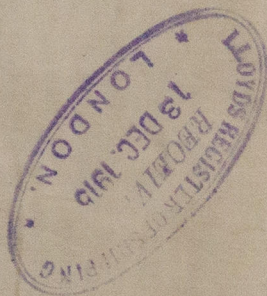

© 2020

Lloyd's Register
Foundation

W122-002