


No. 49.

LONGITUDINAL SECTION W.T. BULKHEADS PAINTING ARRANGEMENT
DEEP TANKS STRENGTHENING OF BOTTOM FORWARD

BULKHEAD NO. 55

DIMENSIONS: 306-0 B.P. x 45-0 M.D. x 24-3 M.D. TO UPPER DECK
TO CLASS AT LLOYD'S 100 A.I. WITH FREEBOARD
SCALE 1/8" = 1'00"

NO SHEER ON FREEBOARD DECK EXCEPT THAT DUE TO IF CAMBER
MINIMUM SCANTLING REQUIRED

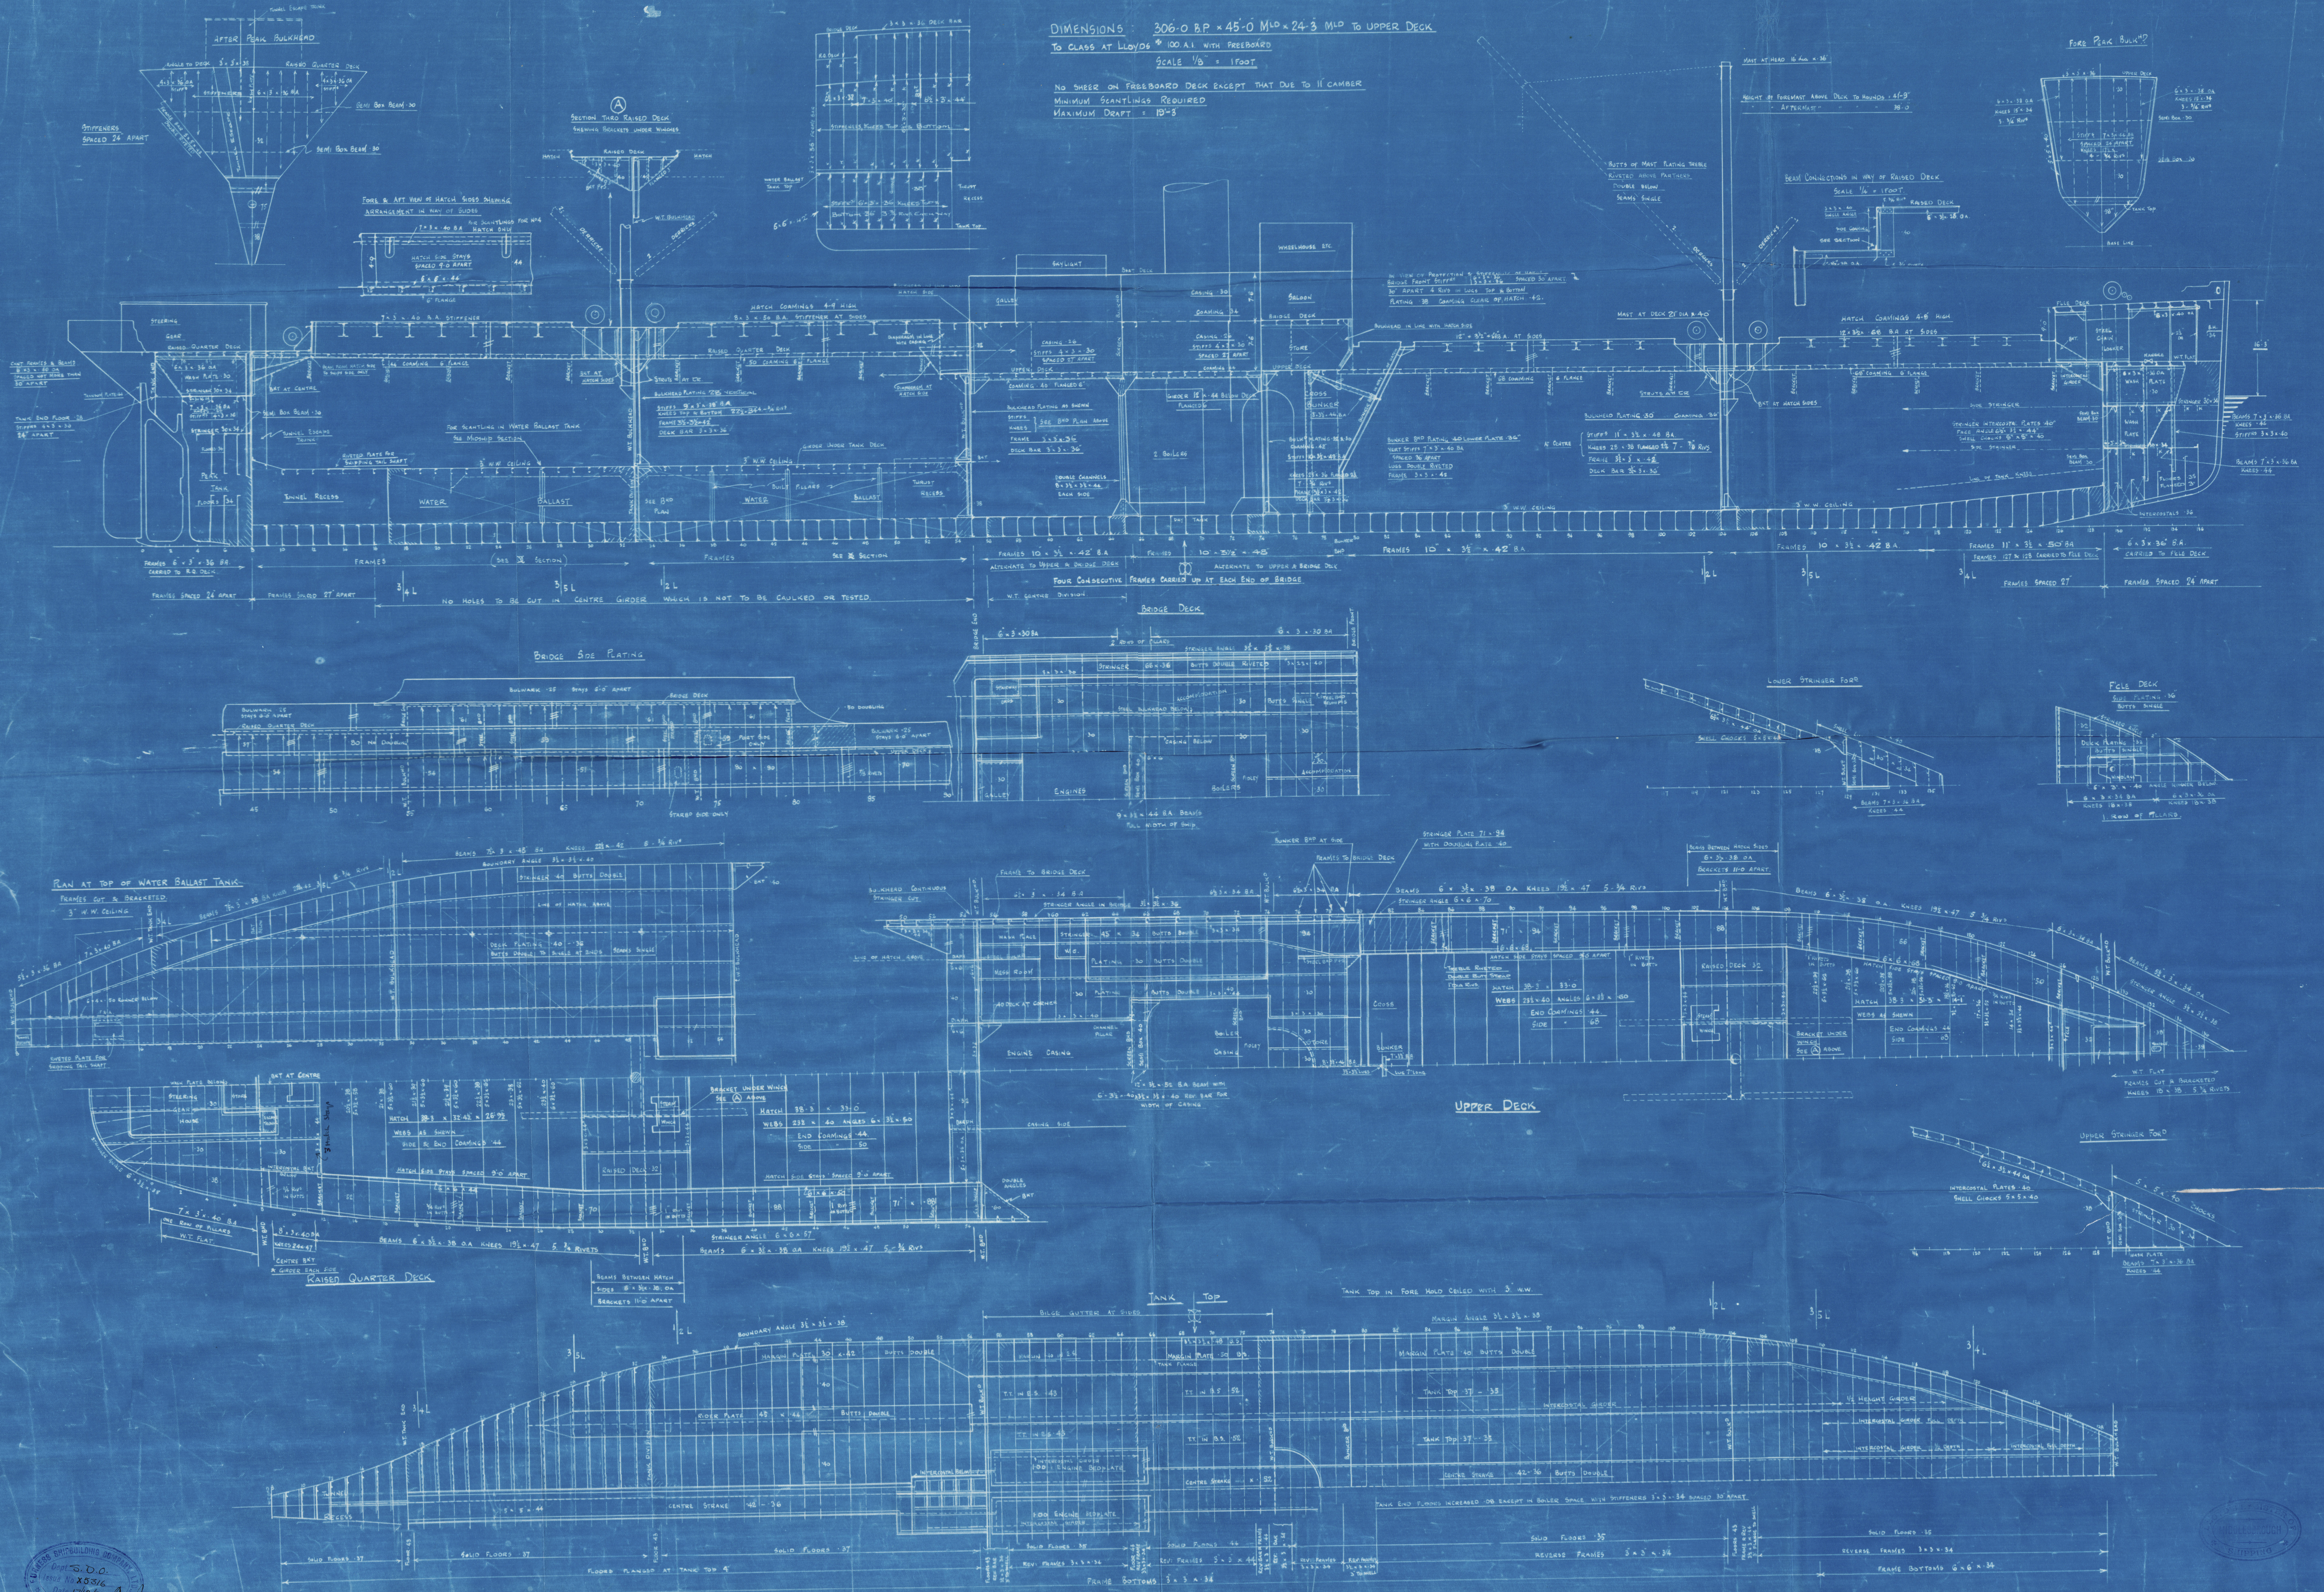

Furness } N. 49
Shute & Co } S.S. Throckley

Profile & Deck Plans
as built.

306' x 45' x 24-25' upper D.

Indoleobouge Report
No. 11786

Now

JANA

EX. MELITA -

D. 106. B

RETAIN



© 2020

W1220-0240

Lloyd's Register
Foundation