

SCANTLING VOS

$B+D = 36.03$ TRANSVERSE ✓

$L \times (B+D) = 4683.9$ LONGITUDINAL ✓

$\bar{L} = 11.83$ ✓

$B = 22.87$ ✓

$\frac{L}{B} = 9.8$ ✓

NUMERAL FOR RUDDER 62.01. ✓

SPEED $10\frac{1}{2}$ KNOTS ✓

6.2.15

N^o 320

MIDSHIP SECTION

SCALE $\frac{1}{2}$ " = 1 FOOT

DIMENSIONS: - 130'-0" BP x 23'-0" EX x 13'-2" DEPTH 12'-5" HOLD ✓

CLASS 100A.1.

STEAM TRAWLER.

STEEL

EQUIPMENT

1 ANCHOR $7\frac{1}{4}$ CWT STOCKLESS. ✓


1 " $5\frac{1}{4}$ " EX STOCK ✓

1 " 3 " " " ✓

105 FTMS $1\frac{1}{16}$ " STUD LINK CABLE ✓


60 " 6 " HANSE. ✓

60 " 5 " WARP. ✓

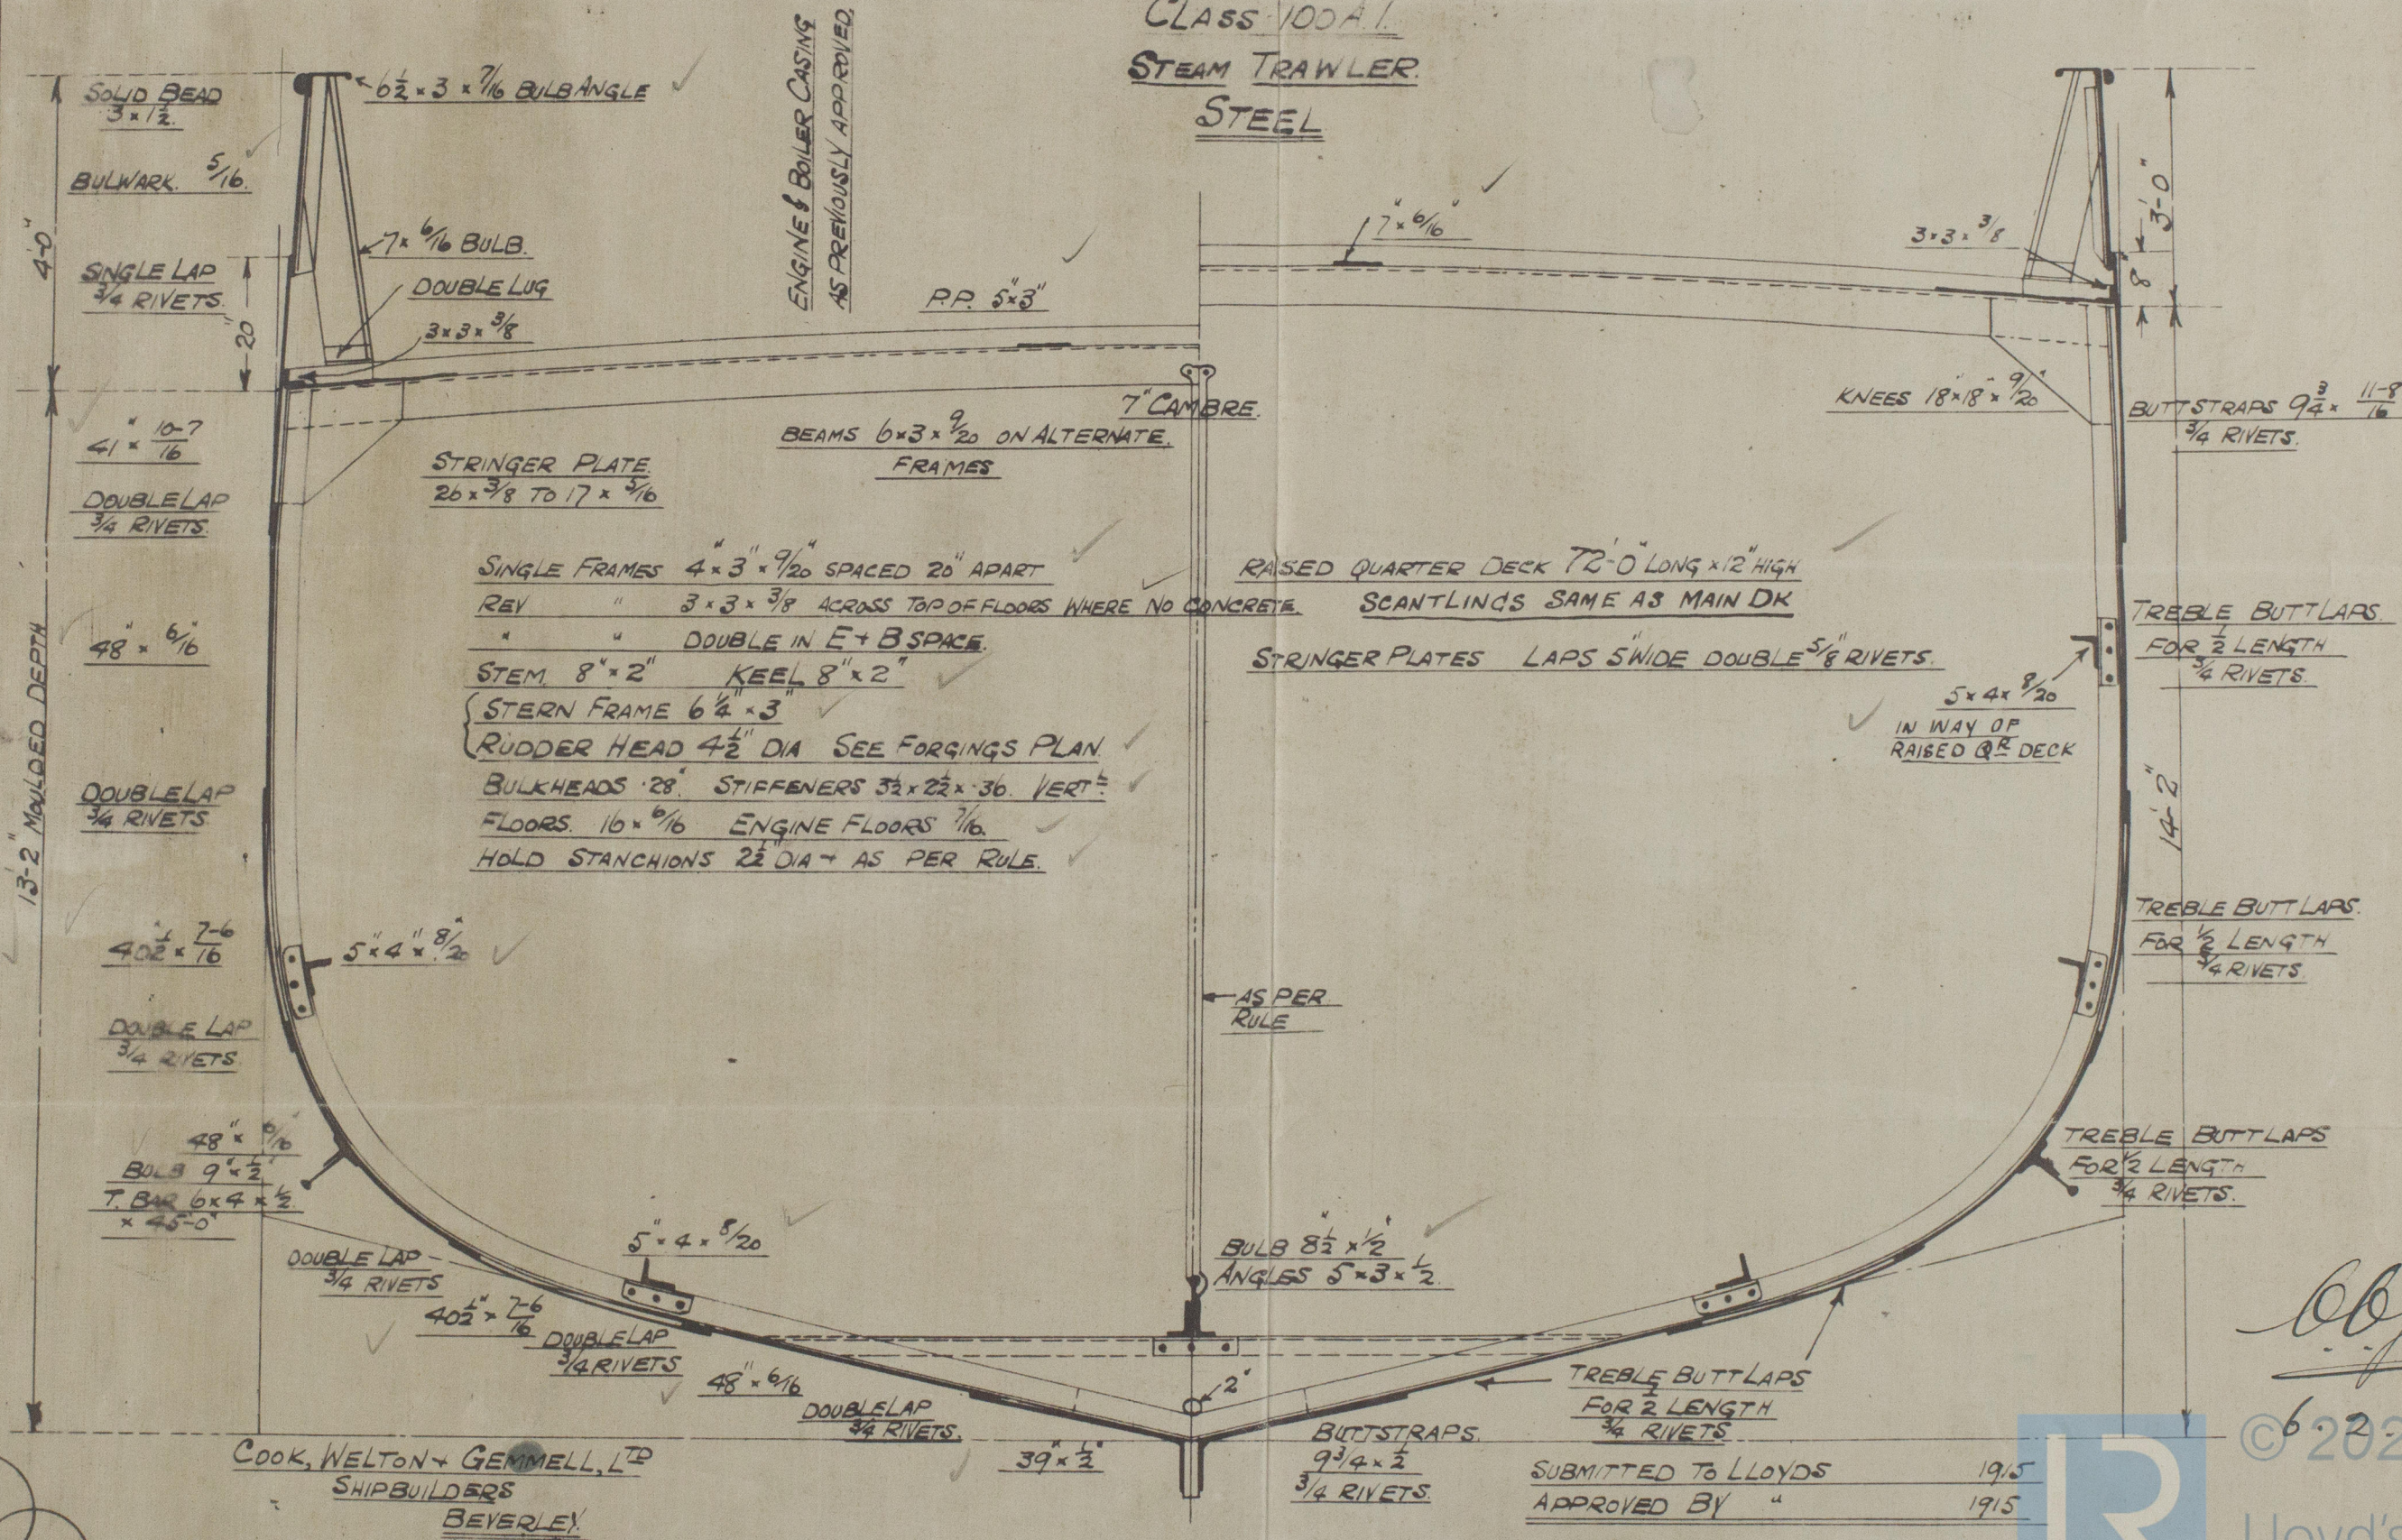

ccf.

© 2020

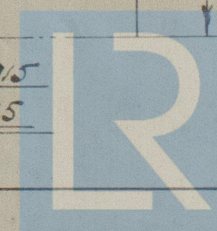

Lloyd's Register
Foundation
W1223-0031

Book, Welton & Gemmell.
Vessel number 320.

Plan of
Midship Section.



55 "SESOSTRIS" HULL
REPORT No 29280



© 2020

Lloyd's Register
Foundation
W1223-0051