




22/2/15

| DIMENSIONS.            |           |
|------------------------|-----------|
| LENGTH OF FIRE BARS    |           |
| AREA OF FIRE GRATE     |           |
| DIAM. OF TUBES OUTSIDE | 3 1/2     |
| LENGTH OF TUBES        | 6'-3 3/4  |
| NO. OF TUBES           | 190       |
| SURFACE OF TUBES       | 1166      |
| TOTAL HEATING SURFACE  | 1520      |
| WORKING PRESSURE       | 200 LBS   |
| DIAM. OF SAFETY VALVE  | 2 1/2 DIA |

LONGITUDINAL JOINT TREBLE RIVETTED DOUBLE BUTT STRAPS  
CIRCUMFERENTIAL JOINT DOUBLE RIVETTED LAP JOINT

MANHOLE IN SHELL 16" X 12" LINED  
INSIDE WITH PLATE 7" WIDE 1/4" THICK

HOLES DRILLED 1 1/2" DIA  
PLATE % 84.8 THICKNESS OF INSIDE STRAP 1 1/2"  
RIVET % 87.4 " OUTSIDE 1 3/8"

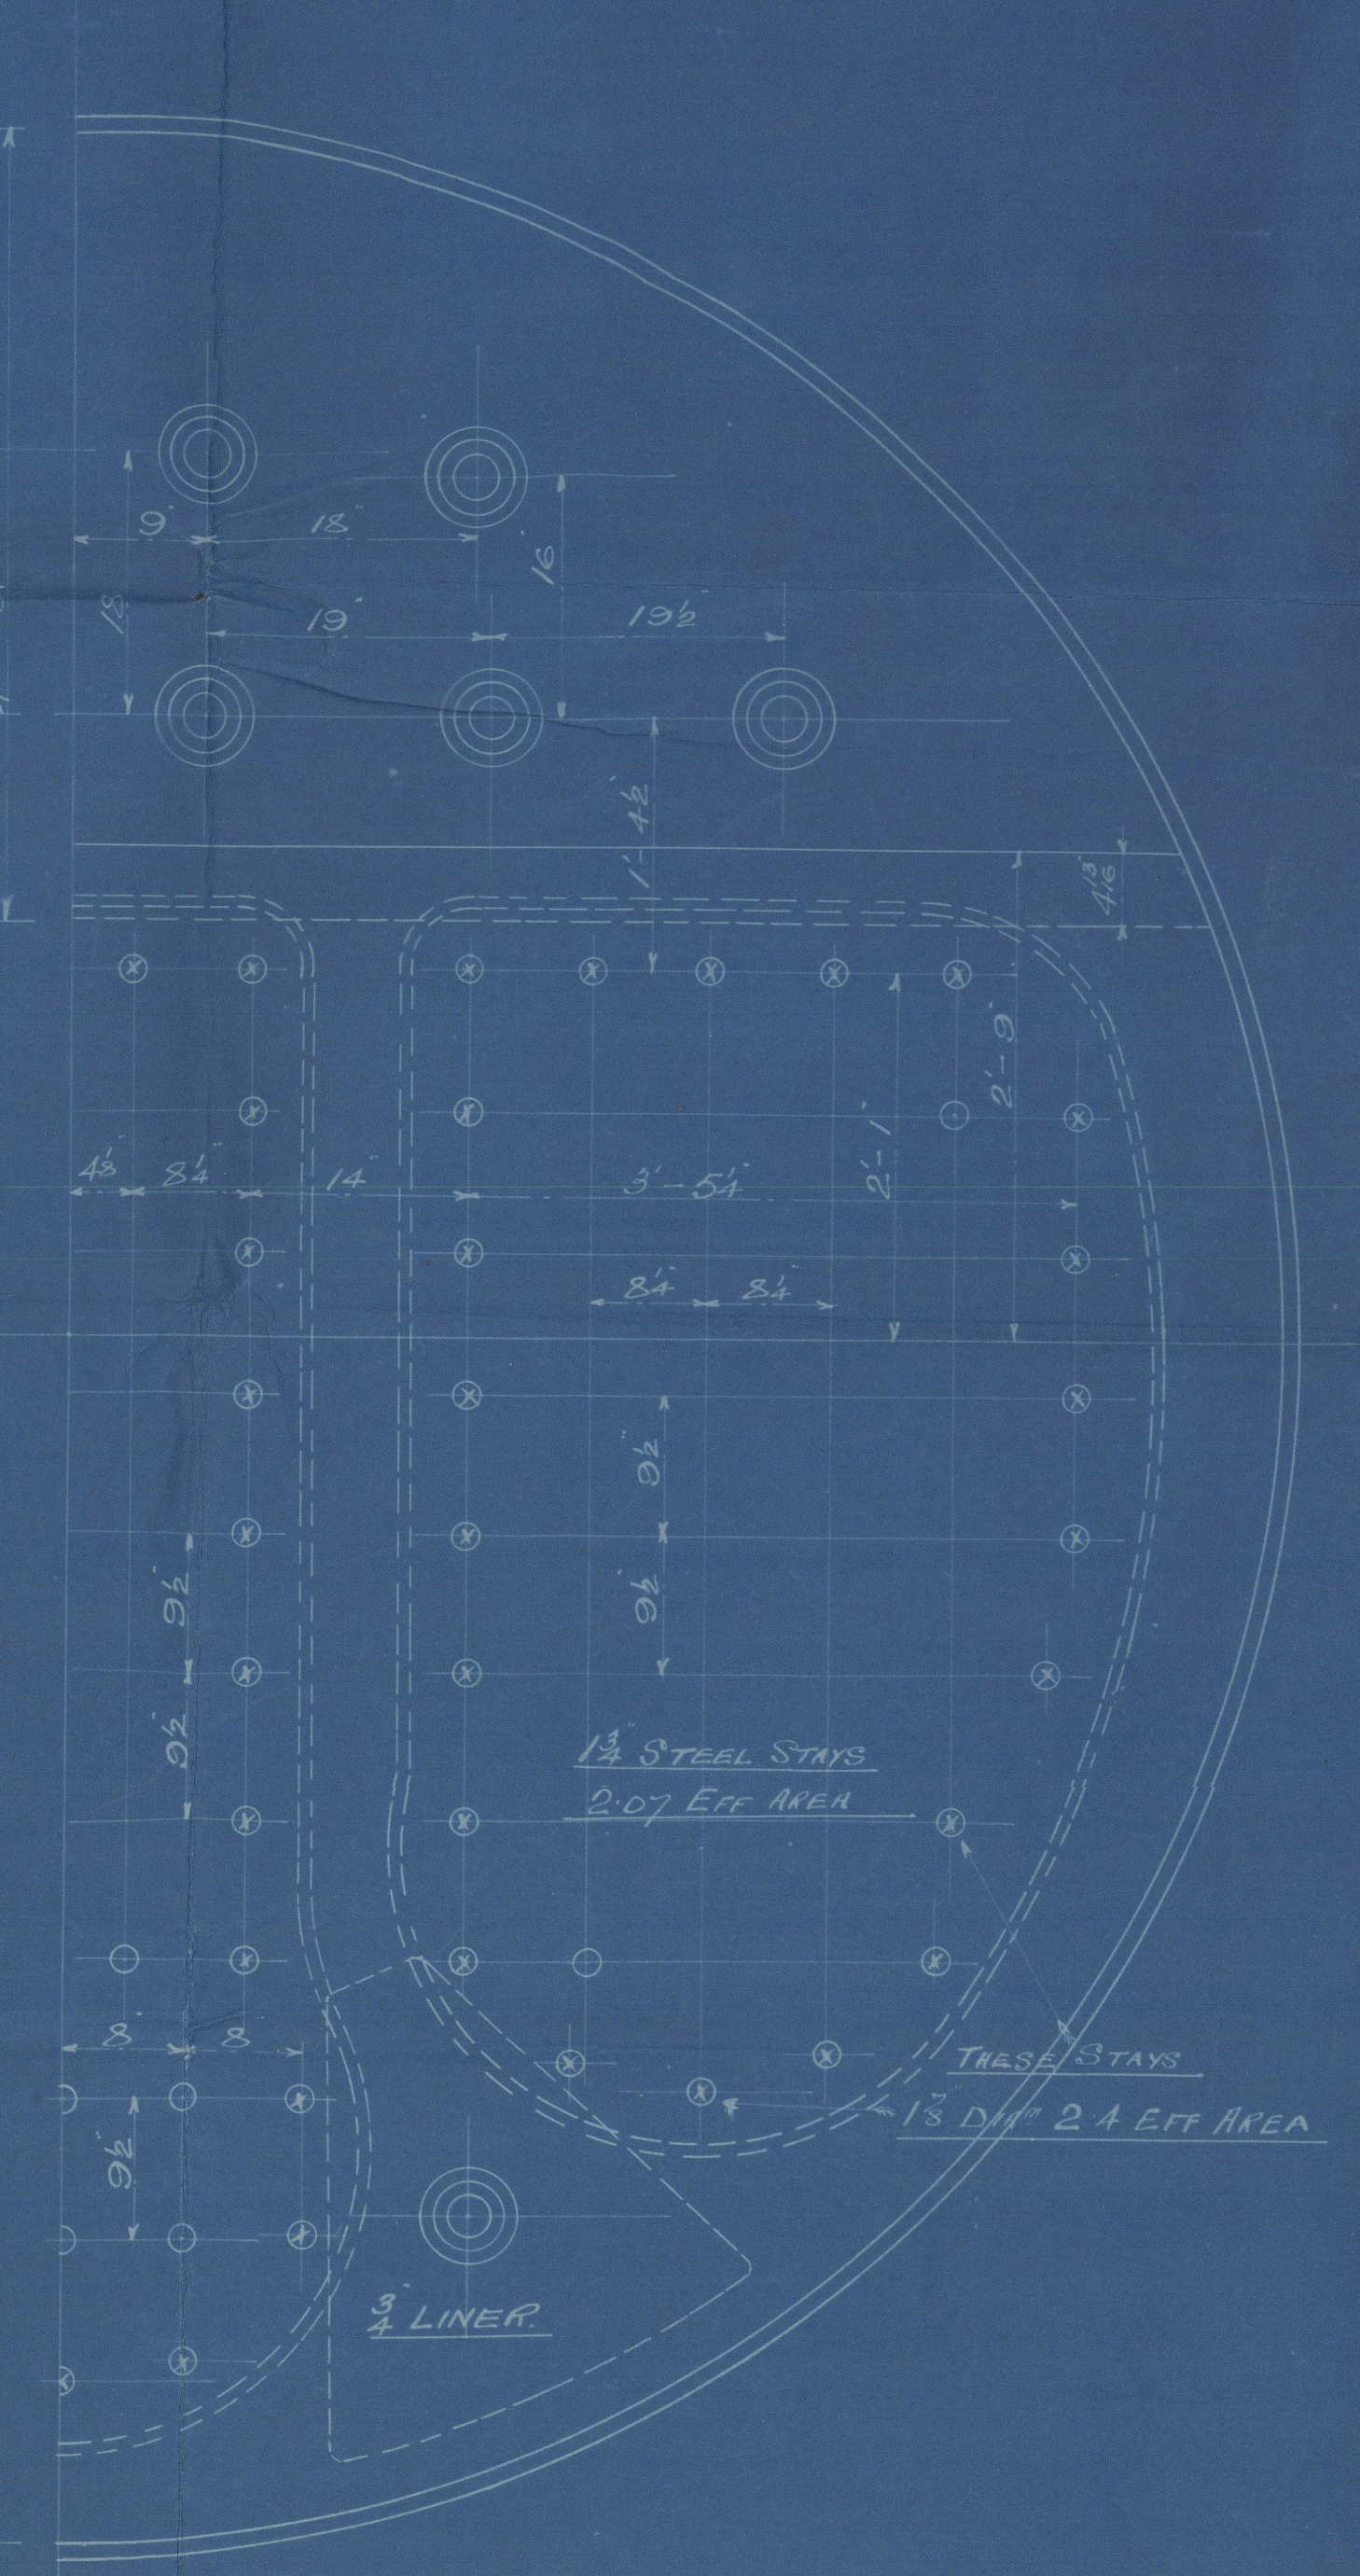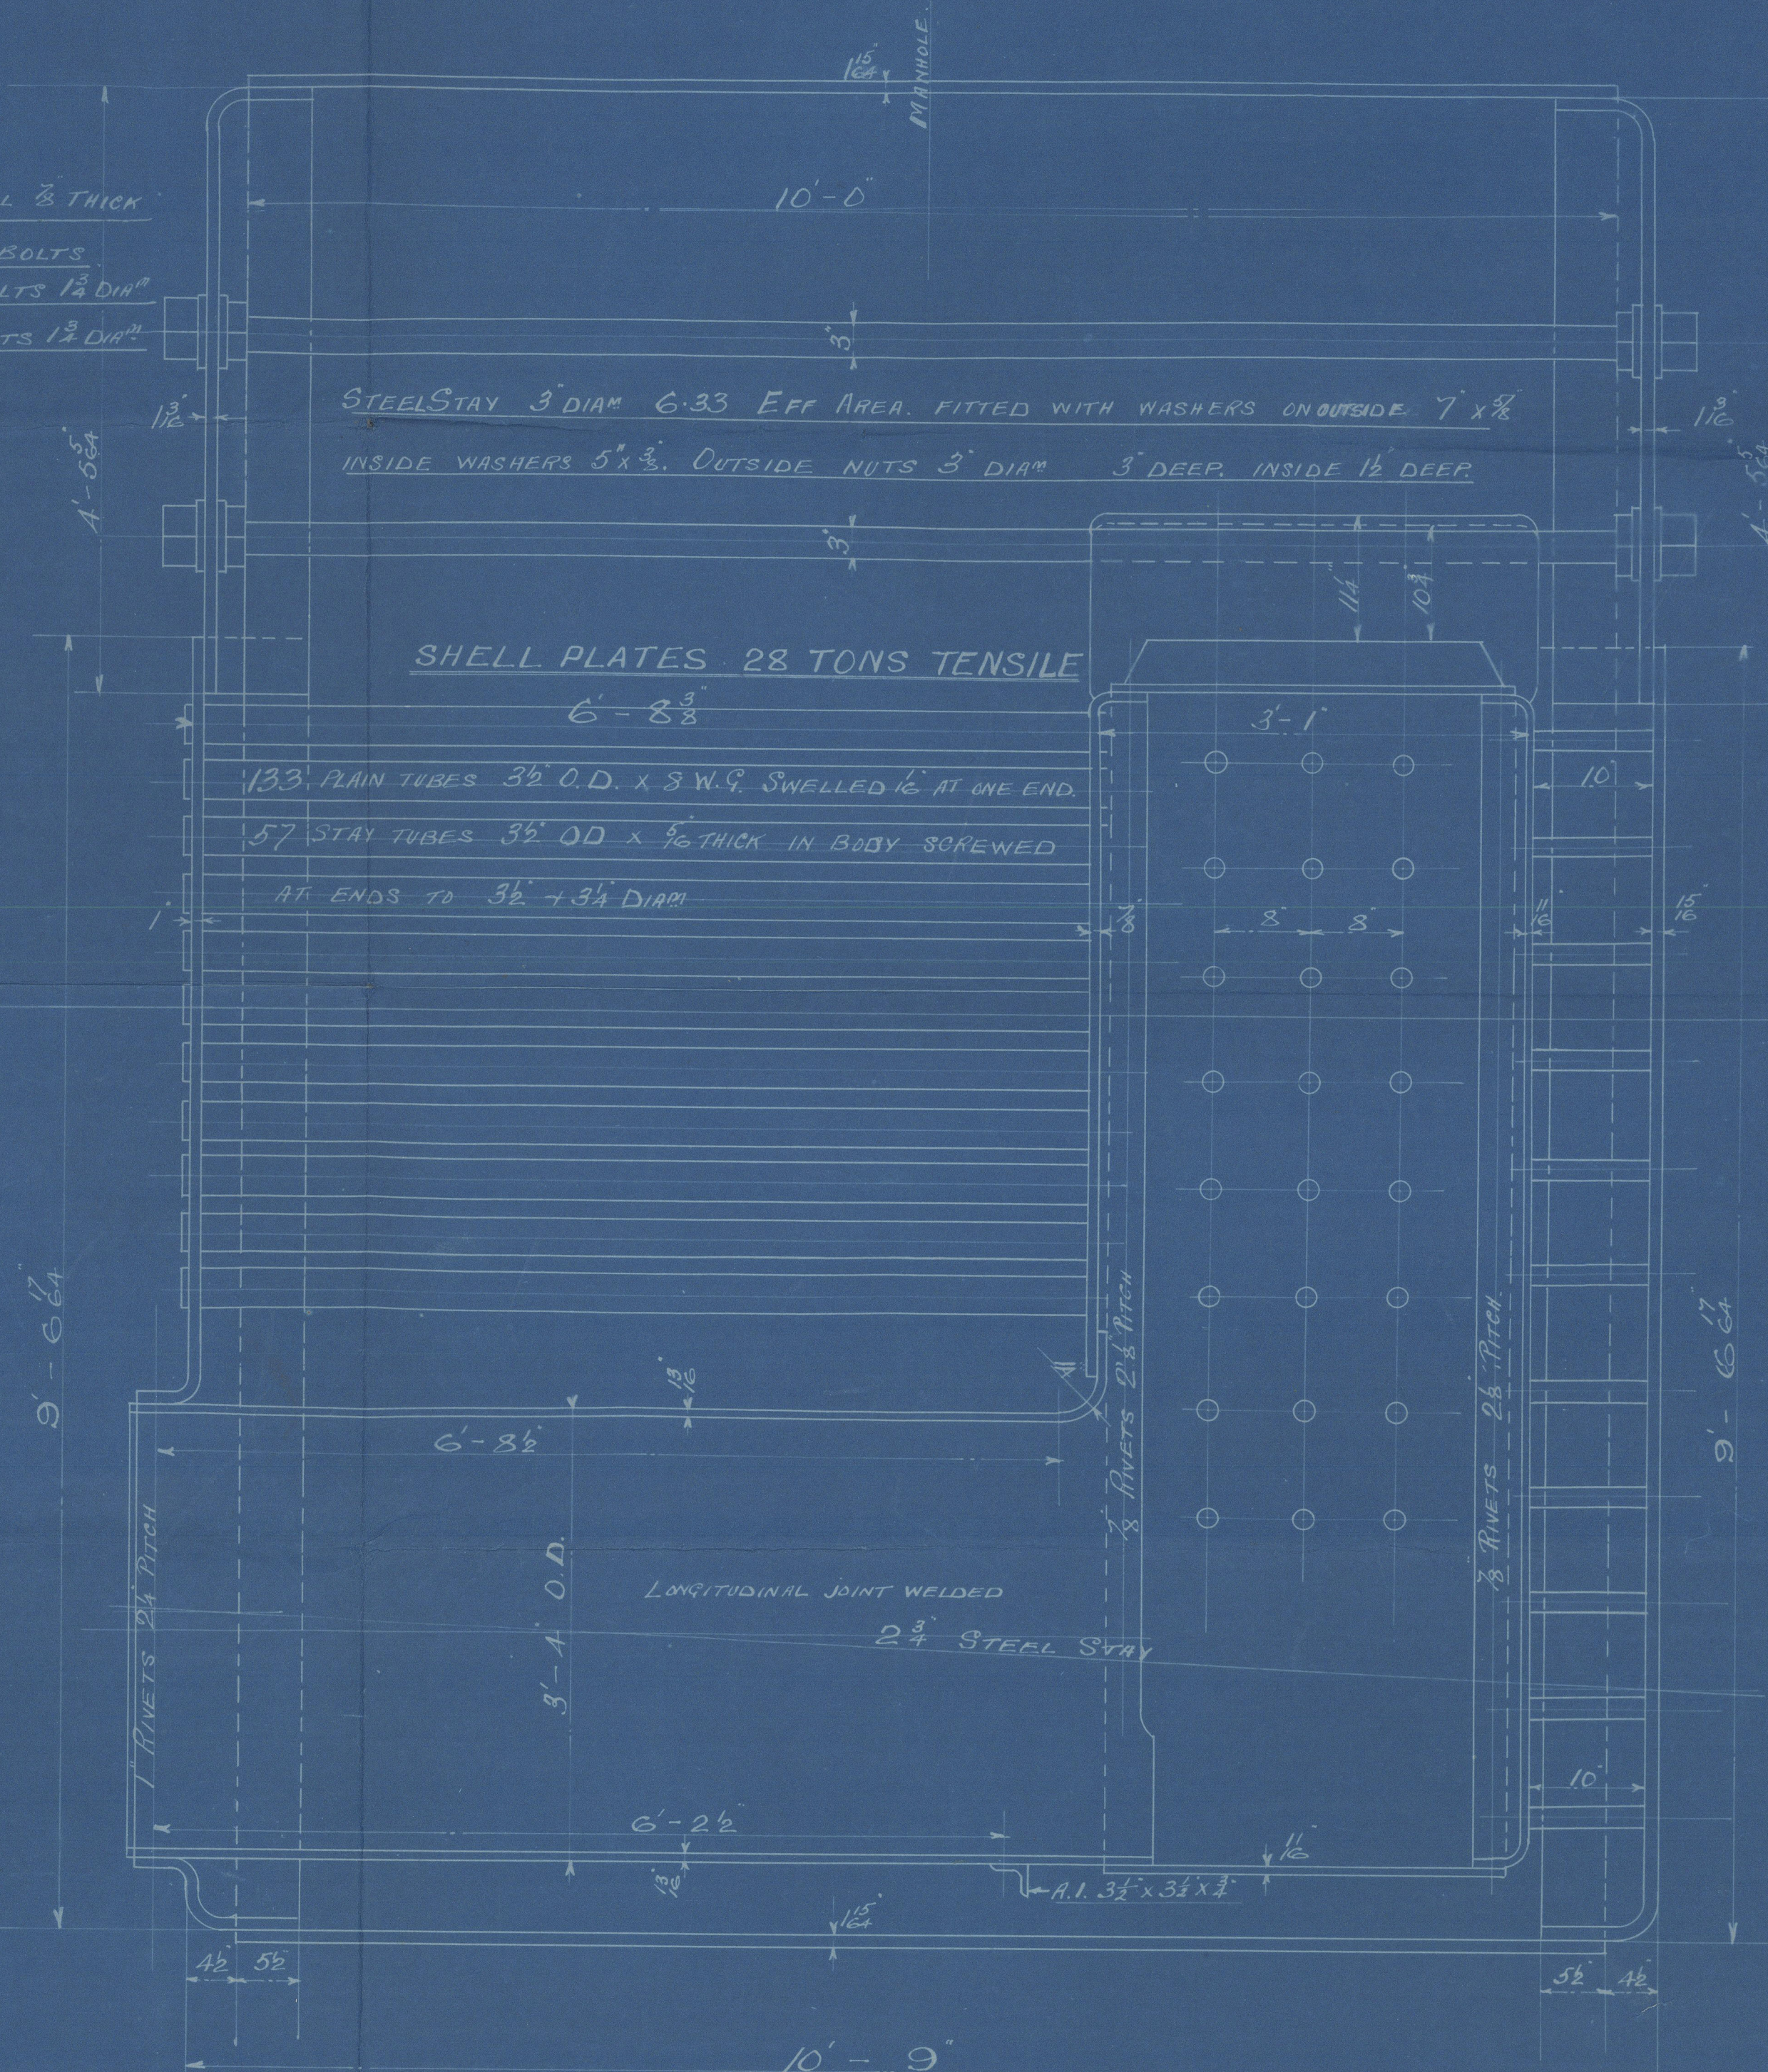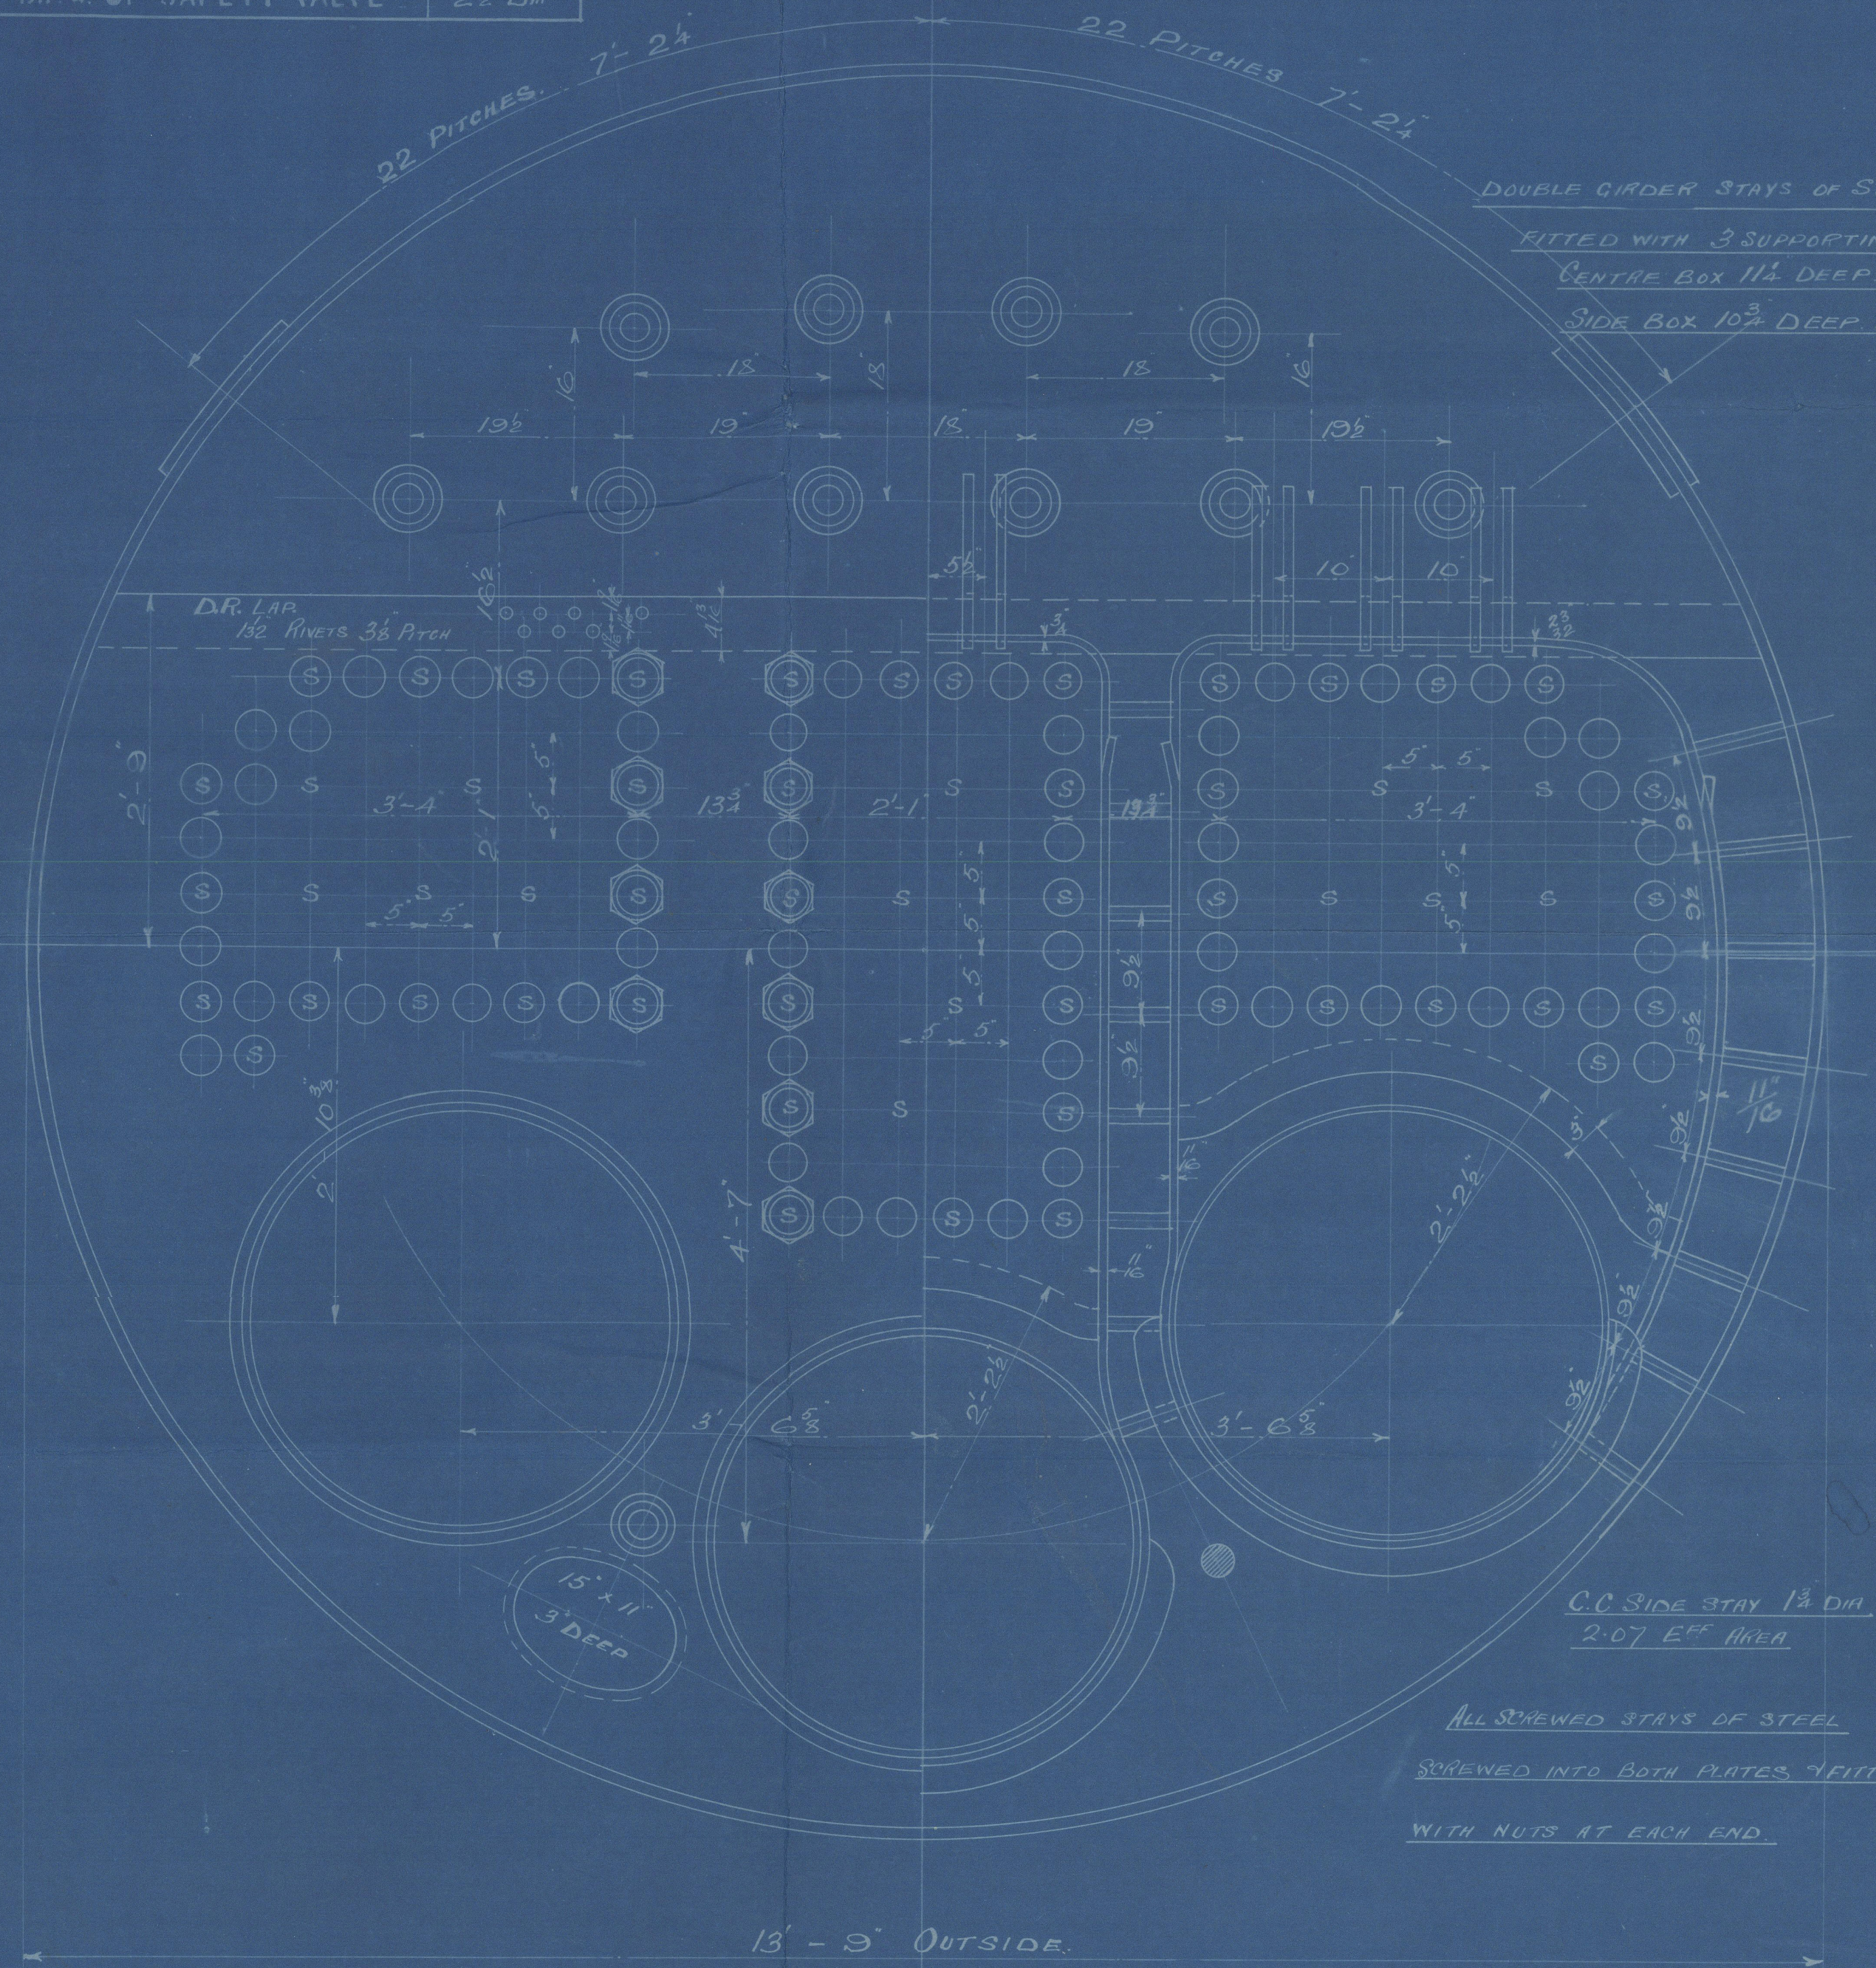

BOILER N° 1118

PLAN N° 3620

CHARLES D HOLMES & CO LTD  
ENGINEERS & BOILER MAKERS  
No 6 17 HULL 1915.

DRAWER N° 107  
DRAWING N°

Lloyd's Register  
Foundation  
11223-0052





© 2020

Lloyd's Register  
Foundation  
J. HALDEN & CO. L.  
1761





C. D. Holmes

1118

W. P. 2000.

55. "SESOSTRIS"

HULL RPT NO 29280.

No 3124  
Lloyd's list  
L 1000  
25-2-16 FLS



RECEIVED



© 2020

Lloyd's Register  
Foundation

W 223-0252