


1.2.05  
6.2.05

11702.  
27<sup>th</sup> JANUARY 1905  
WALTER WALKER  
PETERHEAD

- N<sup>o</sup> 734 -  
- PROFILE & DECK PLANS -  
DIMENSIONS 386 PP x 30' 2" EXT x 23' 10" MLD TO SPAR DECK.  
TO CLASS 100 A.I. AT LLOYDS STRENGTHENED SPAR DECK RULE.  
SCALE 1/8" = 1 FOOT  
APPROXIMATE UNDER DECK TONNAGE = 4112

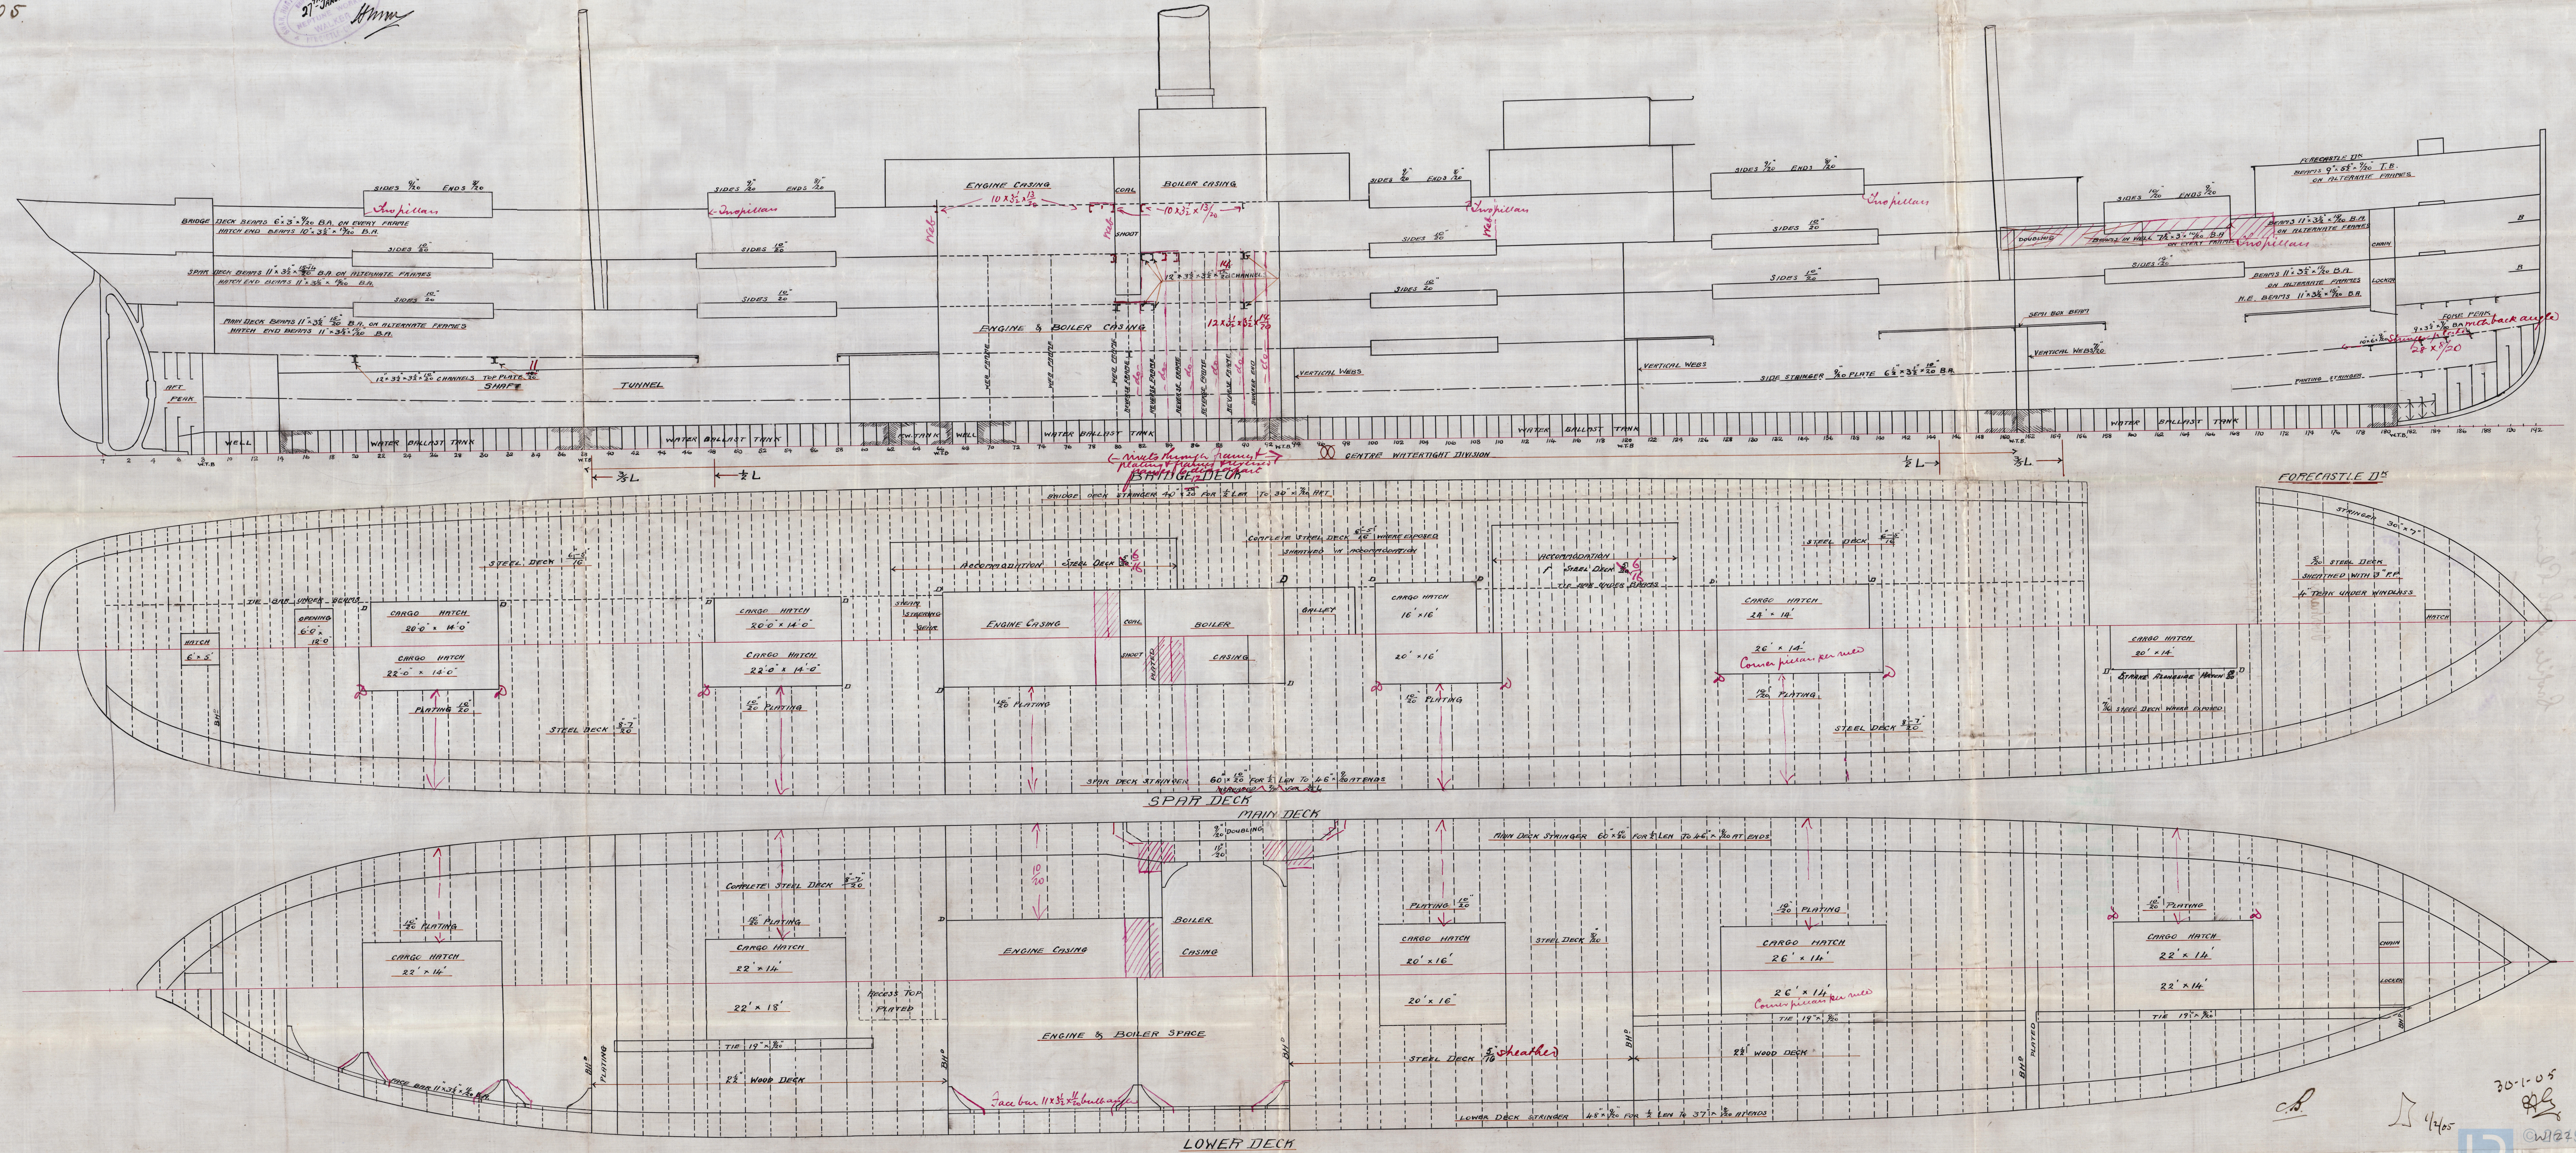



Swan Hunter Wigham Strick

N<sup>o</sup> 734 95

Profile & Plans

J. L. 'Oberhausen'.

Newcastle Report

N<sup>o</sup> 149. 1100.

RETAIN



© 2019

Lloyd's Register  
Foundation