

1-2-05
6-2-05
14-11-05

— No 734 —
— MIDSHIP SECTION —
— SCALE 1/2" = ONE FOOT —

— DIMENSIONS 386' P.P. x 50' 2" EXT. x 24' 10" M.D. TO SPAR DECK —
— TO CLASS 100 A.I. AT LLOYDS. STRENGTHENED SPAR DECK RULE —
— APPROXIMATE UNDER DECK TONNAGE = 4112 —

— LLOYDS' NUMBERS —
1/2 BREADTH. 24.98 ✓
1/2 GIRTH. 44.08 ✓
DEPTH AS PER RULE 22.92 ✓
1st NUMBER 91.98 ✓
LENGTH AS PER RULE 354.16 ✓
2nd NUMBER 35335.03 ✓

— THREE DECK NUMBERS —
1st NUMBER = 100.89 ✓ 2nd NUMBER = 38757.9 ✓
EQUIPMENT NUMBER = 46250 ✓

— PROPORTIONS —
DEPTHS TO LENGTH TO SPAR DECK = 12.44 ✓
Do TO MAIN DECK = 16.76 ✓
BREADTHS TO LENGTH = 7.68 ✓

	POOP AND BRIDGE	FORECASTLE
STRINGER PLATE	40x30 TO 30x30	30x30
STRINGER ANGLE	3 1/2 x 3 1/2 x 13/30	3 x 3 x 30
BEAMS	6 x 3 x 30 B.A. @ 24"	9 x 3 x 30 T.B. @ 24"
DECK	6 1/2 STEEL 16	5 AND 5 1/2 P.A.
SIDE PLATING	13 1/2 30	2 30

27th JANUARY 1905.


No 11701.

EQUIPMENT NUMBER = 46250.

- 2 BOMER ANCHORS STOCKLESS EACH 57 CENTS.
- 1 BOMER ANCHOR STOCKLESS 56 1/2 CENTS.
- 1 STEERING EX. STOCK 16 1/2 CENTS.
- 1 KEDGE EX. STOCK 7 CENTS.
- 270 FATHOMS 2 1/2" STUD CHAIN CABLE.
- 1 @ 40 FATHOMS STEERING 4 1/2" STEEL WIRE.
- 1 @ 120 FATHOMS 4 1/2" STEEL WIRE TOWLINE.
- 2 @ 90 Do 2 1/2" STEEL WIRE HANSEY.
- 2 @ 90 Do 2 1/2" Do Do Do.

— WATER-TIGHT BULKHEADS —
LOWER HALF 30. UPPER HALF 30 ✓
VERTICAL STIFFENERS 7 1/2 x 3 1/2 B.A. @ 30. NO HORIZONTALS.
ALTERNATIVE ARRANGEMENT OF PLATED RATING SEE BELOW.
TWO VERTICAL KEELS AND CENT. BOX BEAMS AS PER PROFILE.
SHORT TUNNEL 30 INCREASED TO 30 UNDER HATCHES.
STIFFENERS 4 x 3 1/2 ANGLES @ 45 AND 30 UNDER HATCHES.

ARRANGEMENT OF PLATED BULKHEAD PLATES.
NO HORIZONTALS. PLATING 30 1/2.
IN HOLDS 9 FLANGES WITH INTERMEDIATE STIFFENERS
7 1/2 x 3 1/2 BULB ANGLES. SPACED AS SHOWN.
THREE DECK BULKHEADS. PLATES 30 FLANGES 3 1/2 DEEP.
INTERMEDIATE STIFFENERS 4 1/2 x 3 1/2 ANGLES.
LOWER THREE DECK PLATES 6 1/2 DEEP.
INTERMEDIATE STIFFENERS 6 x 3 1/2 ANGLES.

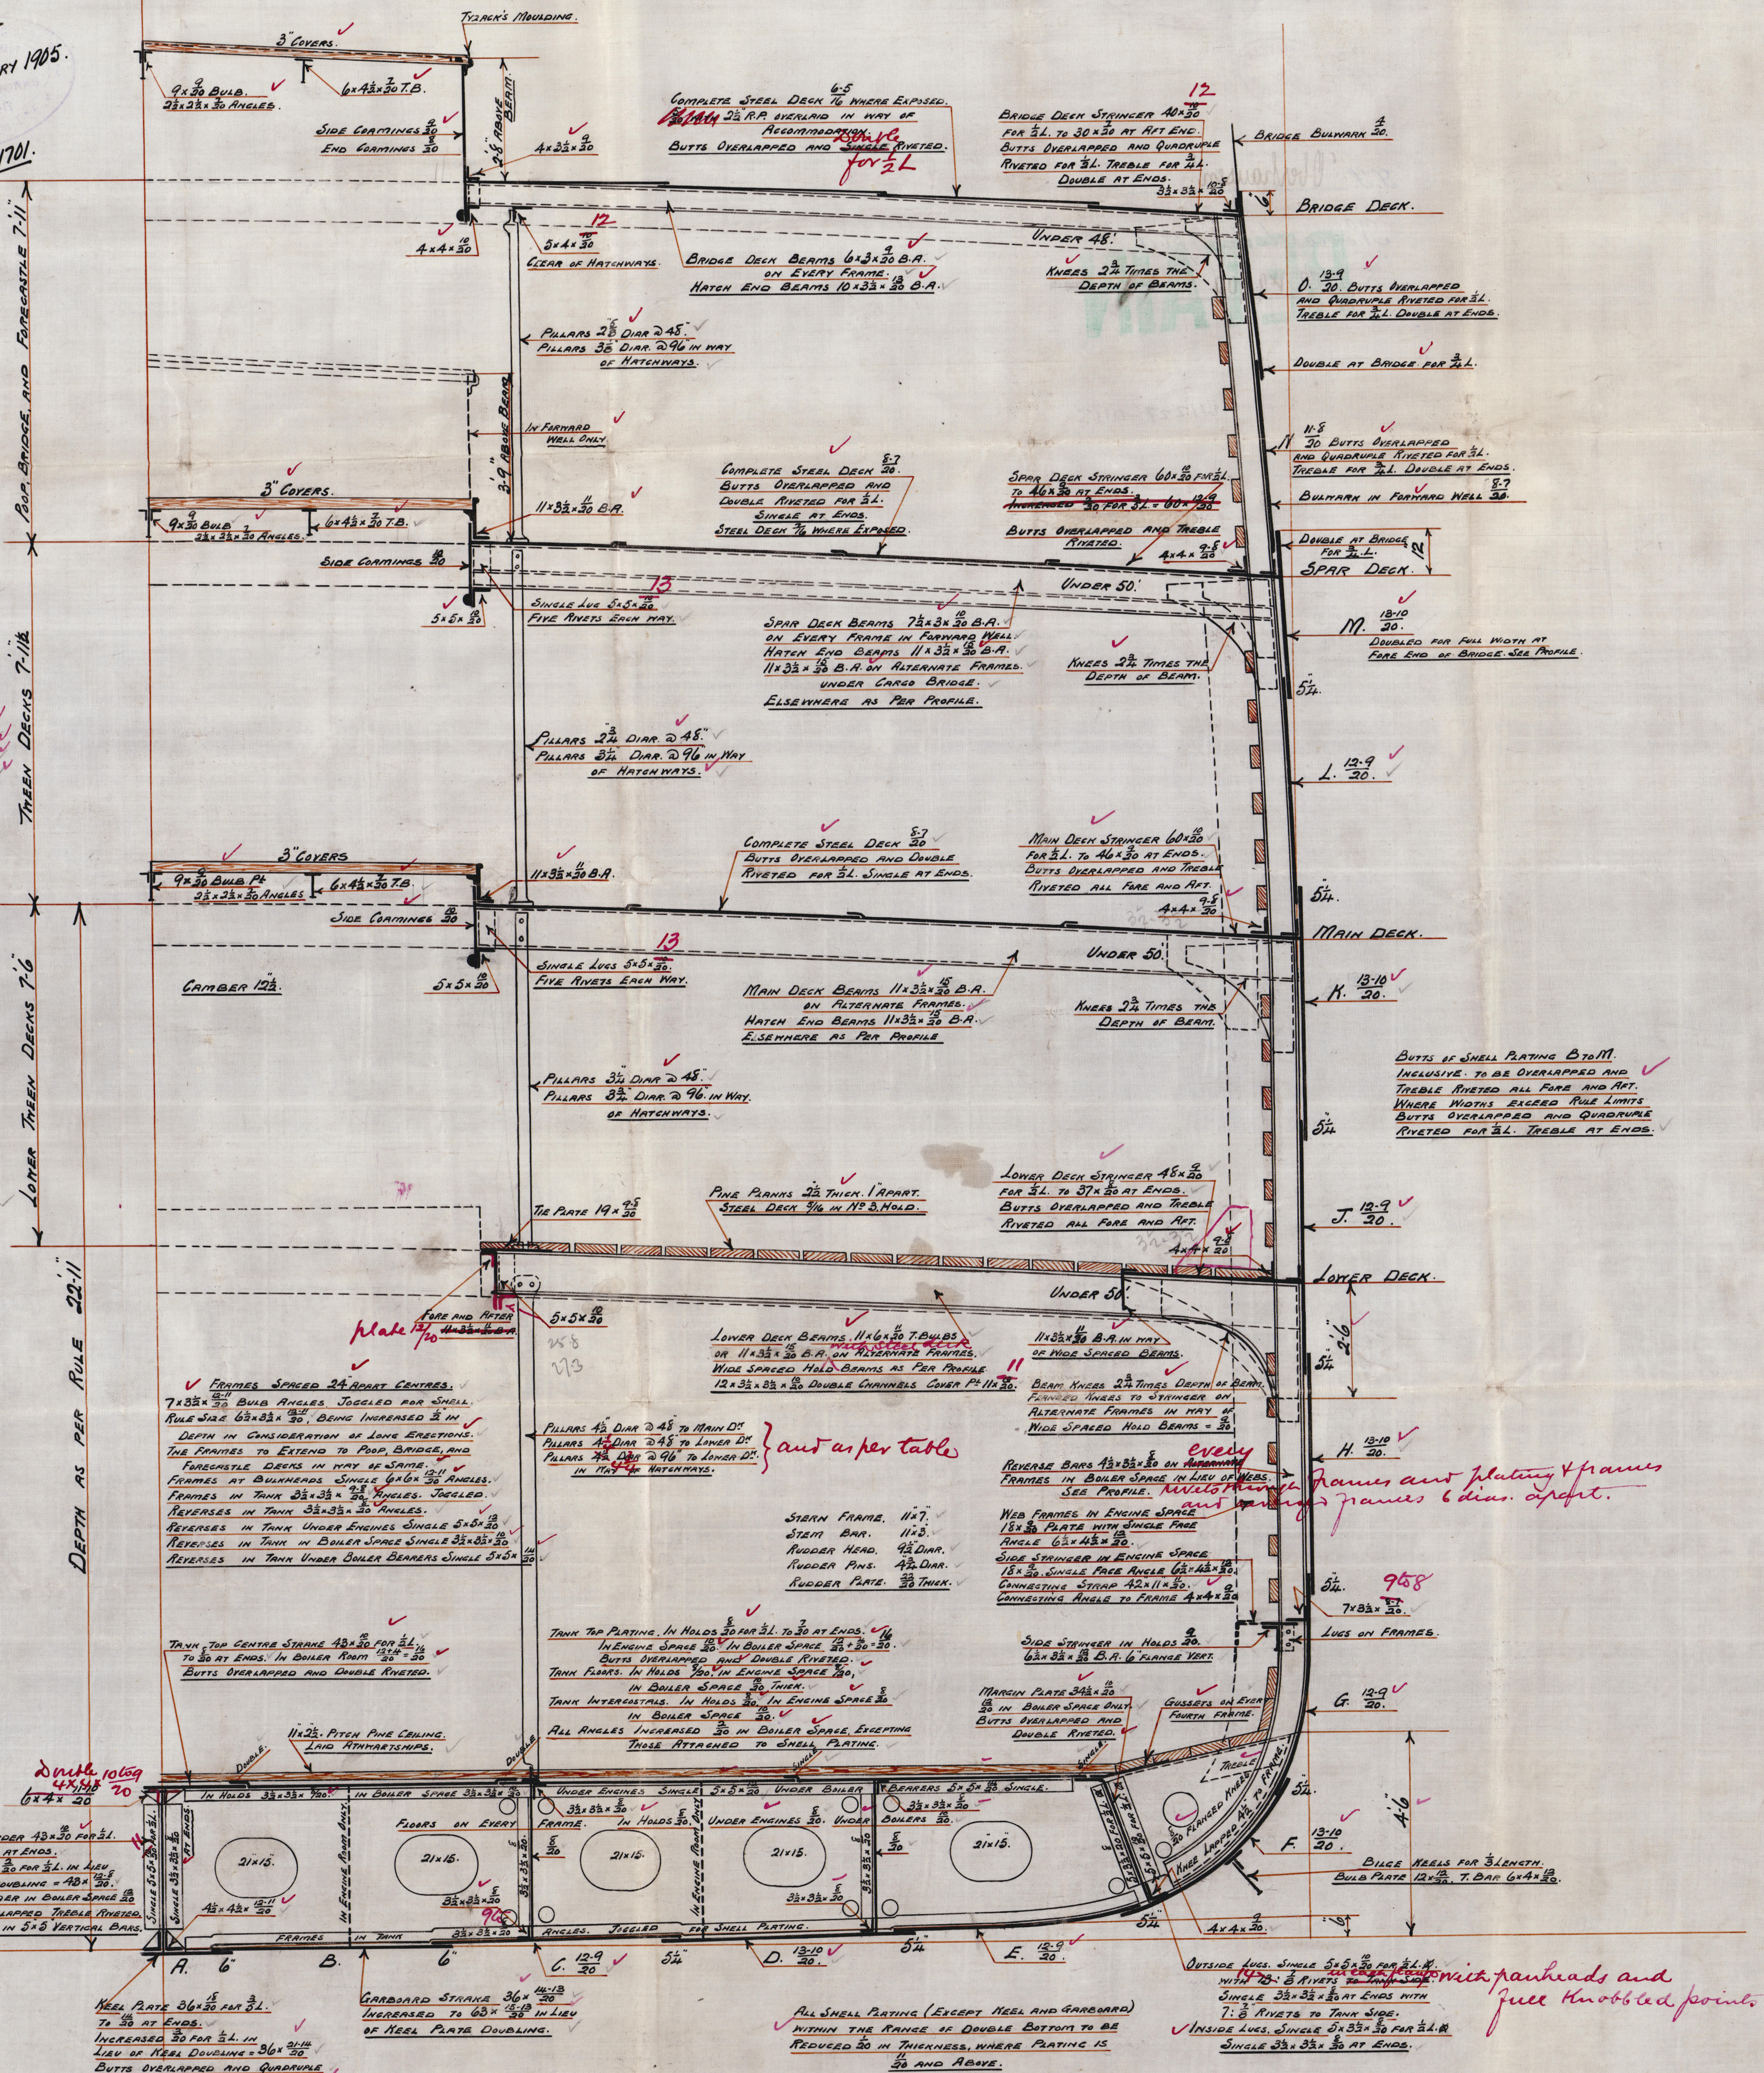

30-1-05
Lloyd's Register
W1277/13n

Swan Hunter Wigham Reel

N^o 734 7s

Midship Section

Oberhausen

J.P. 'Oberhausen'

Newcastle Report

X^{SP} 109.109.

RETAIN

W1227-0113



© 2019

Lloyd's Register
Foundation