

ss Bintang.

Opn Rpt № 2573.

S. S. Samui - Opn. Rpt № 2586

RECEIVED



20. 10. 1907

20. 10. 1907

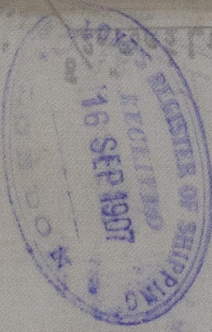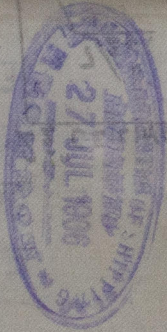


W1227-0186

INNER BOTTOM CONT


W1227-0186

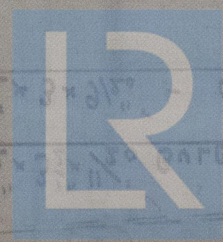

© 2019
Lloyd's Register
Foundation