

- No 113 - DUMB BARGE -

SECTION.

SCALE 3/4" = 1 FOOT.


FRAME NOS. 6 & 7, 9-15, 17-23, 25-31, 33-39 AND 41 & 42.

FR NOS. 1-5 & 43-7. SIMILAR EXCEPT FOR EXTRA

DEPTH.

68 1/8" STRAKE x 26"

RIVETING THROUGH
OF BULKHEAD STIFFERS TO BULKHEAD

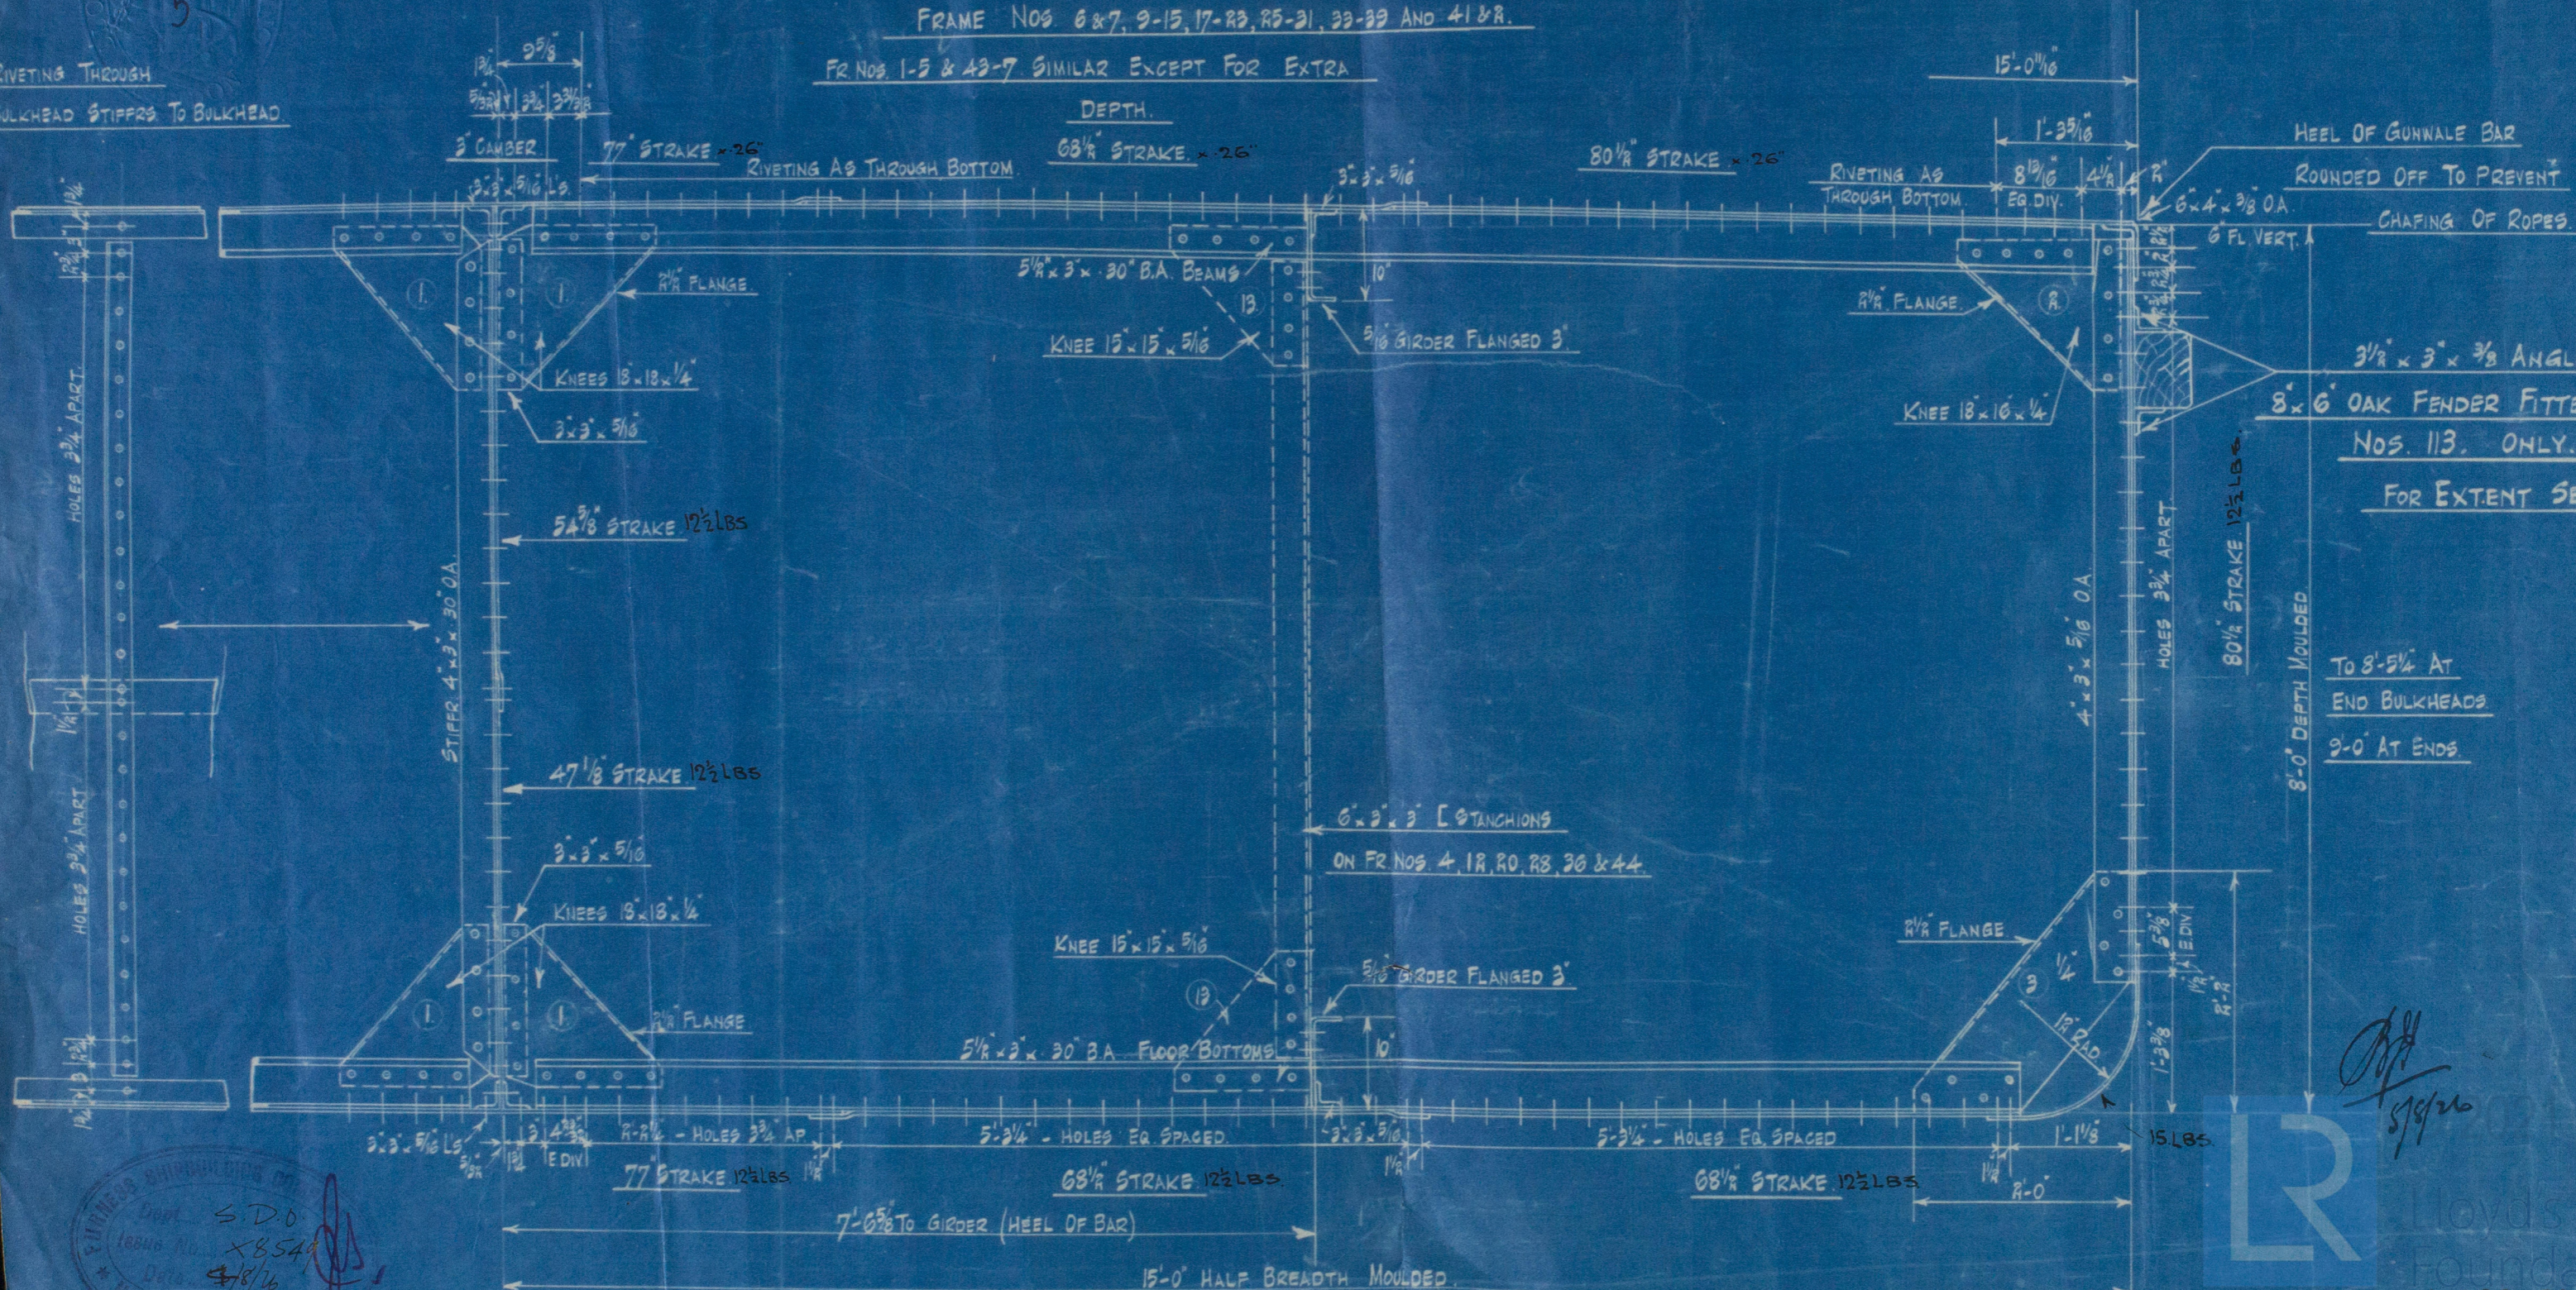

HEEL OF GUNWALE BAR
ROUNDED OFF TO PREVENT
CHAFING OF ROPES.

3 1/2 x 3 x 3/8 ANGLES FOR
8 x 6 OAK FENDER FITTED ON
NOS. 113. ONLY.

FOR EXTENT SEE SHELL PLAN

TO 8'-5 1/4" AT
END BULKHEADS
9'-0" AT ENDS.

[Signature]
5/8/26

SHIPPING
Dept. S.D.O.
Drawing No. X854
Date 4/8/16
NAVY

Lloyd's Register
Foundation
W1228-0061

113

Wass^{rs} Furness S. B. Co.
Oil Carrying Barges
Contract No 113.
Midship Section.

S.S. I. 1.
MDB. RPT. No. 12737

S.S. I. 2.
MDB. RPT. No. 12738

S.S. I. 3.
MDB. RPT. No. 12740

S.S. I. 4.
MDB. RPT. No. 12741

RETAIN



© 2021

Lloyd's Register
Foundation

W1228-0061