

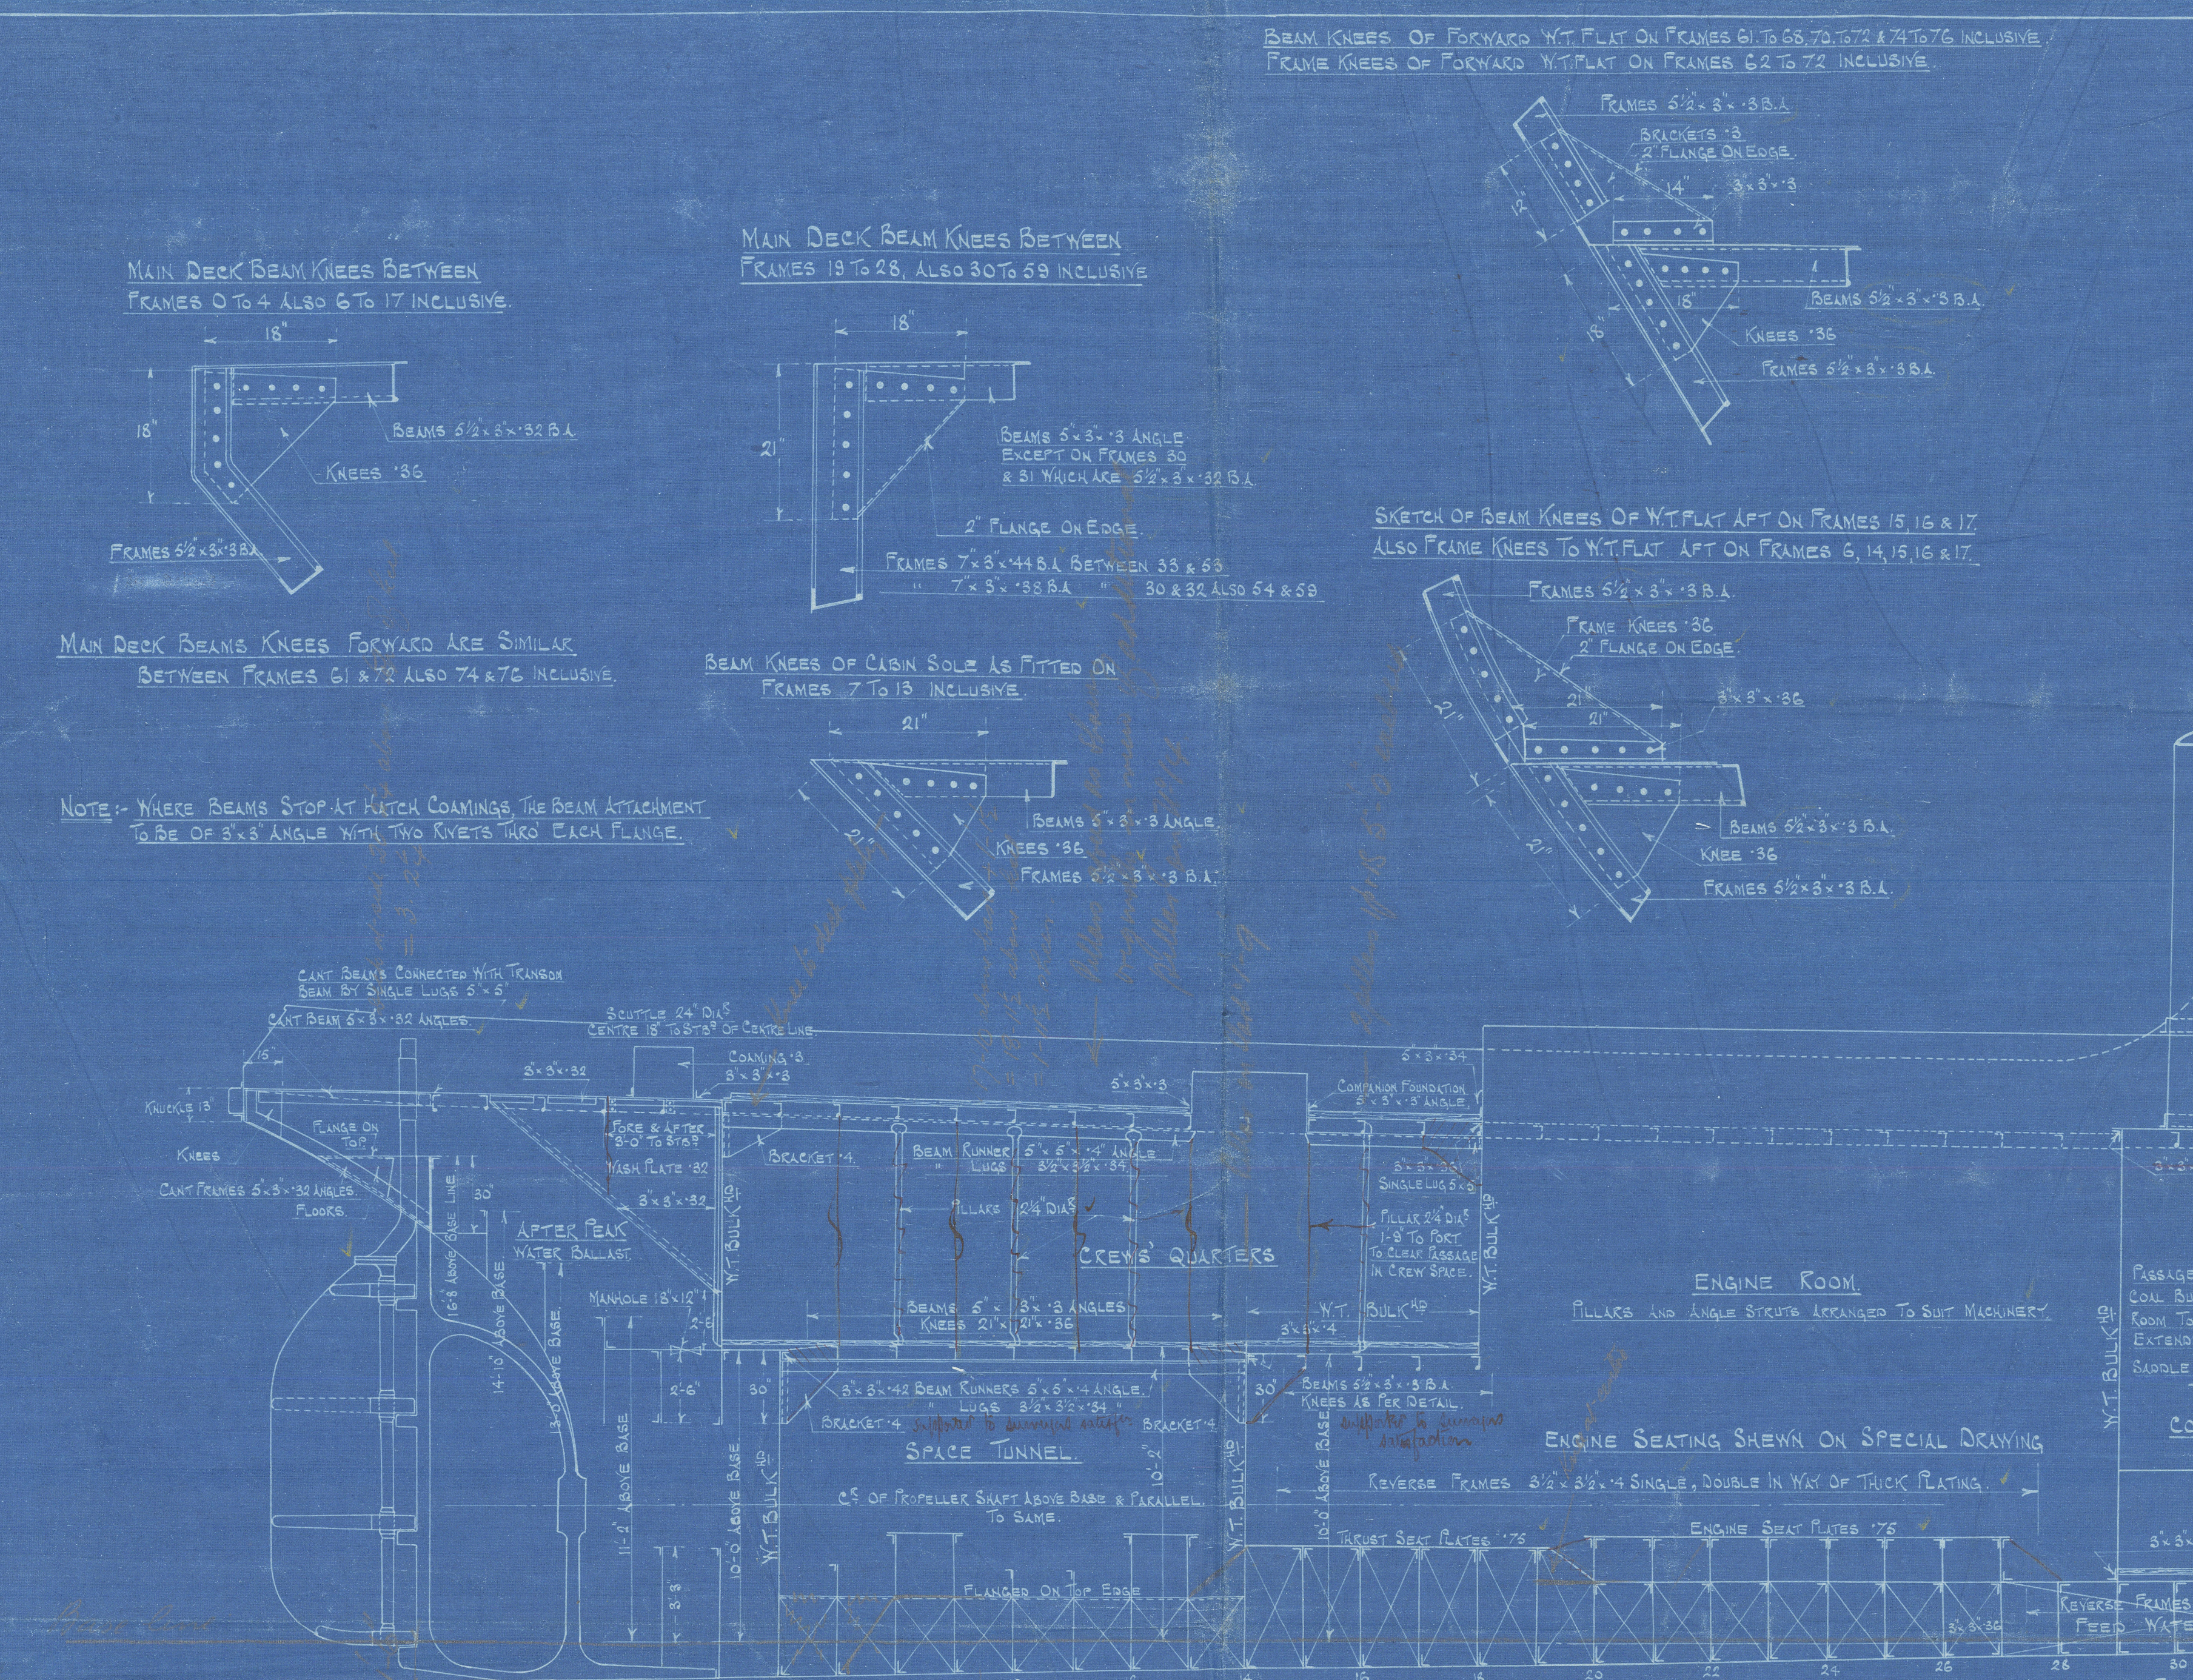


Nº 183. PROFILE & DECK PLAN. SINGLE SCREW OCEAN GOING TOWING STEAMER.

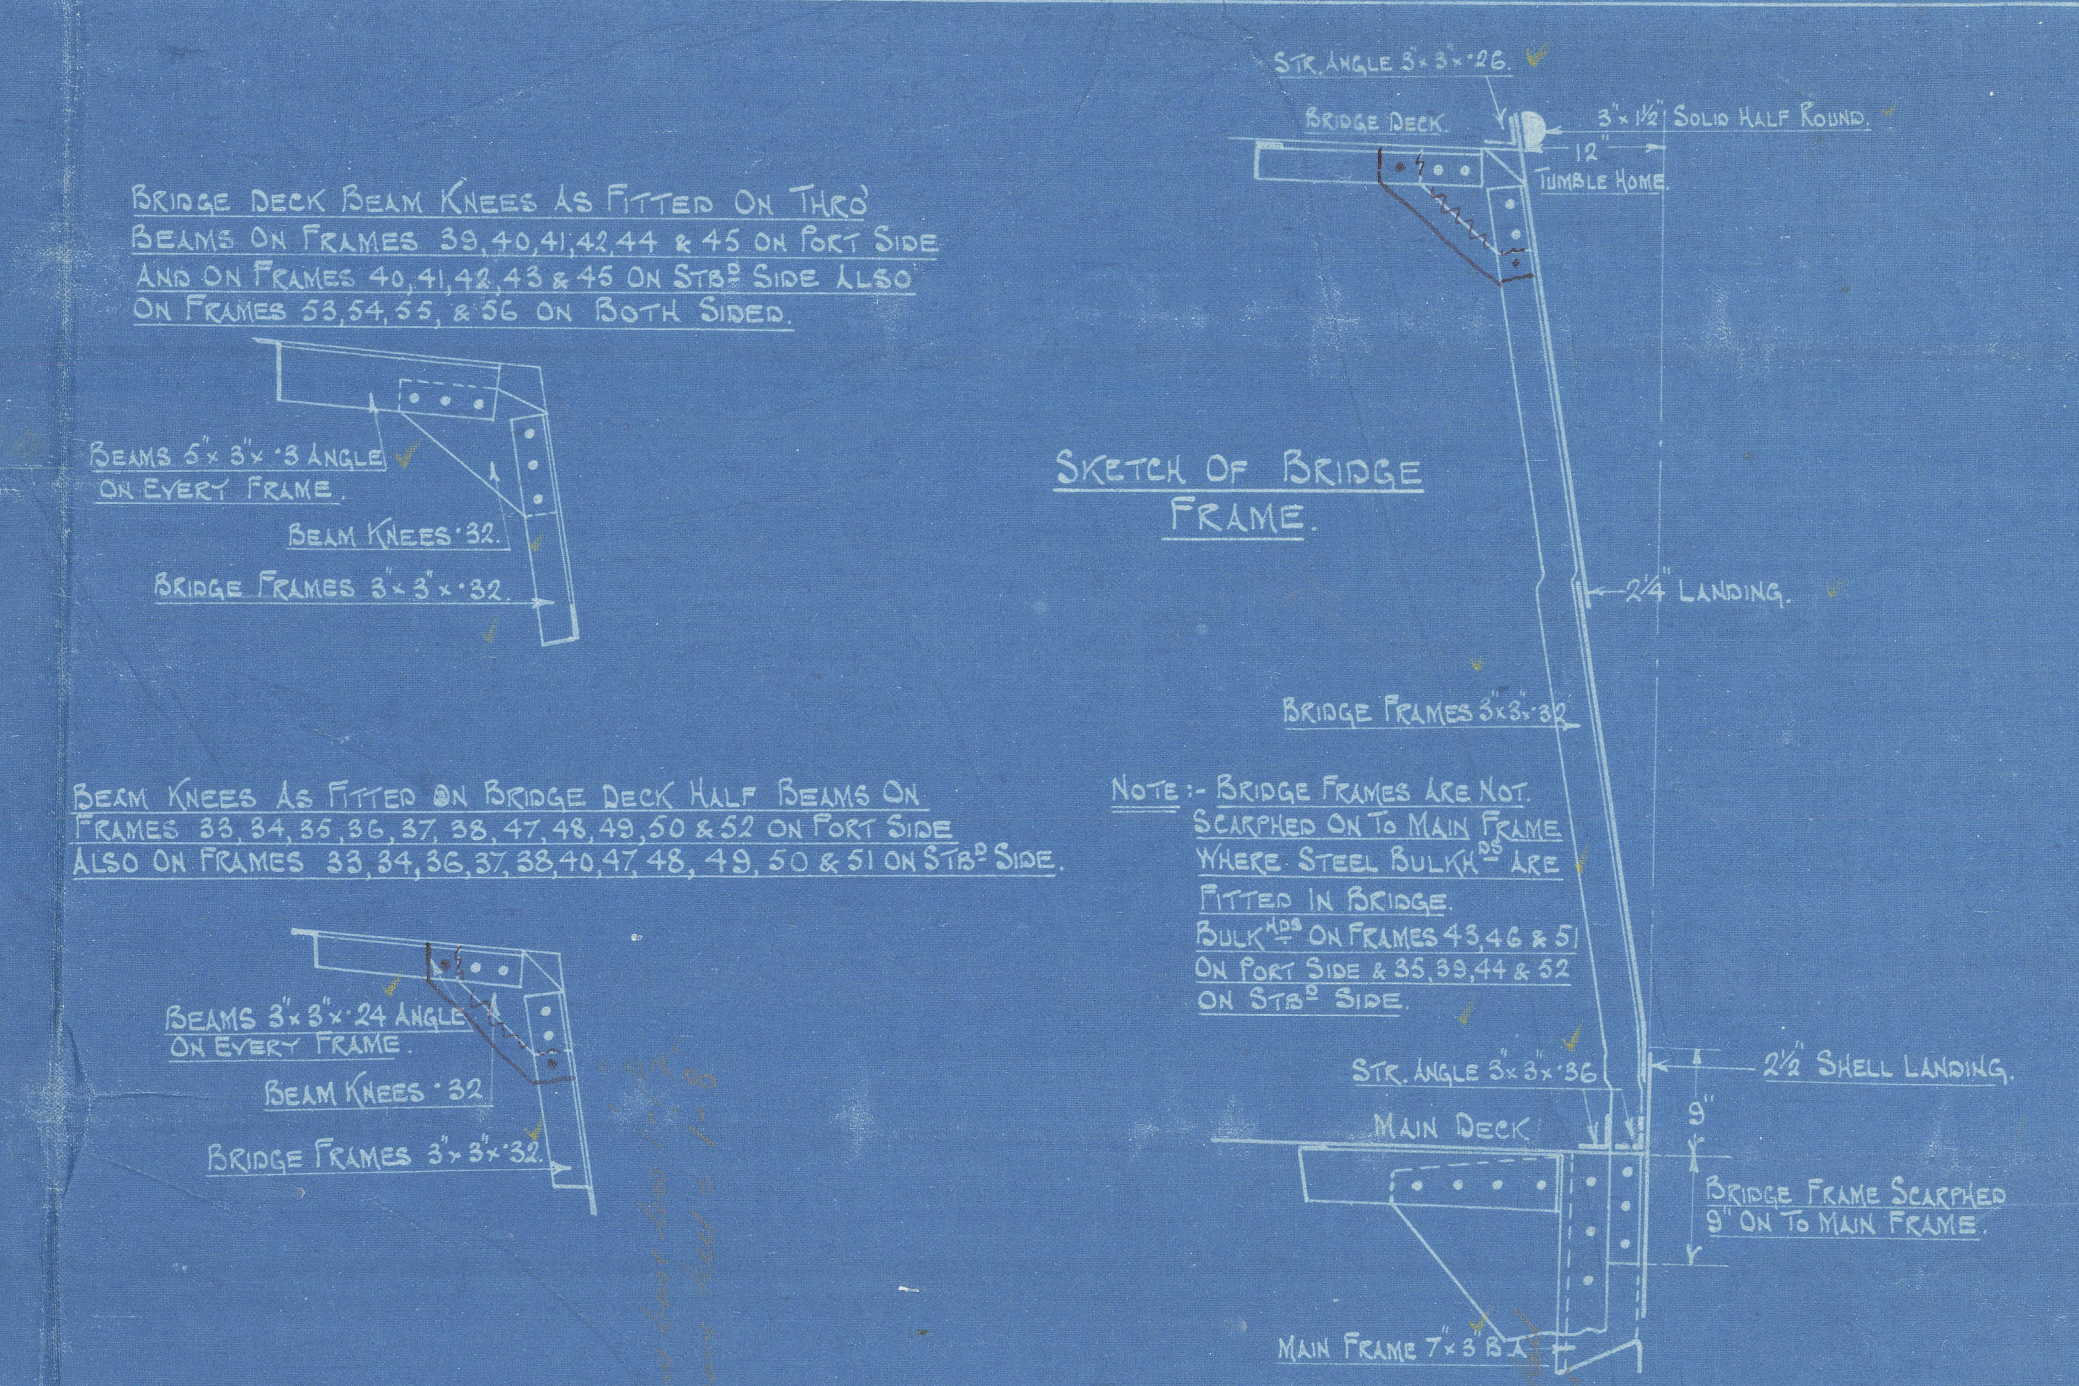


FOR THE
ADMIRALTY.
LENGTH B.P. 155'-0"
BREADTH M.D. 31'-0"
DEPTH M.D. 17'-0"
SCALE 1/4" = 1 FOOT

Class A1. For Towing Purposes.

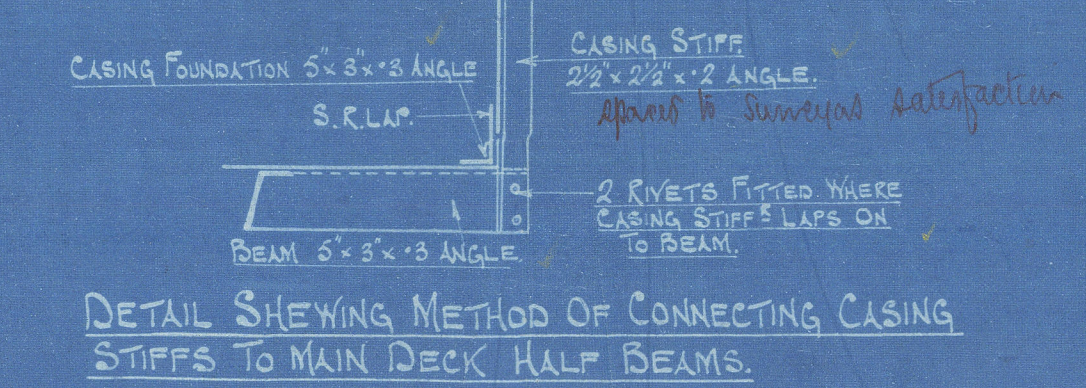



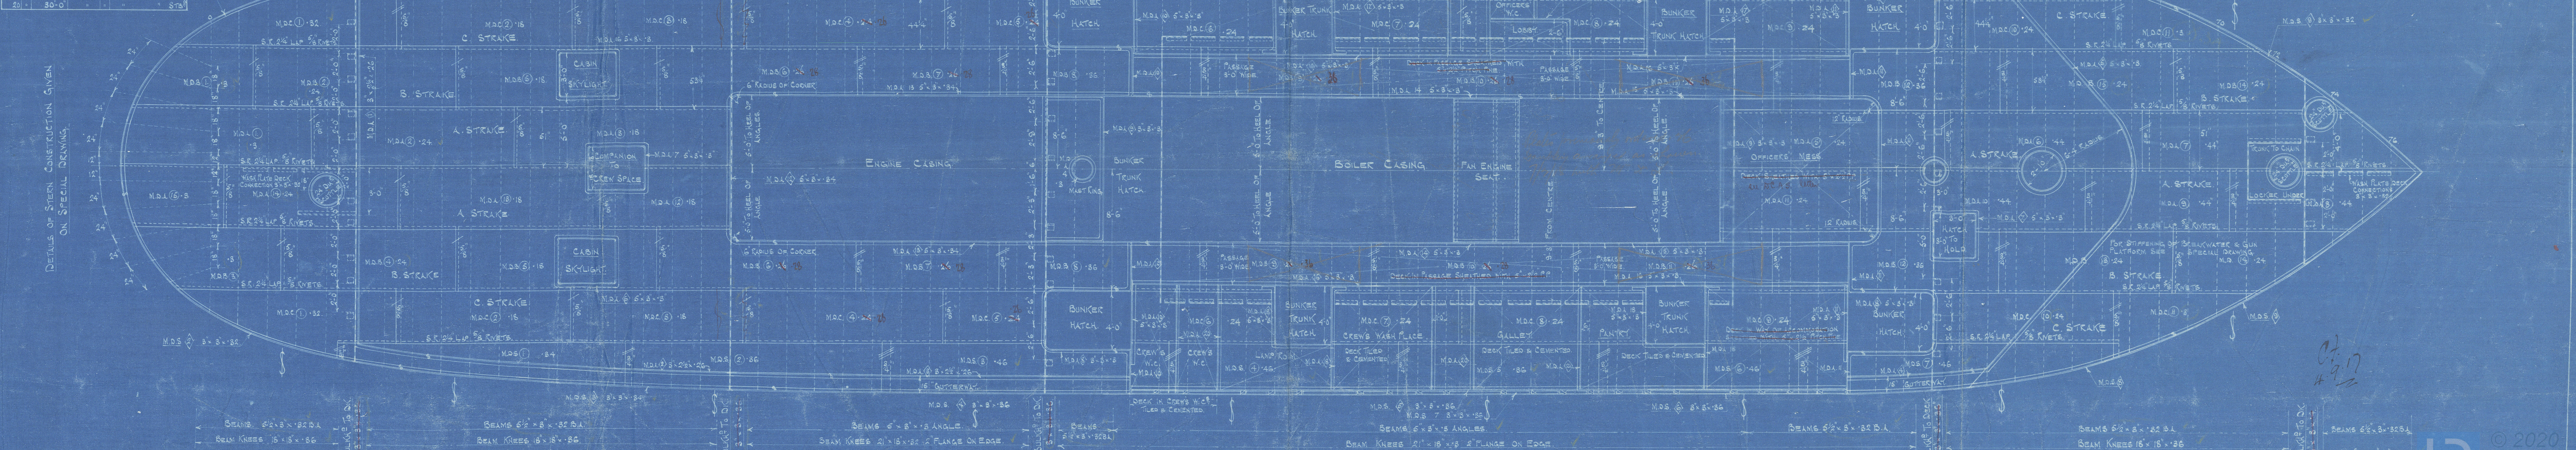



Fig. N° 183.
(Racia Cyfra).



building by

Livingstone & Cooper Ltd
Sheets & Hull.

PROFILE &

DECK. PLAN.

1/2 Sancy Rpt No 30592 (76d)
Hull Rpt No 30643.

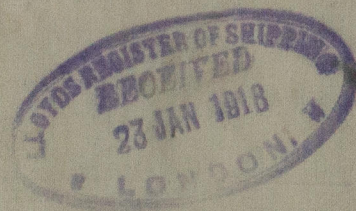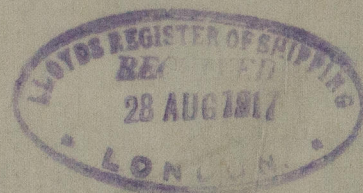

RETAIN



© 2020

Lloyd's Register
Foundation