


—N° 317—& 343 —CONSTRUCTION PLAN—

SCALE 3/16 INCH TO ONE FOOT

PROFILE




Attention in No. 2 hatchway & position of
Rigging Backhead shown on attached
drawing. Photo-print. *ALP*

 


Kawasaki No 314 S. S.
+343

Profile

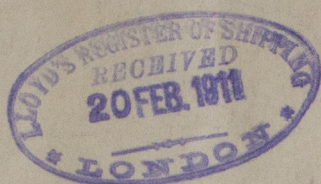

Kawasaki 314 "Yaiun Maru"
Kobe Report No 960

Kawasaki 343 "Zaiyoi Maru"
Kobe Report 1146

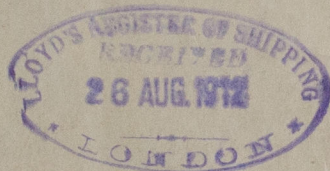

RETAIN



© 2021

Lloyd's Register
Foundation

W1232 - 0021