

Do. of space or spaces
between Tonnage Dk.
and Upper Dk.

Length from fore part of stem to after part of stern
post on summer L.W.L. See Sec. 3 (1a)

Breadth (greatest moulded)

L 264

B 34

Launched 14 August

Builders Messrs. Wils

Rpt. 6.

For the information of Surveyors and the Committee only.

Received at

Office

19

Lloyd's Register of Shipping.

(Report on Vessel No. Port

No.

SHIP FORGINGS OR CASTINGS.

I have to report that the undermentioned ~~Iron or Steel Forgings or Castings~~, manufactured by *N. V. Wollons IJzerfab. & Scheepswerf* of *Rotterdam* for the Vessel No. *312*, being built by *N. V. Wollons IJzerfab. & Scheepswerf* of *Schiedam* have been inspected by me as set forth below and found to be, so far as can be seen, *sound and free from defects*

STEM FRAME

Mark on Forgings or Castings.

RUDDER FRAME

MARK ON FORGING

RUDDER

GUARANT
MARK ON FORGING

Lloyd's

No. 193

5-5-26

LLOYD'S

N° 195

M.J. 4-8-26

LLOYD'S

N° 210

M.J. 11-8-26


Rotterdam

H. P. Jonker

RUDDER

| | STERN FRAME. | RUDDER FRAME. | STEM. |
|---|--|---|----------------------------|
| Material* | Siemens Hartum steel | Siemens Hartum steel | Siemens Hartum steel |
| How made | Forged | Forged | Forged |
| annealed | yes | yes | yes |
| Dimensions | as per plan | as per plan | as 1 |
| Progress on Inspection | Forged & flamed 5/5-1926 | Forged & flamed 4/8-26 | Forged & flamed 11/8-26 |
| Date when Inspected | | | |
| CASTINGS. | | | |
| Tests on Standard Test Pieces. | | | |
| Tensile Test— | | | |
| Tons per square inch | 23 ³ / ₁₀ to 25 tons | 29 ¹ / ₂ to 30 ¹ / ₂ tons | 31 Tons |
| Extension per cent. | 38 to 39 % | 34 to 32 % | 32 % |
| Old Bending Test— | | | |
| Angle before fracture | 100° good | 100° good | 100° good |
| Drop Test— | | | |
| Height from ground | ✓ | ✓ | ✓ |
| Hammering Test— | | | |
| If made according to Rules and found satisfactory | ✓ | ✓ | ✓ |

SKETCHES OF FRAMES SHOWING POSITION AND DESCRIPTION OF WELDS OF FORGINGS.

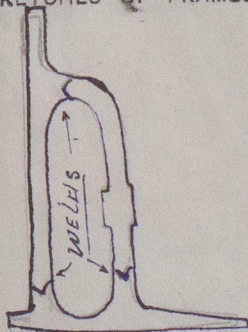

Fee (if any chargeable) £

To be paid at

Rotterdam

* If of Iron, state whether scrap or puddled Iron. If of Steel, state whether made on the Open Hearth process.


2nd 123. F.

middle line.....

Forecastle Deck, angle, E

Referred to Mr. Hill.

76.

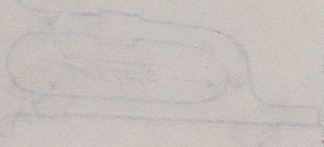

© 2020

Lloyd's Register
Foundation

