

# - LANGSPLAN - SS. N° 311-312 -

AFM. 264'-0" x 37'-0" x 18'-6"

KLASSE ENG. LLOYD 100-A-1

SCHAAL 1/8" : 1'-0"


LLOYD'S NUMMERS

$$\frac{1}{L} \text{ LANGSNUMMER } L \times D = 264 \times 18.5 = 4884$$


$$\frac{2}{L} \text{ " " " " } L (B+D) = 264 \times 55.5 = 14652$$

$$\frac{L}{D} = \frac{264}{18.5} = 14.27$$



## KAMPANJEDEK

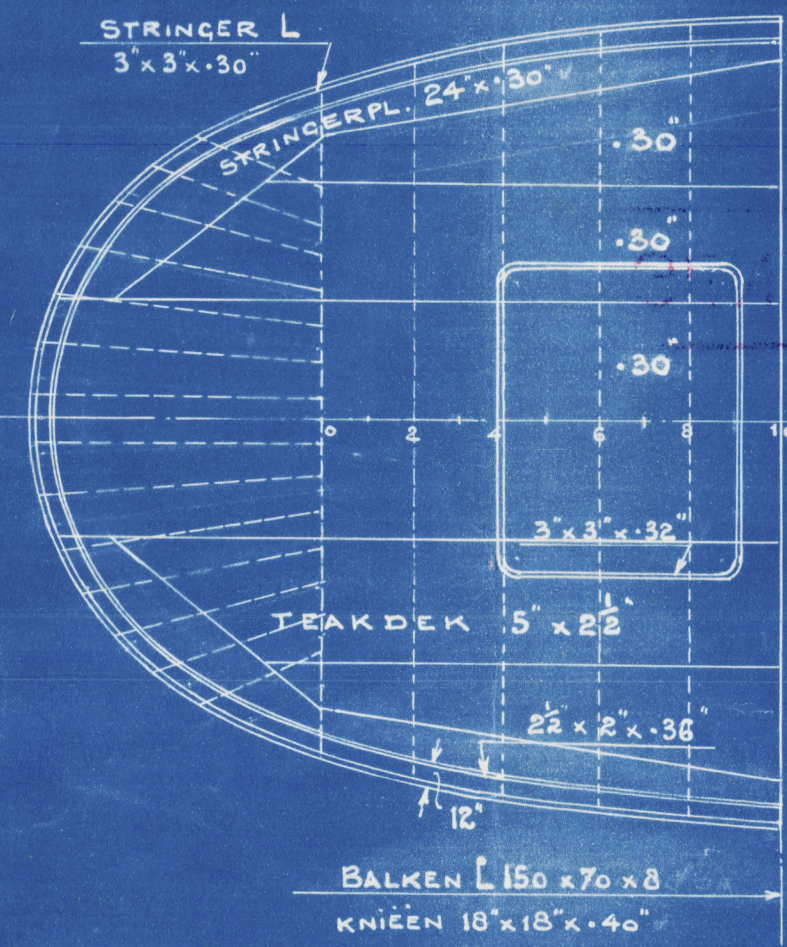


## BRUGDEK

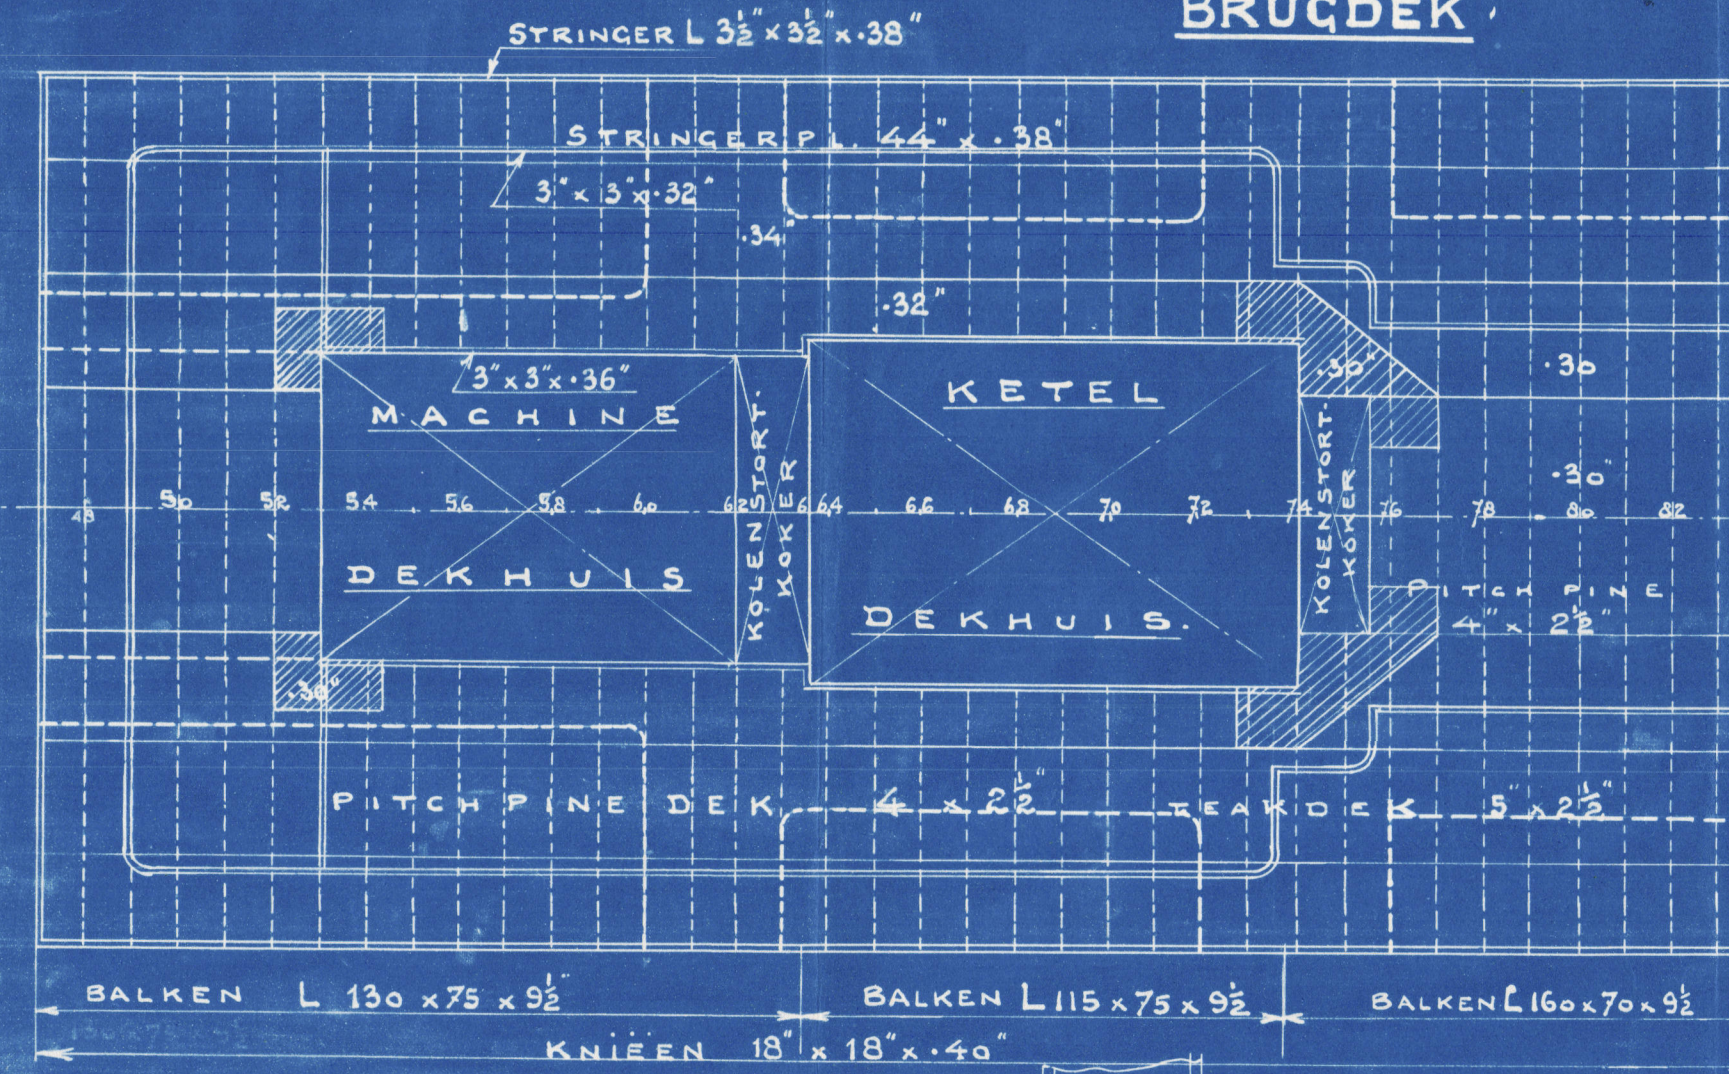

## BAKDEK

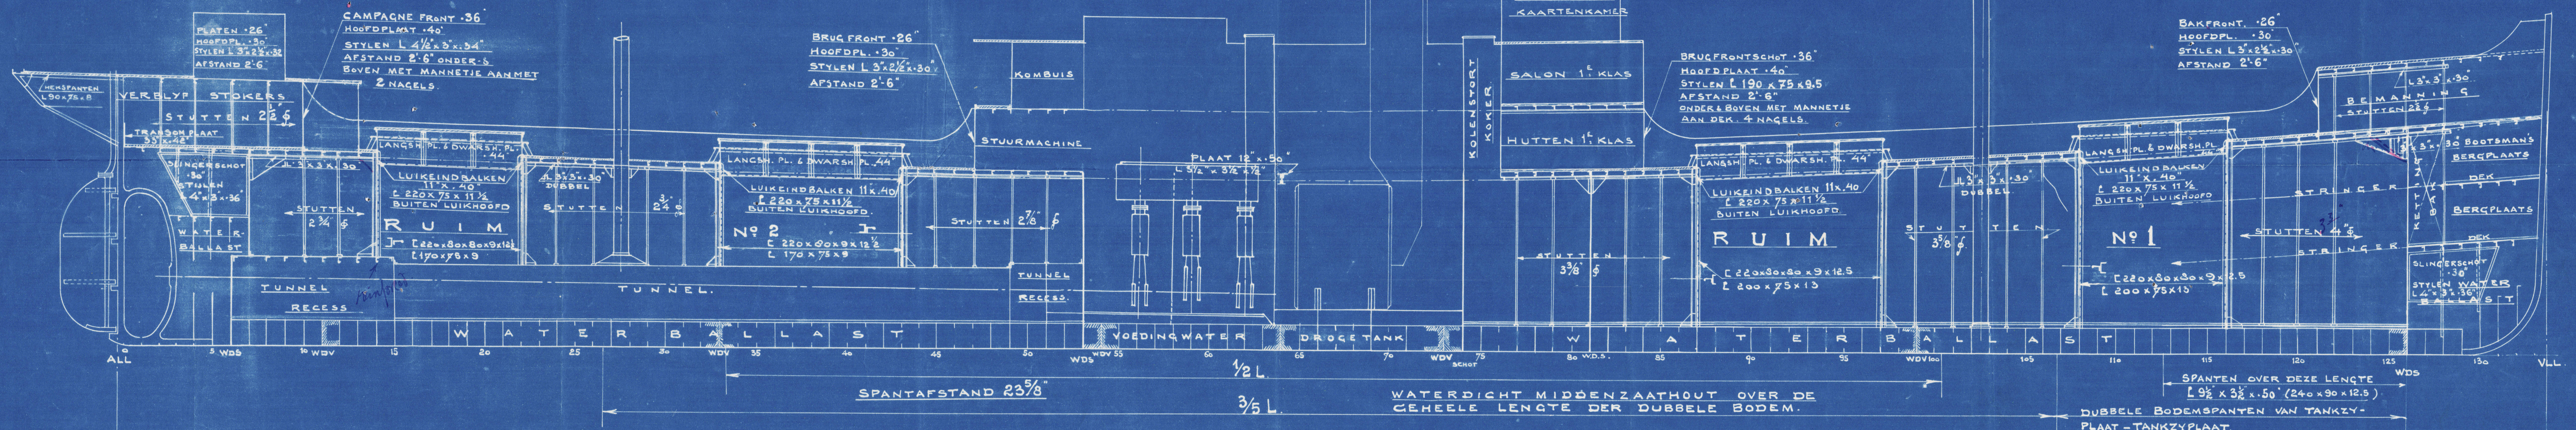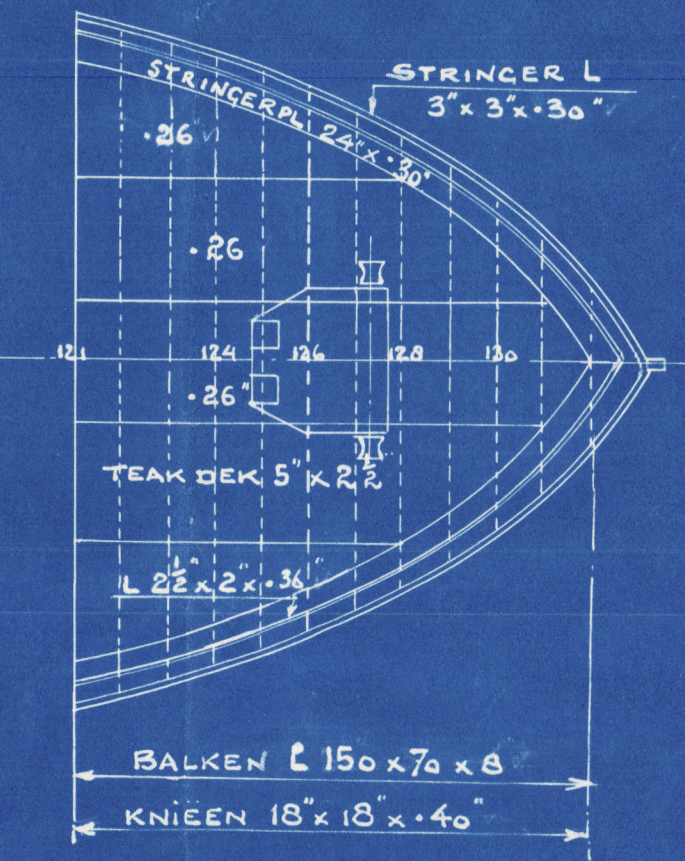

## BOVENDEK

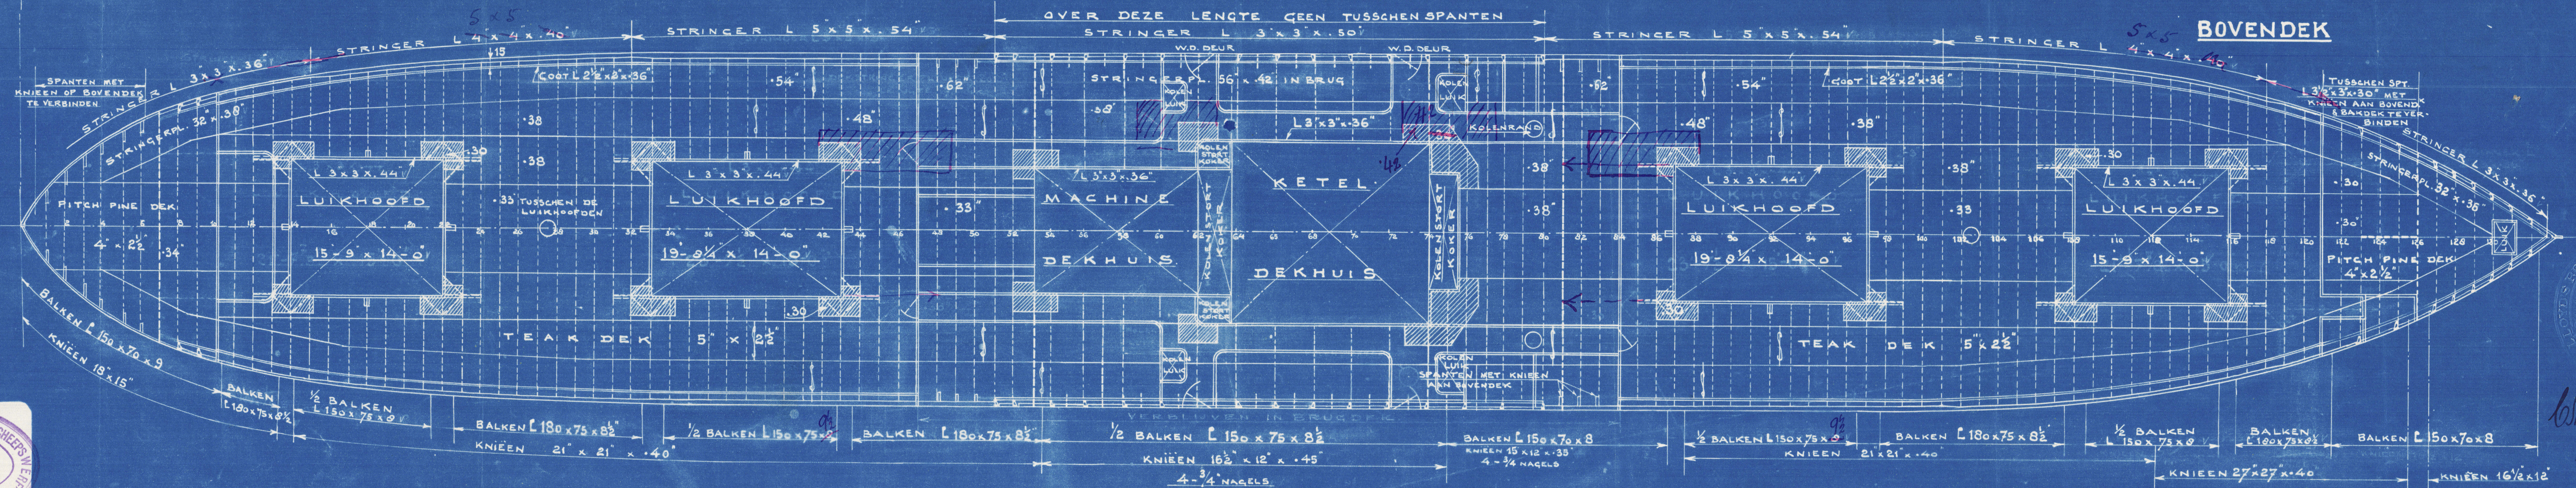

W1233-0045

Messrs Wiltons S & C  
Yard No 311/2

Amended Profile + Deck  
Plans (showing Hatchways of  
reduced dimensions)

Now

SIBIGO.

<sup>2</sup>/<sub>5</sub> Kian Guan

---

GEN. BOX NO 790

---

D. 92. B.