


- GROOT SPANT - - S.S. N^o 311 - 312. -

AFM. 264' 0" x 37'-0" x 18'-6"

KLASSE ENG. LLOYD'S 100.A.1

MAT. STAAL.

SCHAAL $\frac{1}{2}'' = 1'-0''$

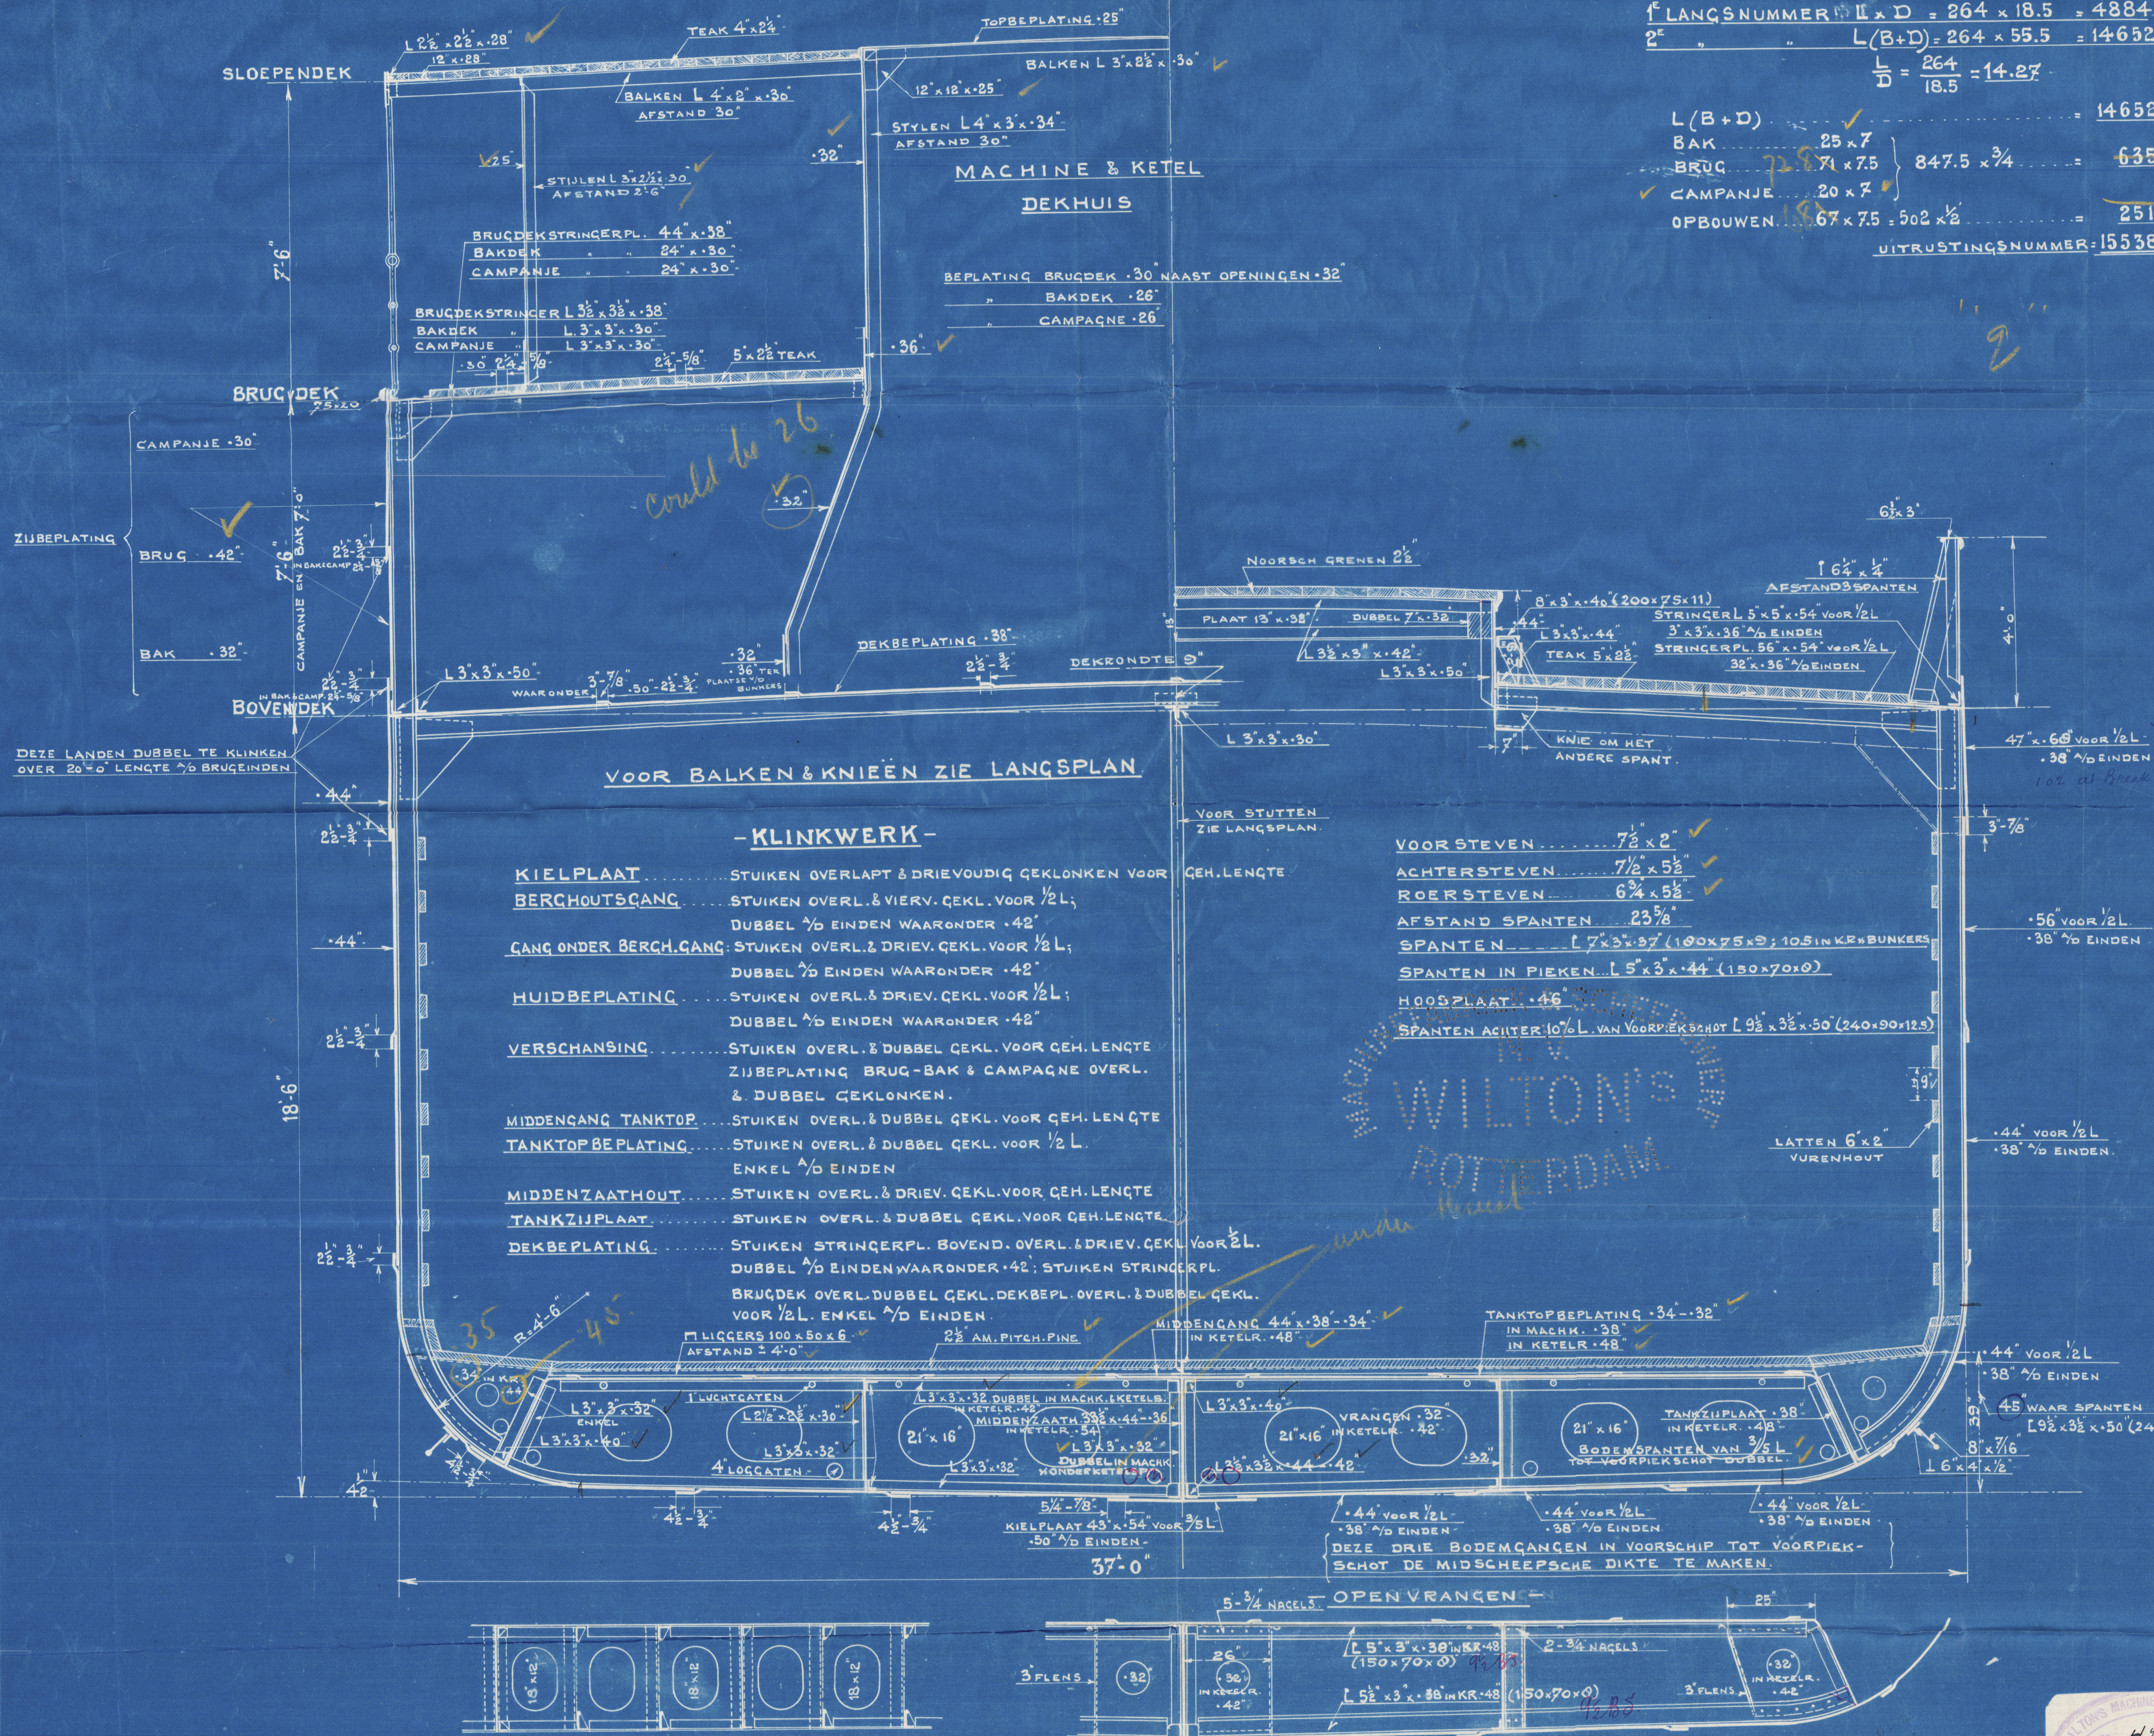

LLOYD'S NUMMERS.

$$1^E \text{ LANGSNUMBER} \times D = 264 \times 18.5 = 4884$$
$$2^E \quad " \quad " \quad L/(B+D) = 264 \times 55.5 = 14652$$
$$\frac{L}{D} = \frac{264}{18.5} = \underline{14.27}$$
$$L/(B+D) = 14652$$

BAK 25 x 7

$$\text{BRUC } 728.71 \times 7.5 \quad \left. \begin{array}{l} 847.5 \times \frac{3}{4} \\ \dots \end{array} \right\} = \underline{635}$$

CAMPANJE... 20 x 7

$$7.5 = 502 \times \frac{1}{2} \dots\dots\dots = \underline{251}$$

$\frac{1}{2}$ within Bridge
= $\frac{1}{3}$ B of Vessel

(12.5) See Parking Arrangement Plan



8 JAN: 1926

W11233 - 0046


Lloyd's Register
Foundation

8

Messrs Wilton's S^r & Co
Yard No 3 311/2
Midship Section

S^r Kian Gwan

~~GEN. BOX NO 490~~

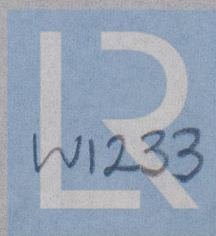

W1233

-0046

© 2020

Lloyd's Register
Foundation