



DECK PLATING PLAN

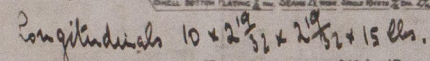

PORT SIDE




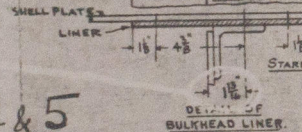


N^{os} 4 & 5


OIL BARGES.

LENGTH OVERALL	166'-3"
" OVER END PLATING	165'-3"
BREADTH OVERALL	38'-8"
" MOULDED	37'-8"
DEPTH AT CENTRE	8'-10"
" AT SIDE	8'-6"
DRAFT LOADED (at 125° True)	7'-7"
RISE OF FLOOR 2 ND BEAM CROP 2'	
LENGTH OF EACH OIL COMPART	60'-1"
TRANSVERSES SPACED APT.	12'-0"


SCALE $\frac{1}{8}$ " = ONE FOOT.

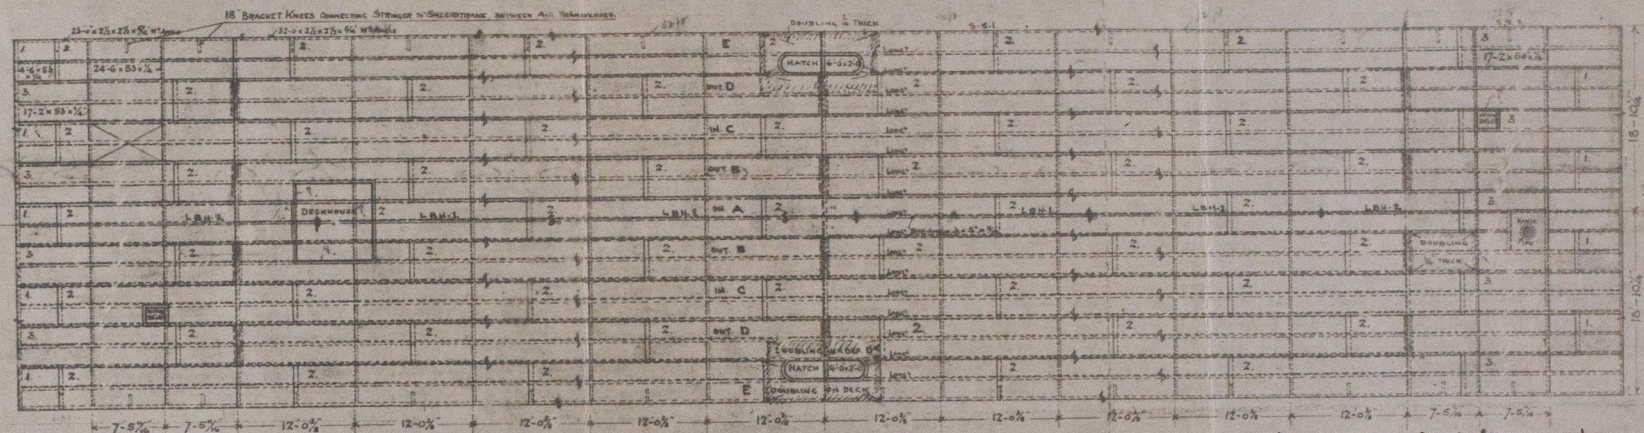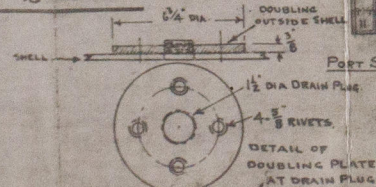

LONGITUDINAL SECTION THROUGH CENTRE SHOWING LONGITUDINAL BULKHEAD

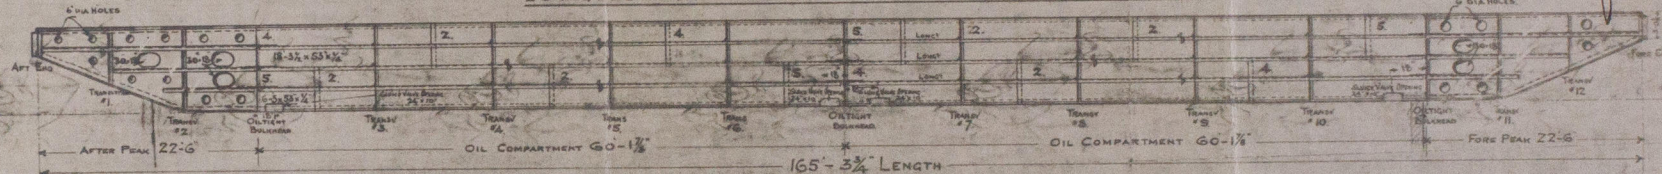

EXPANSION OF SHELL PLATING

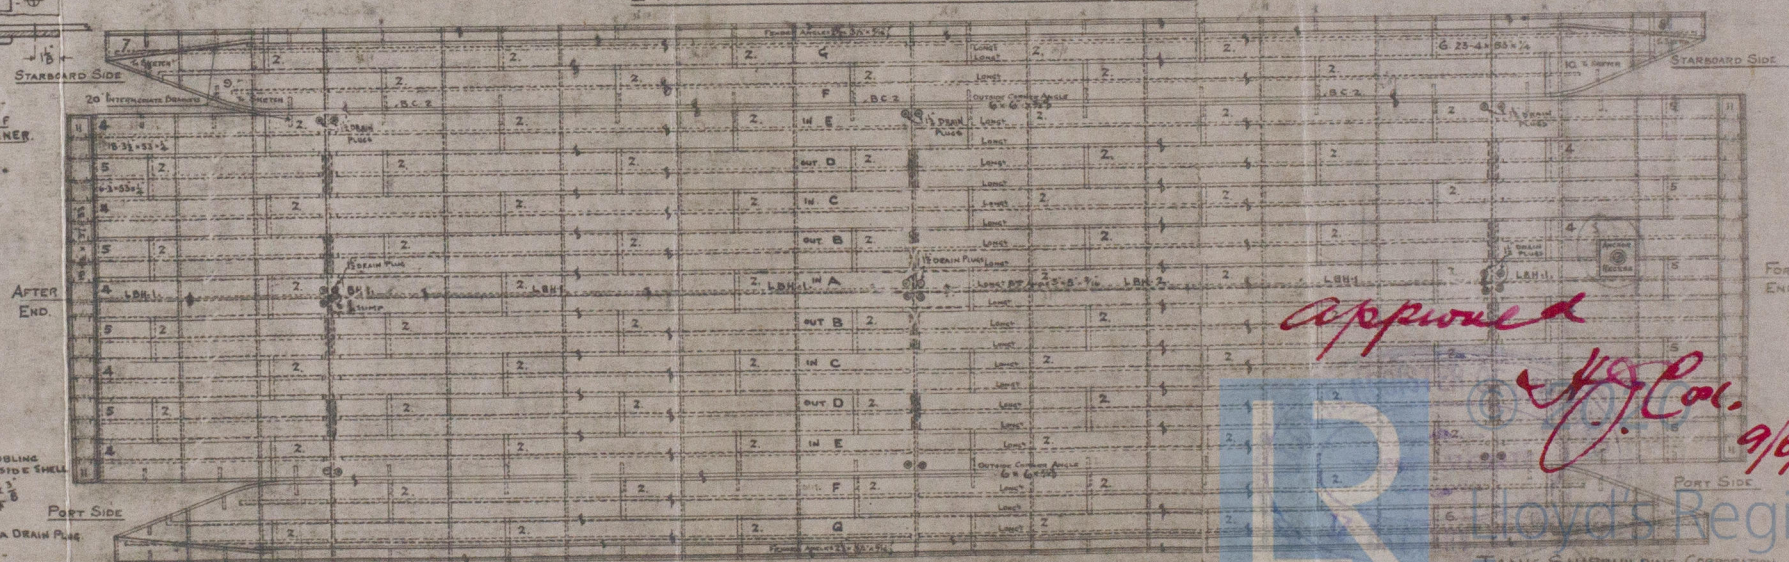

Approved
W. J. Coe.


 Lloyd's Register
 TANK SHIPBUILDING CORPORATION
 NEWBURGH, N.Y.
 10964

W1233 - 0156

Tank Shipbuilding Corporation

W4

Profile Shell and Decks

"NAVEGADORA N: 75"

New York Rpt W. 139/5

Amended Copy approval plan

139/5

DETAIN

W1233-0156



© 2020

Lloyd's Register
Foundation