

SINGLE SCREW TUG.

MIDSHIP SECTION.

DIMENSIONS

LENGTH O A	54'-0"
B P	50'-0"
BREADTH MLD	13'-6"
DEPTH MLD	6'-0"
DRAFT EXTREME	5'-6"
SPEED RUNNING FREE	8½ KNOTS



SCALE 1" = 1 FOOT.

CLASS **A**-LLOYDS

FOR TOWING ~~SERVICES~~ AT BUENOS AIRES

EQUIPMENT

1 ANCHOR	100 LBS	EX. STOCK.
30 FATHOMS	3/8	SHORT LINK CHAIN
30	5	TOWLINE
30	2 1/2	F.S.W.R. HAWSER

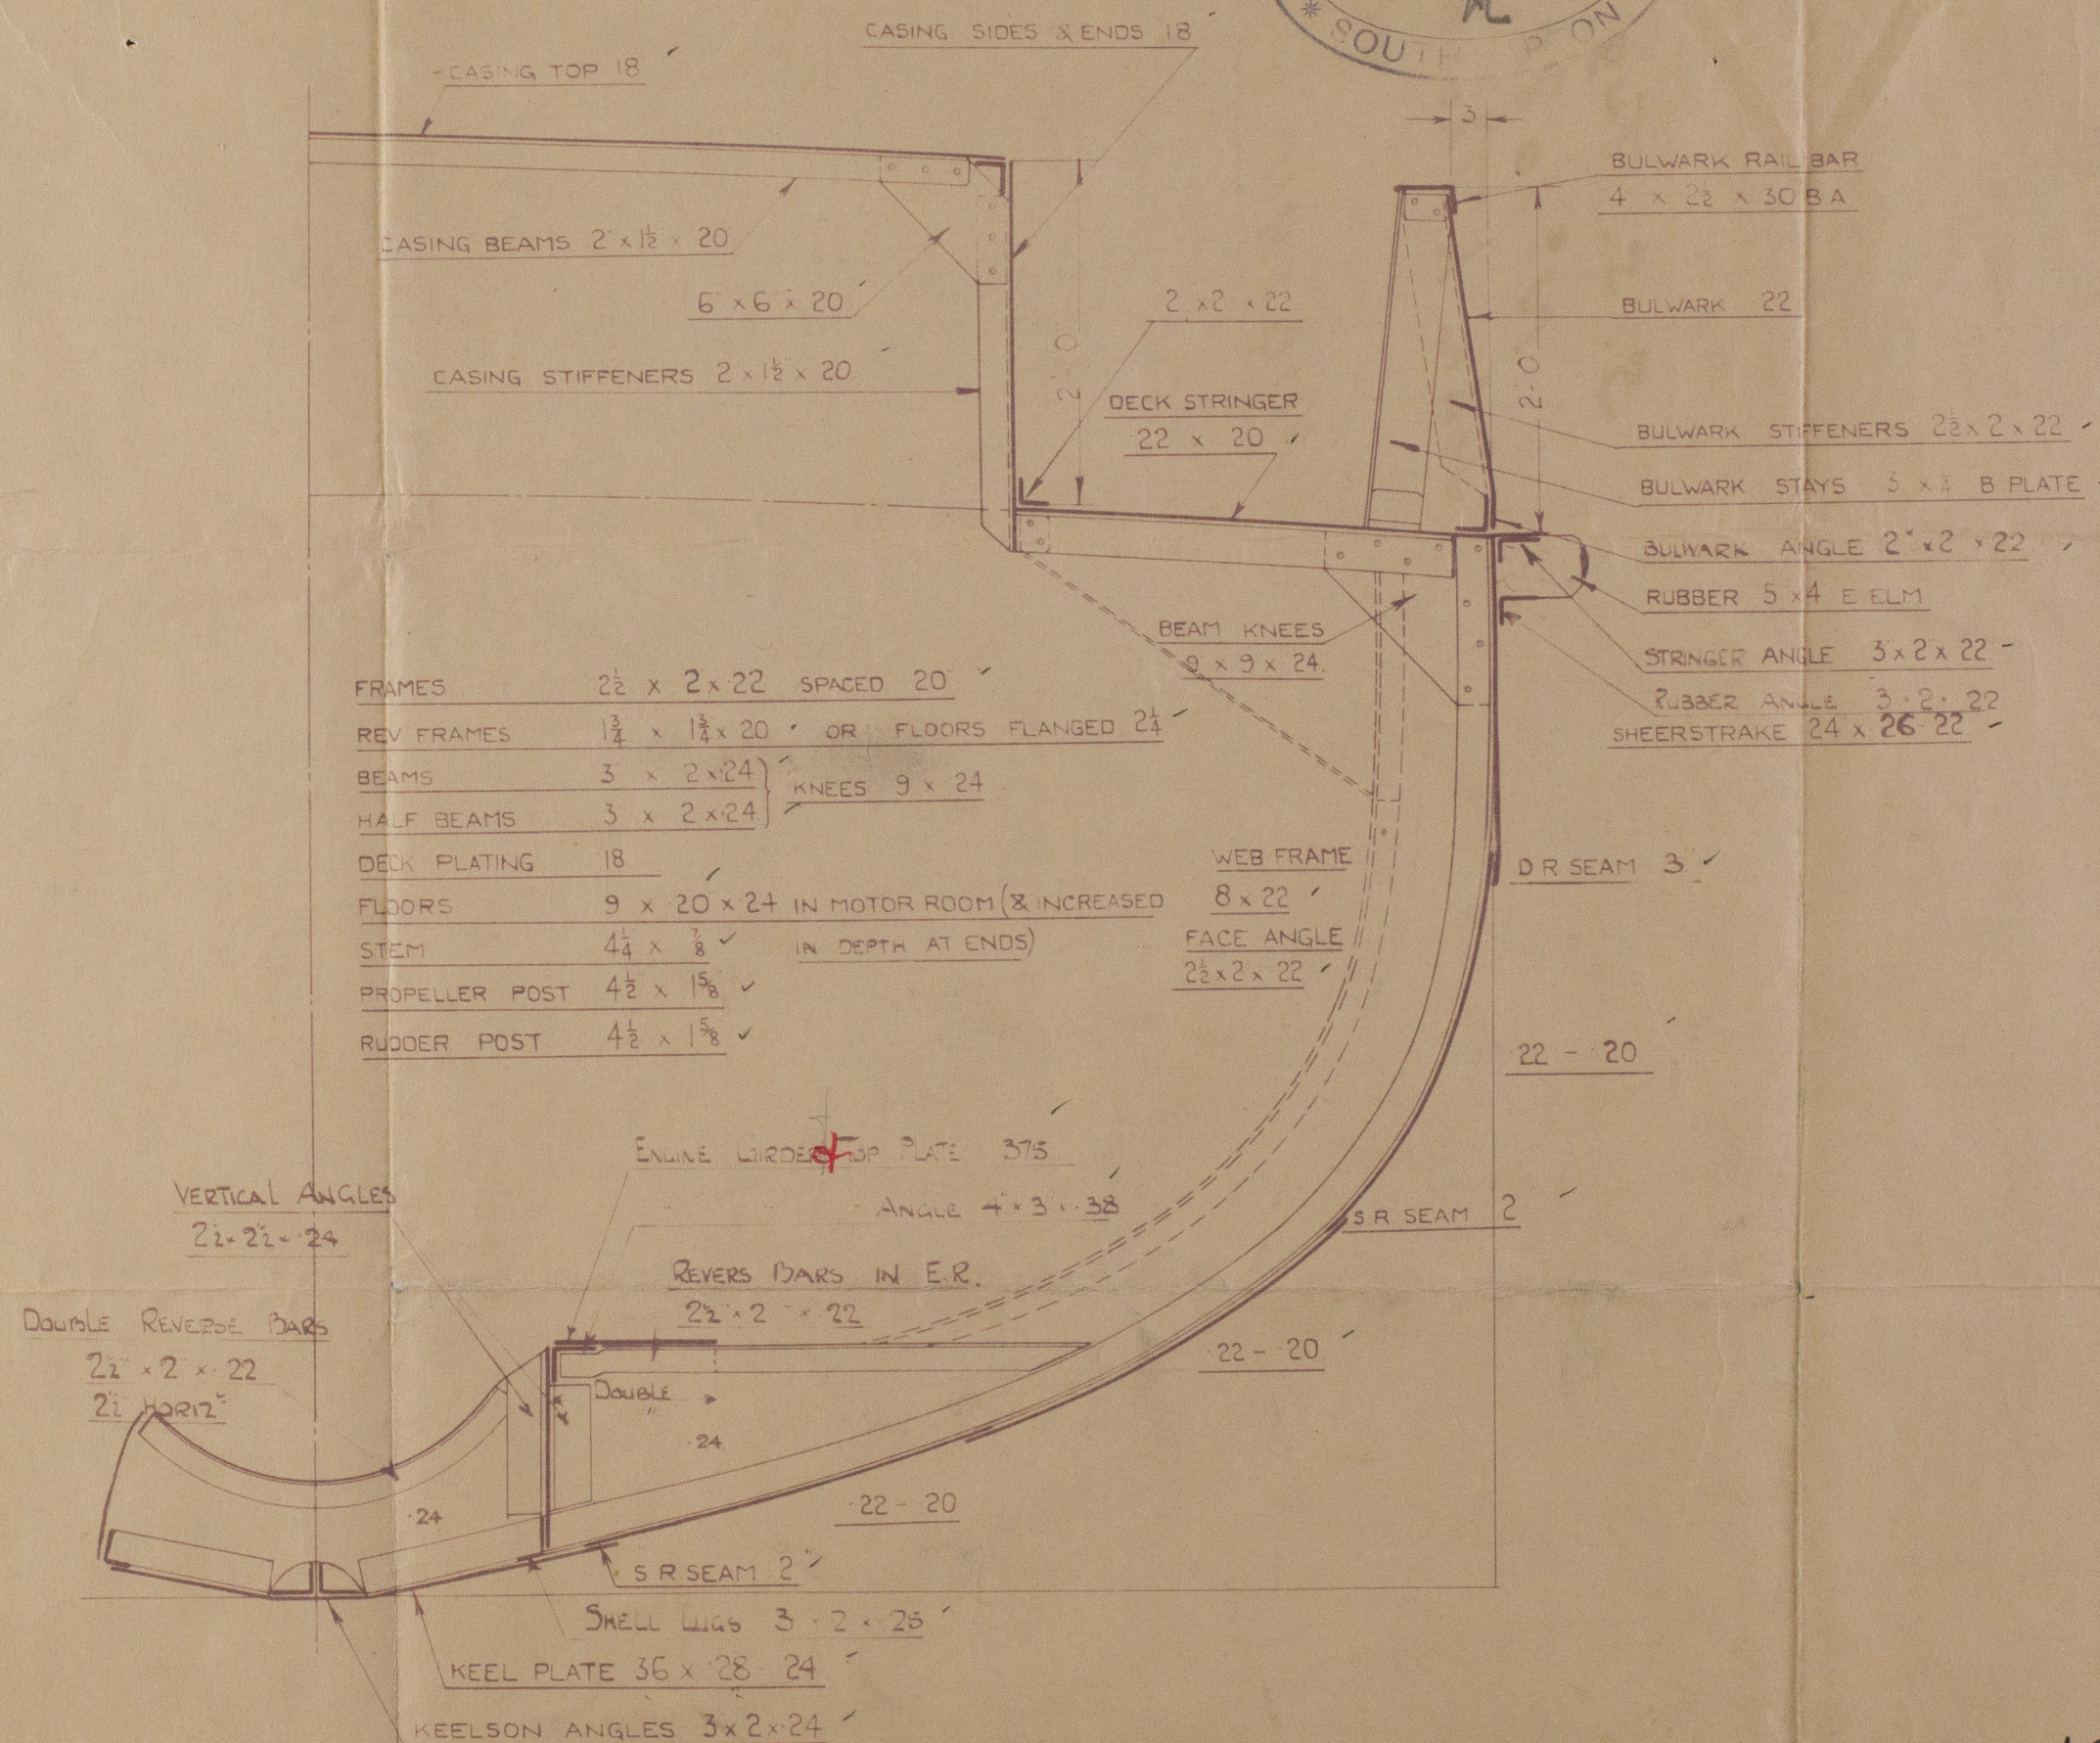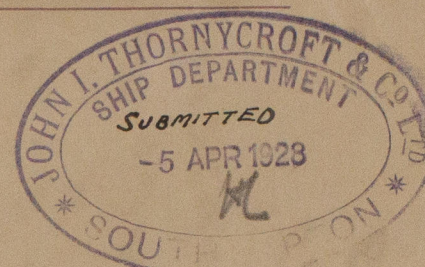

Nº 1082.

W.J.
11.4.28
235/28.



© 2020

Lloyd's Register
Foundation

W1233-0201

"PA TO REAL"

S. S. Tug.

Nº 1082.

John I. Thornycroft
& Co. Ltd.

MIDSHIP SECTION.

2nd Submission.

App. Plan.
11/4/28.

W1233-0201



© 2020

Lloyd's Register
Foundation