
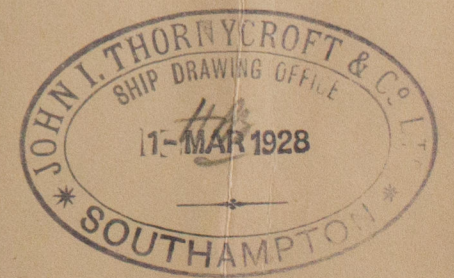
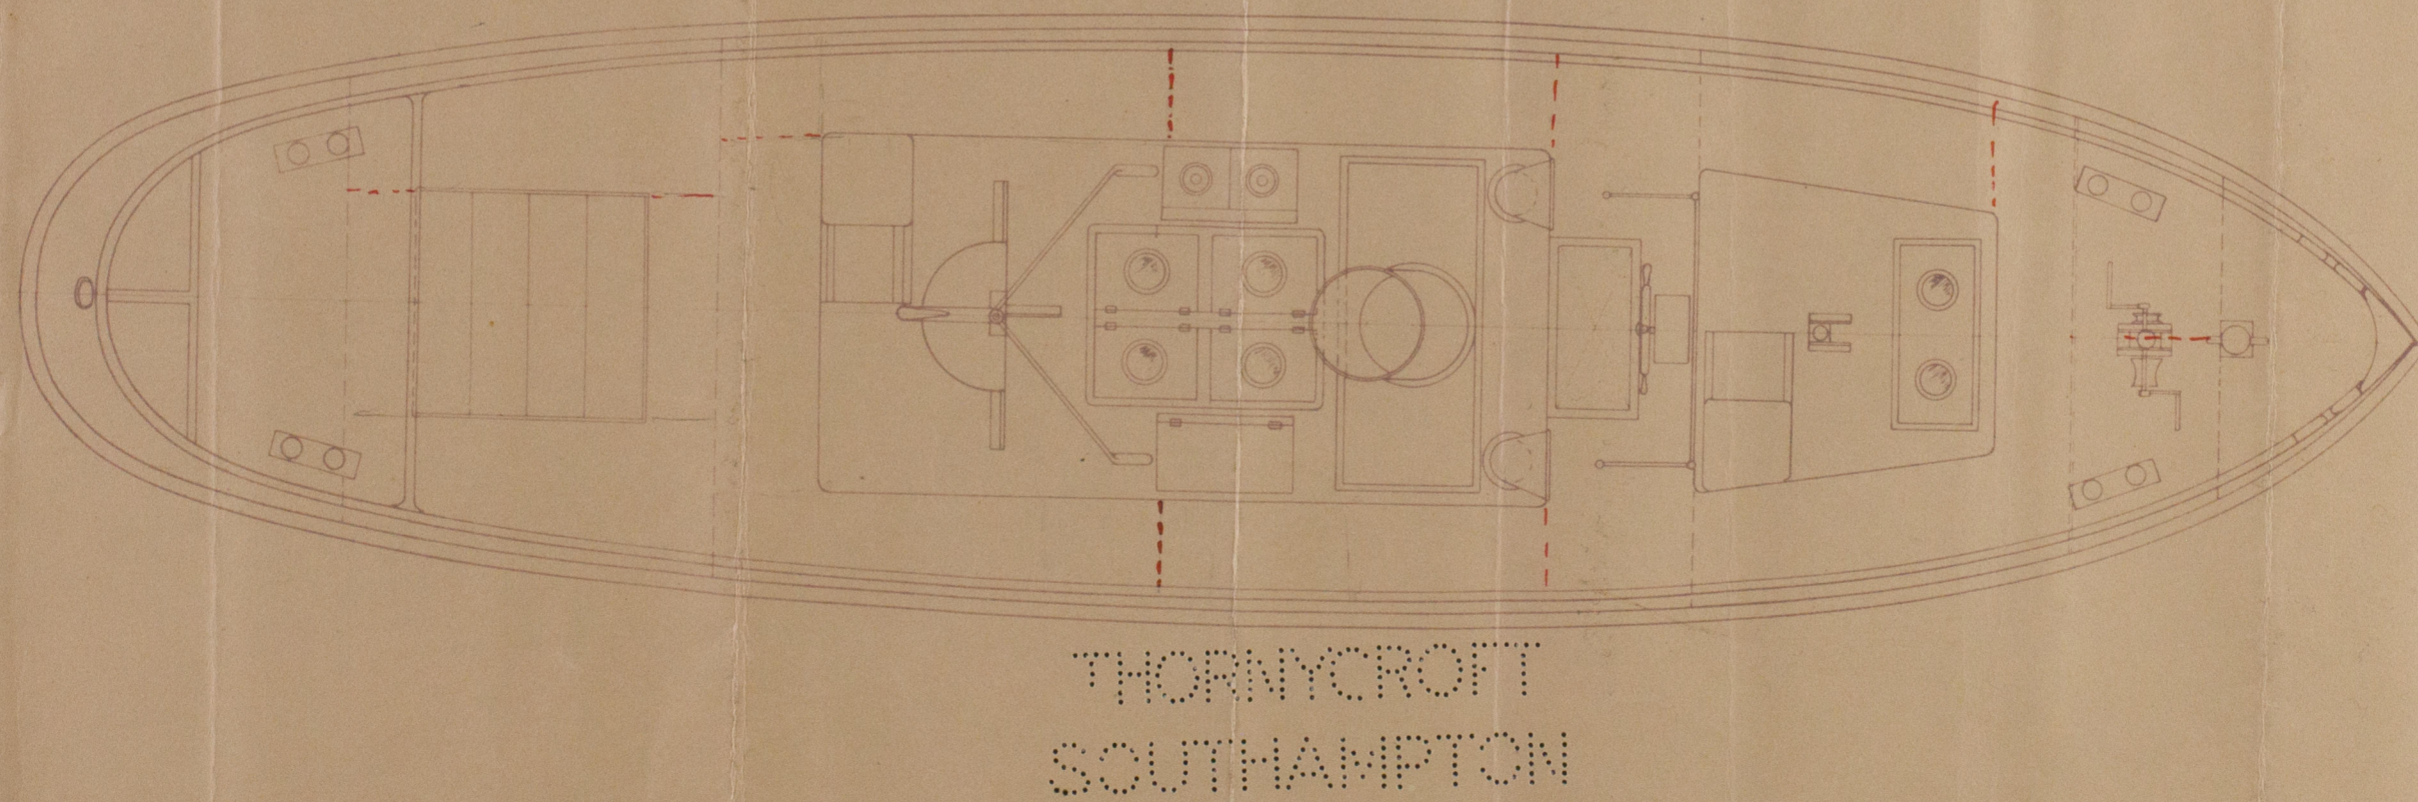


PROPOSED SINGLE SCREW MOTOR TUG.

LENGTH O.A.	54'-0"
BREADTH M ^L D	13'-0"
DEPTH M ^L D	6'-0"
DRAFT (EXTREME)	5'-6"
SPEED (RUNNING FREE)	8½ KNOTS

SCALE ¼" = 1 FOOT.

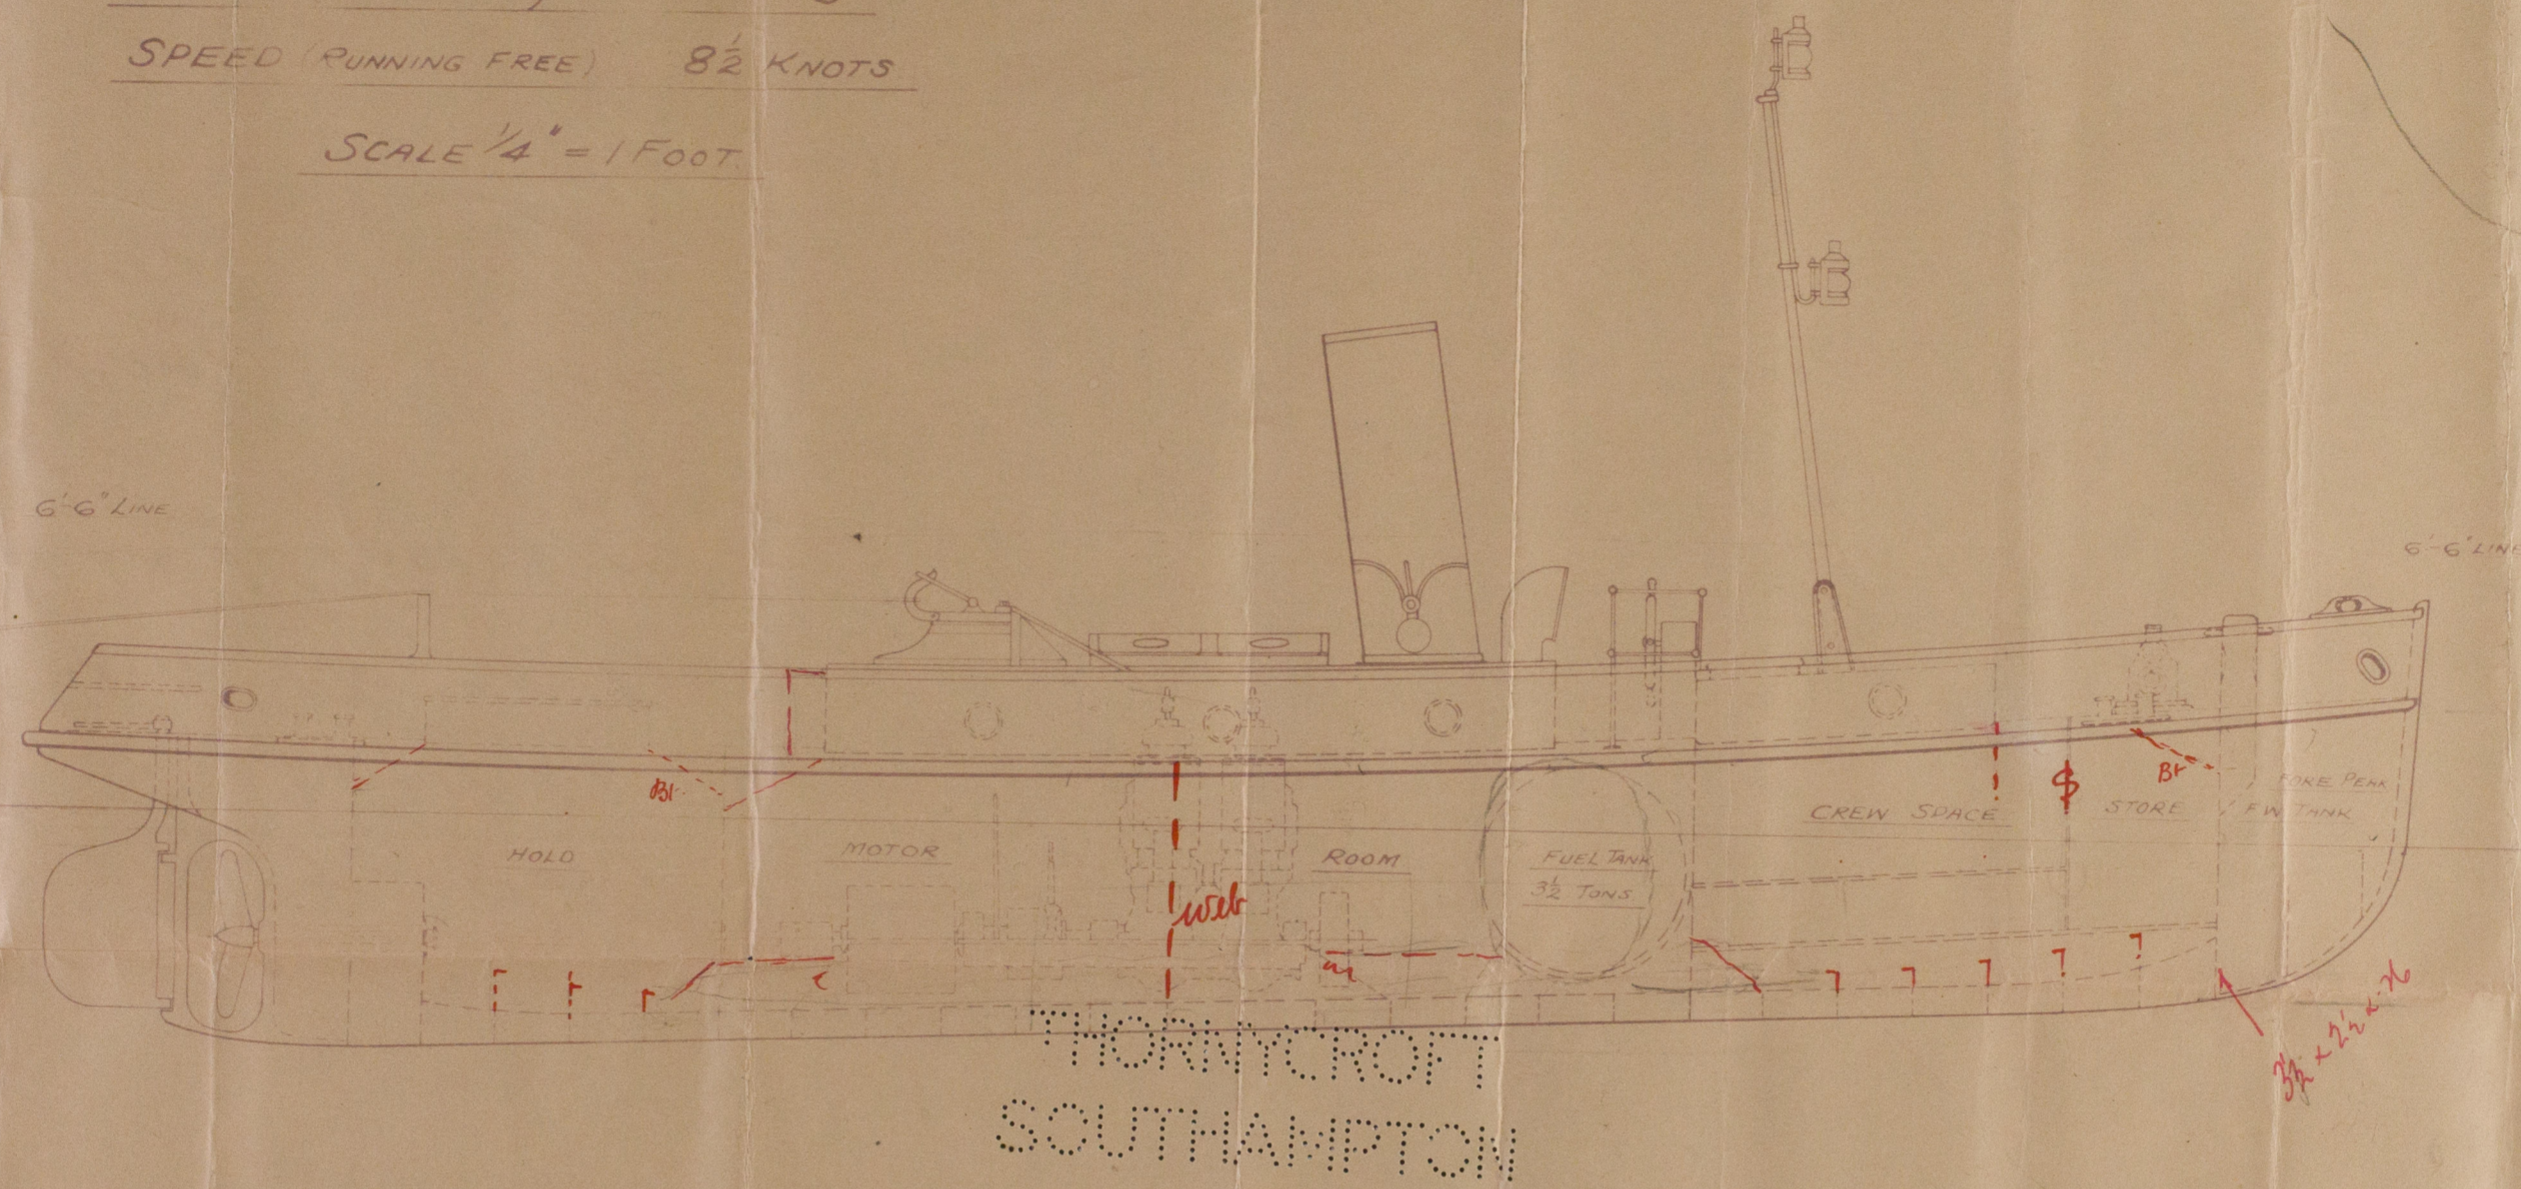

W.S.
2.3.28

143/28.

"PATO REAL."

Nº 1082

S.S. MOTOR TUG.

John I. Thornycroft
& Co. Ld.

PROFILE & DECK

Arrg^t.

Appd. plan
3/2/28.

W1233 - 0203



© 2020

Lloyd's Register
Foundation