

Lloyd's Register of Shipping.

(Report on Vessel No. 528 Port First Entry Report "19.")

No. 241 SHIP FORGINGS OR CASTINGS.

I have to report that the undermentioned Iron or ~~Steel~~ Forgings or Castings, manufactured by The De Laney Forge & Iron Co of Buffalo, N. Y. for the Vessel No. 528, being built by The American Shipbuilding Co of Superior have been inspected by me as set forth below and found to be, so far as can be seen, sound

16-5-17 1 Stern Frame

Mark on Forgings or Castings.

Lloyd's

No. 241

11-5-17


FWT

J W Weddell

Buffalo N.Y.

	STERN FRAME.	RUDDER FRAME.	STEM.
Material* ...	Scrap Iron		
How made ...	Forged & machined		
Dimensions ...	As per plan		
Progress on Inspection ...	Finished		
Date when Inspected	11 th May 1914		
CASTINGS.			
Tests on Standard Test Pieces.			
Tensile Test—			
Tons per square inch ...			
Extension per cent. ...			
Cold Bending Test—			
Angle before fracture ...			
Drop Test—			
Height from ground ...			
Hammering Test—			
If made according to Rules and found satisfactory ...			

SKETCHES OF FRAMES SHOWING POSITION AND DESCRIPTION OF WELDS OF FORGINGS.

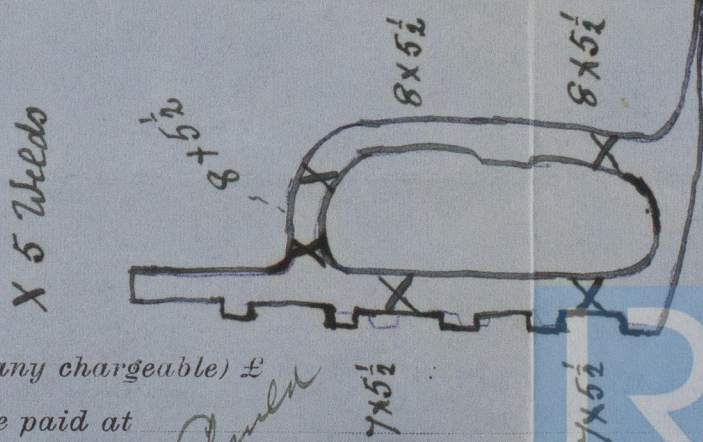

Fee (if any chargeable) £

To be paid at

* If of Iron, state whether scrap or puddled Iron. If of steel, state whether made on the Open Hearth process.