

over 1 month  
 .02 - p. 12 covl  
 000, 142 m.  
 water 6 gills bill

27.9.12  
 30.10.12

NO. 1988  
 Messrs Lloyds Surveyors  
 Hull  
 COCHRANE & SONS  
 20/9/12. RK

# MIDSHIP SECTION


STEEL SCREW TRAWLERS

N<sup>os</sup> 549-50 548-500

DIMS. LEN 133'-4" x 23'-0" B x 13'-1" MLD  
 SCALE 1/2" = 1 FOOT

Steam Trawler.  
 TO CLASS 100A.1 AT LLOYDS FOR FISHING PURPOSES. ENGINE  
 & BOILER CASING AS PREVIOUSLY APPROVED. DECK  
 PLATED OVER IN WAY OF ENGINE & BOILER CASING.

PLAN No. 2680  
 FOR ENCLOSURE TO  
 Messrs Lloyds Surveyors  
 Hull FROM  
 COCHRANE & SONS, LTD.  
 SHIPBUILDERS, BELBY  
 DATE 20/9/12 RK

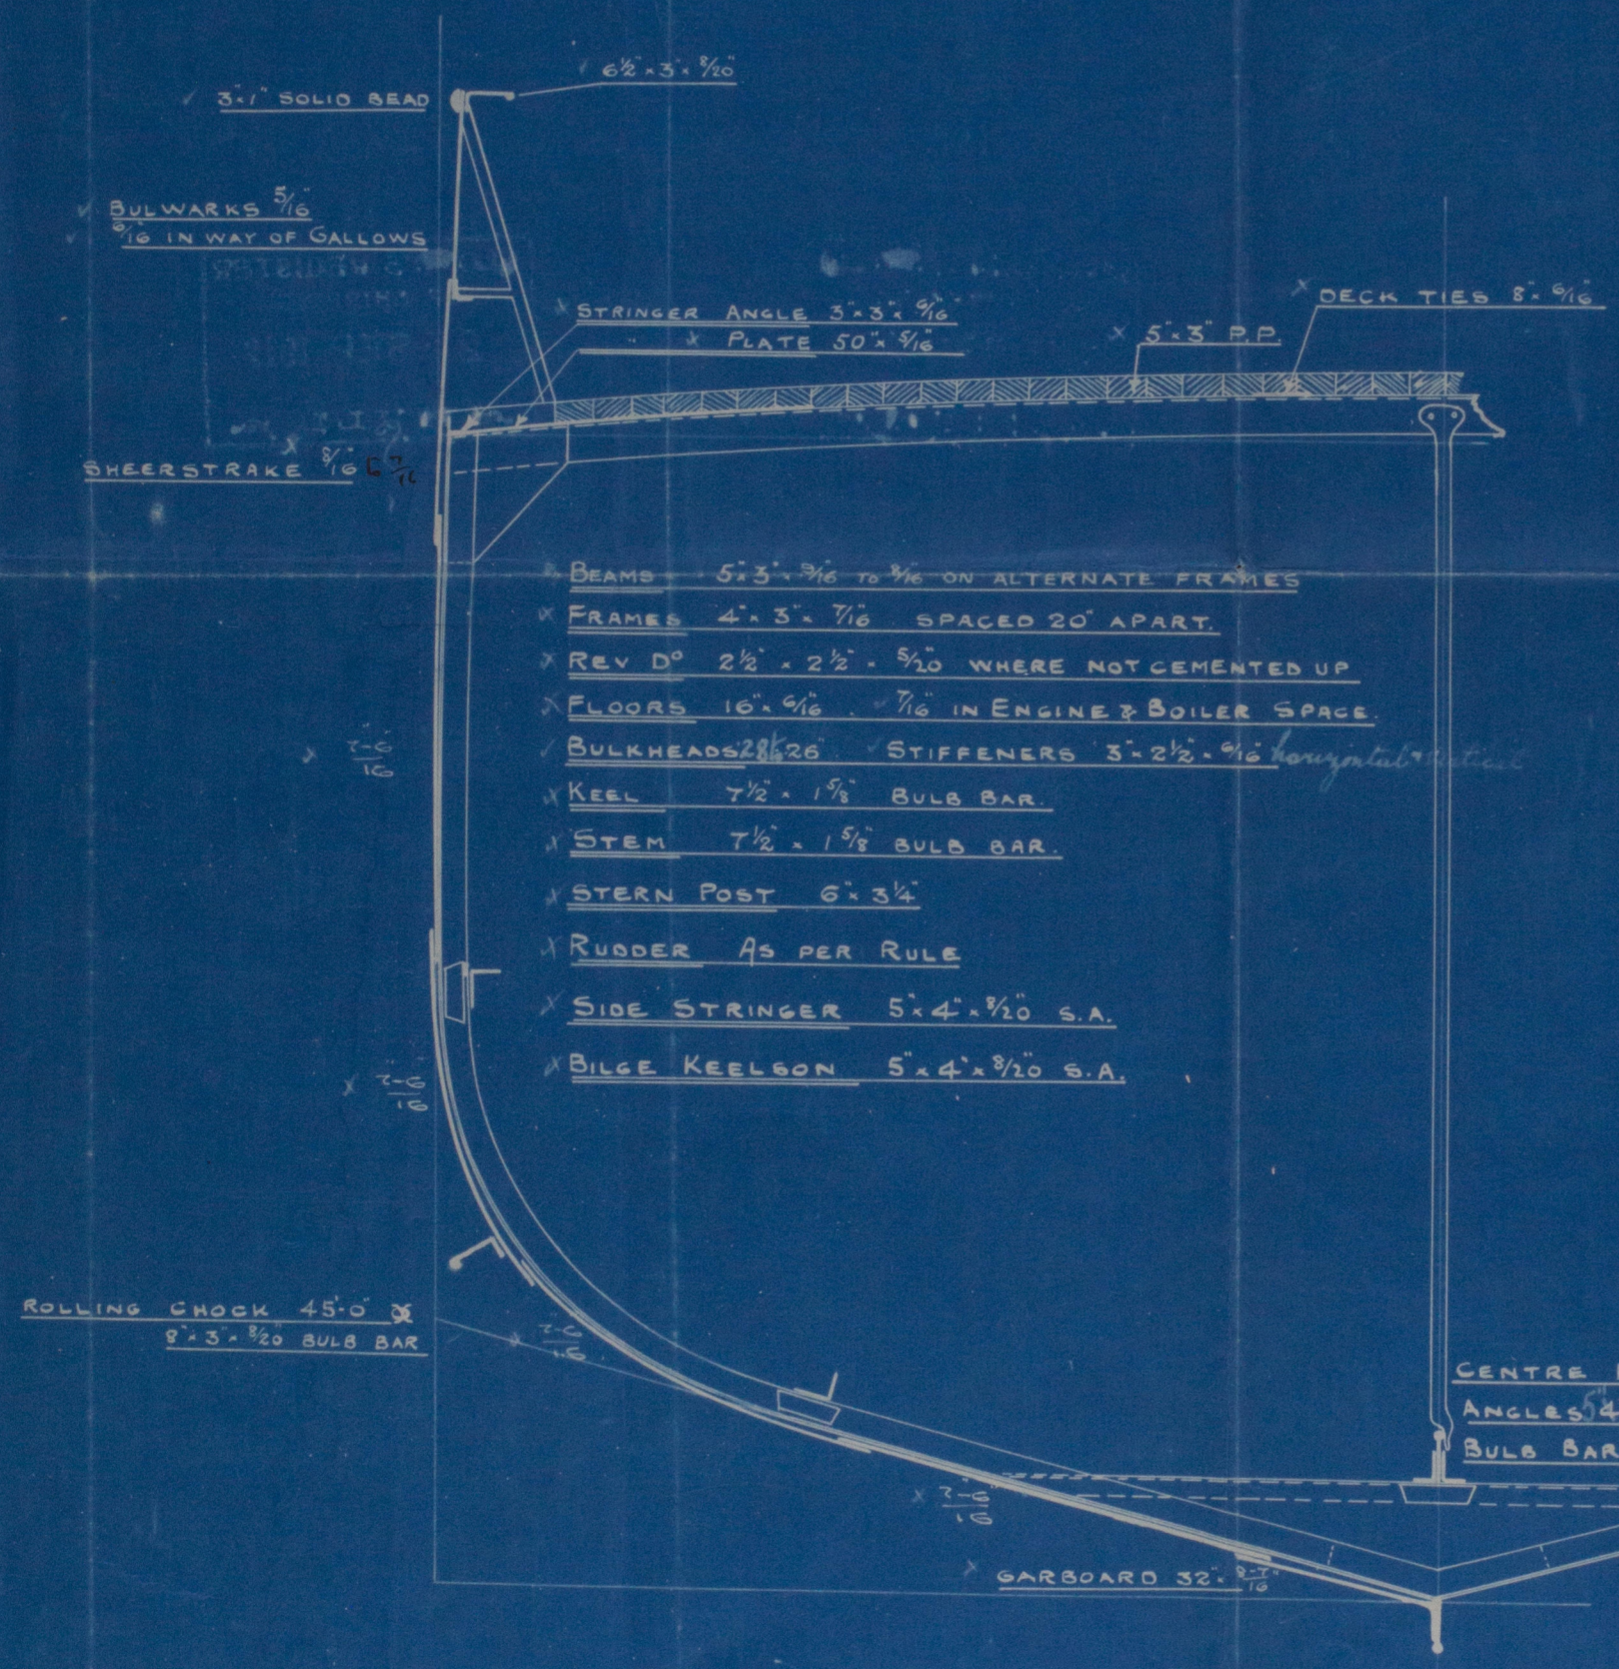

## NUMERALS

B+D = 35.95 ✓  
 L(B+D) = 4793.21 ✓

## PROPORTIONS

1/10" = 10.19  
 1/16" = 5.79

## EQUIPMENT

1st BOWER ANCHOR 6 CWTs EX STOCK  
 2nd " " 5 1/2 " " "  
 KEDGE ANCHOR 3 " " "  
 120 FATHOMS 1 1/4" CABLE  
 60 " 6" HAWSER  
 60 " 5" WARP

## RIVETING

BUTTS OF SHELL PLATING LAPPED & DOUBLE  
 RIVETED EXCEPT GARBOARD & SHEERSTRAKE  
 WHICH ARE TO BE STRAPPED & DOUBLE  
 RIVETED. LANDINGS DOUBLE RIVETED BULWARKS  
 SINGLE RIVETED

C.B.  
 27.9.12



W1238-C045

Cochrane + Dous. 2d.  
Nos 549, 550, 548, 560.

Copy of.  
Midship Section.

• Venator Hull Report No: 25993.

• Tribune " " "

• Notes " " "

RETAIN

W1238-0085



© 2020

Lloyd's Register  
Foundation