

Arch. A. L. Jones **Nº 152**

WORKING PRESSURE 185 <sup>LIBS</sup> PER SQ. INCH

SCALE 1 INCH = 1 FOOT.



Lloyd's Registered  
Foundation





"CEYLON MARU"

MITSU BISHI, N° 152.

MAIN BOILER.

*hag. 302*

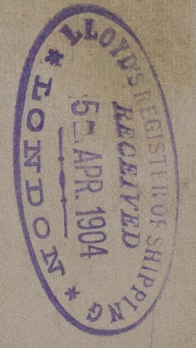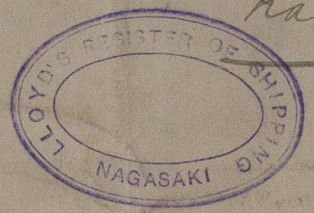

*10000*

RETAIN 2000 /

*21 J. J. Lloyd's Surveyor.*

W1239-0243

W1239-0243



© 2020

Lloyd's Register Foundation