


20-2-03

Nº 152. PROFILE & DECK PLAN. SCALE 1/8" TO ONE FOOT

initials
221 AP
1/10/09
made
202 p. 1




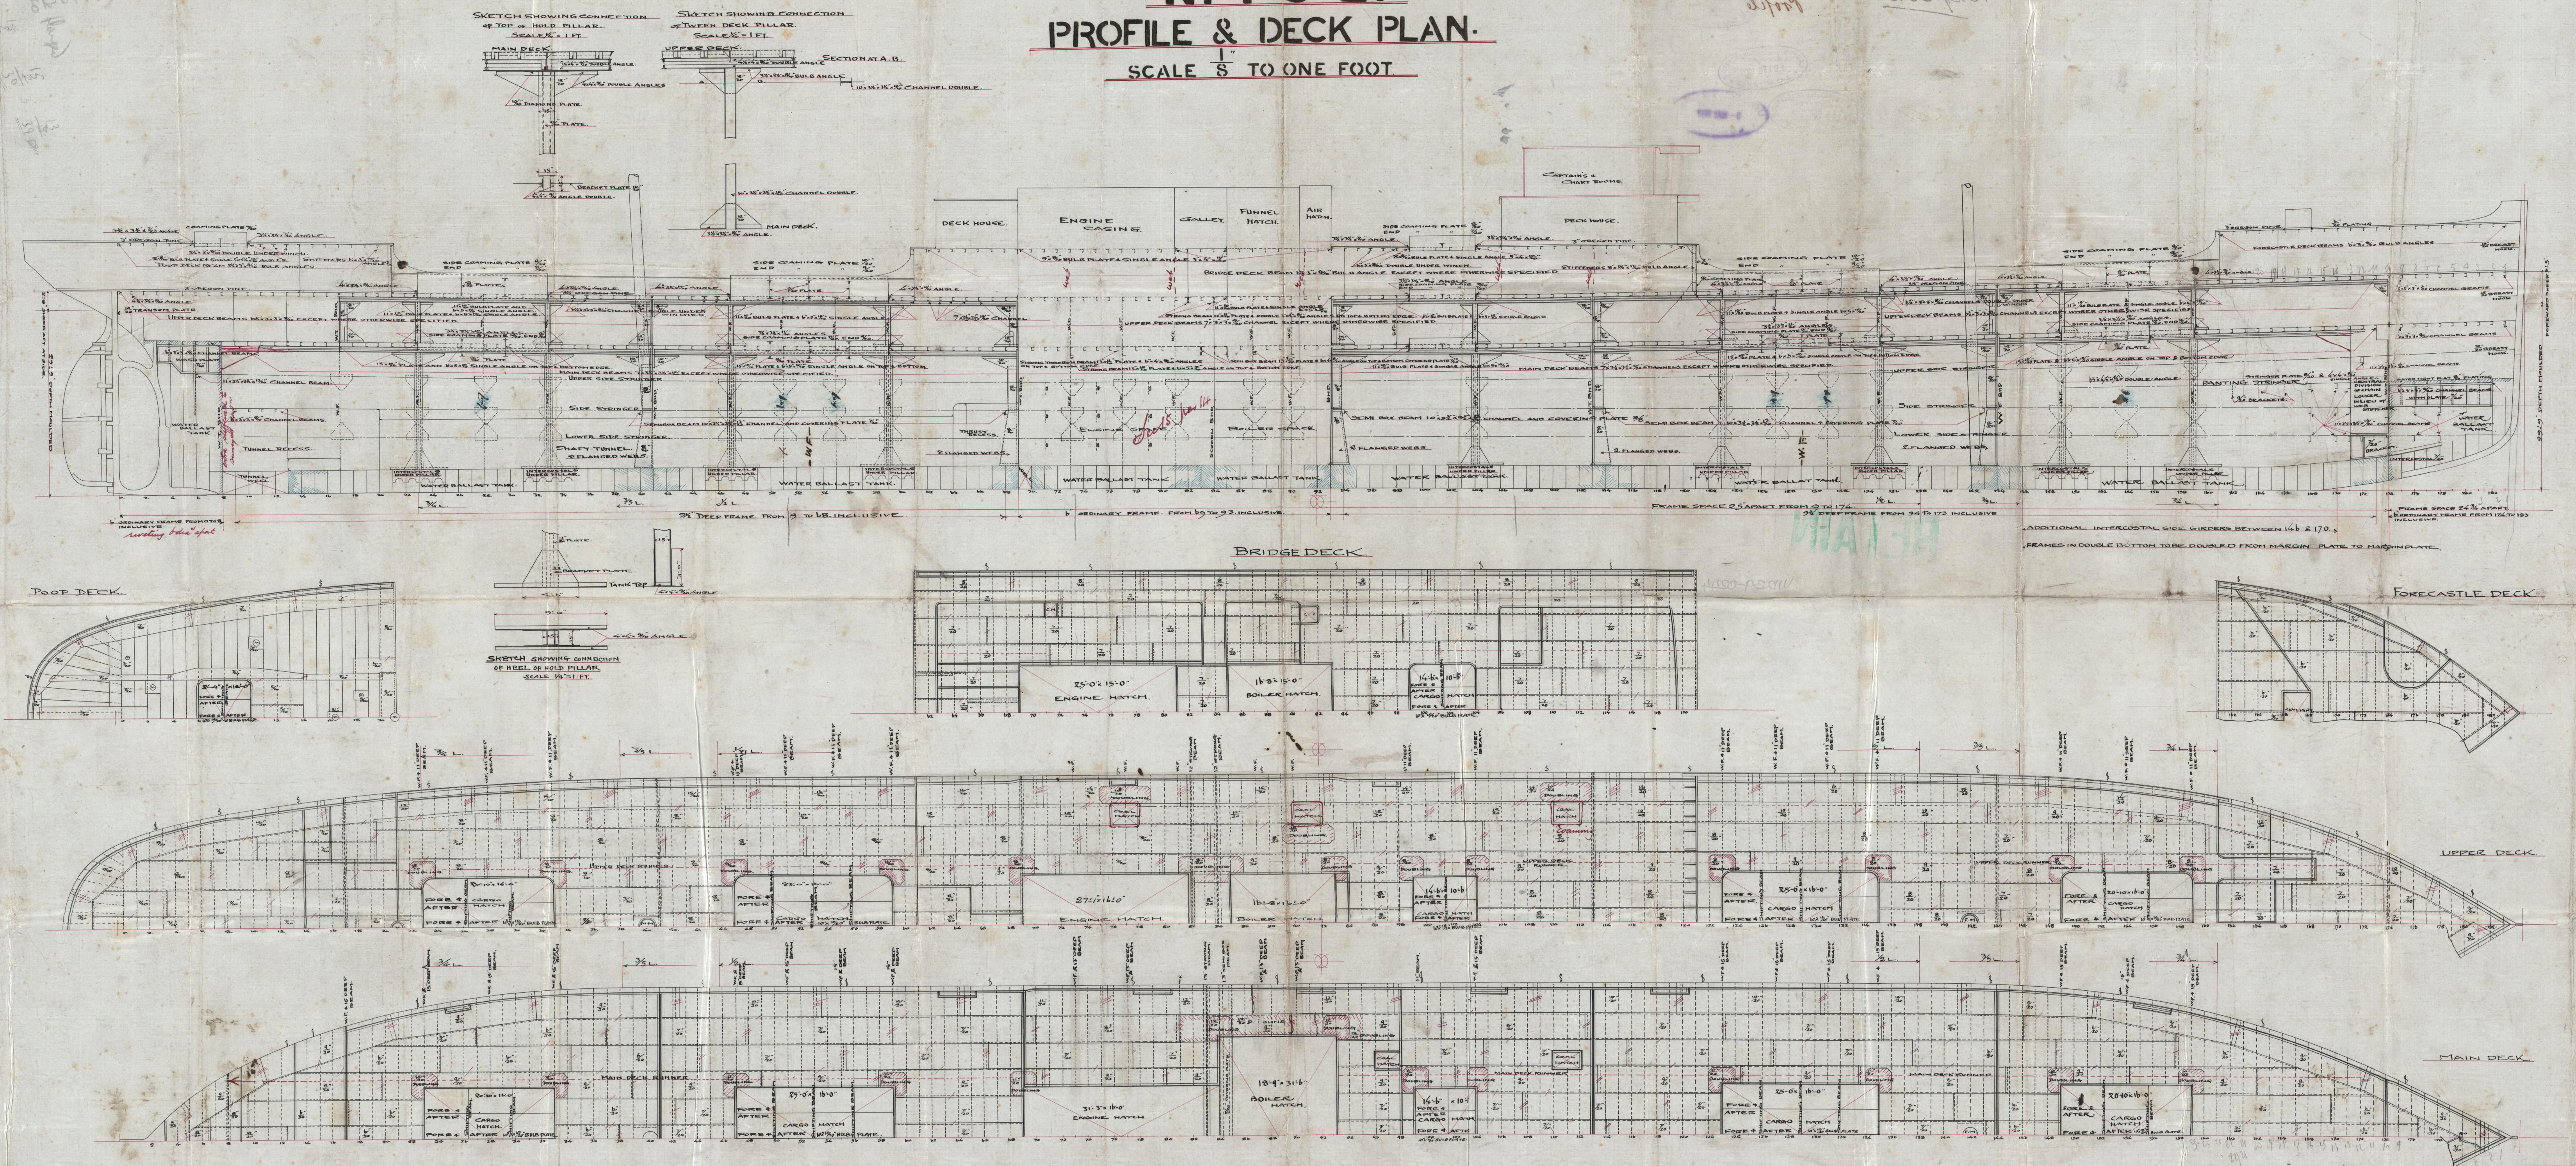


10x1, 4x12

19-2-13

S. Ceylon Maru
No 302

Mil'm Bishi
No 152
Profile

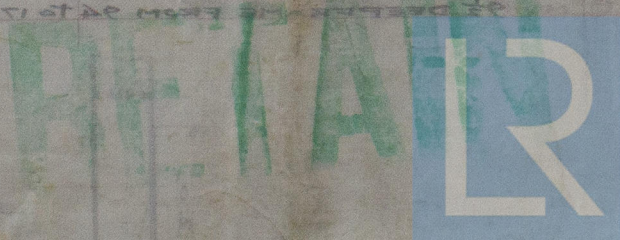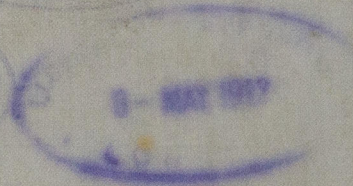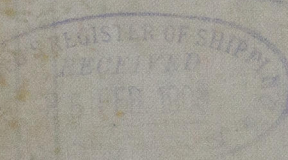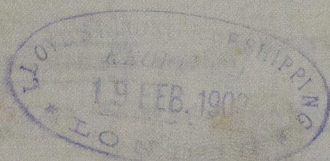

© 2020

Lloyd's Register
Foundation

W1239-0244